



ONE REQ'D ~ Mk. M31A U2'-U3'

LIFTING WEIGHT ? lbs

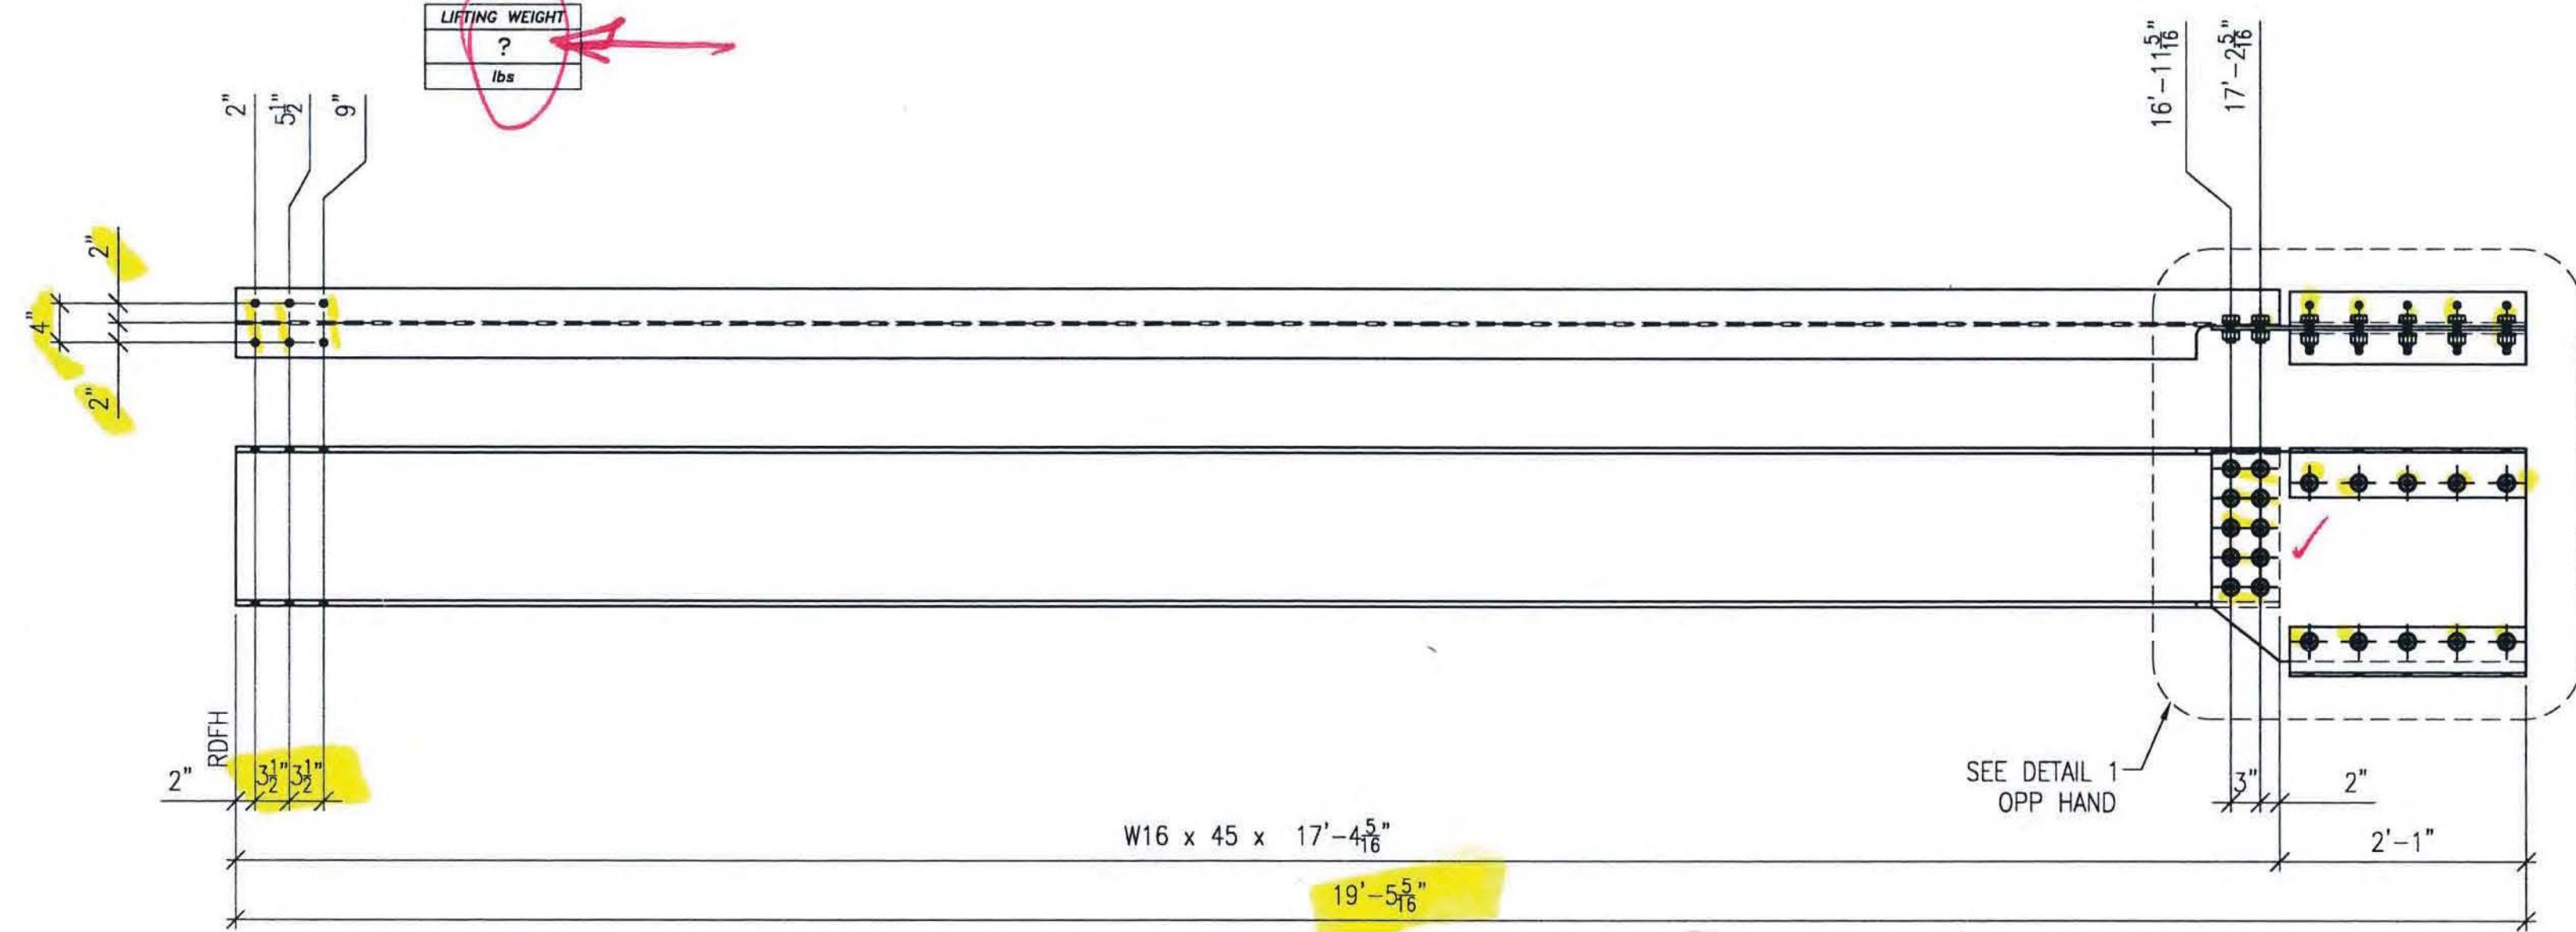

ONE REQ'D ~ Mk. M31B U15'-U16'

LIFTING WEIGHT ? lbs

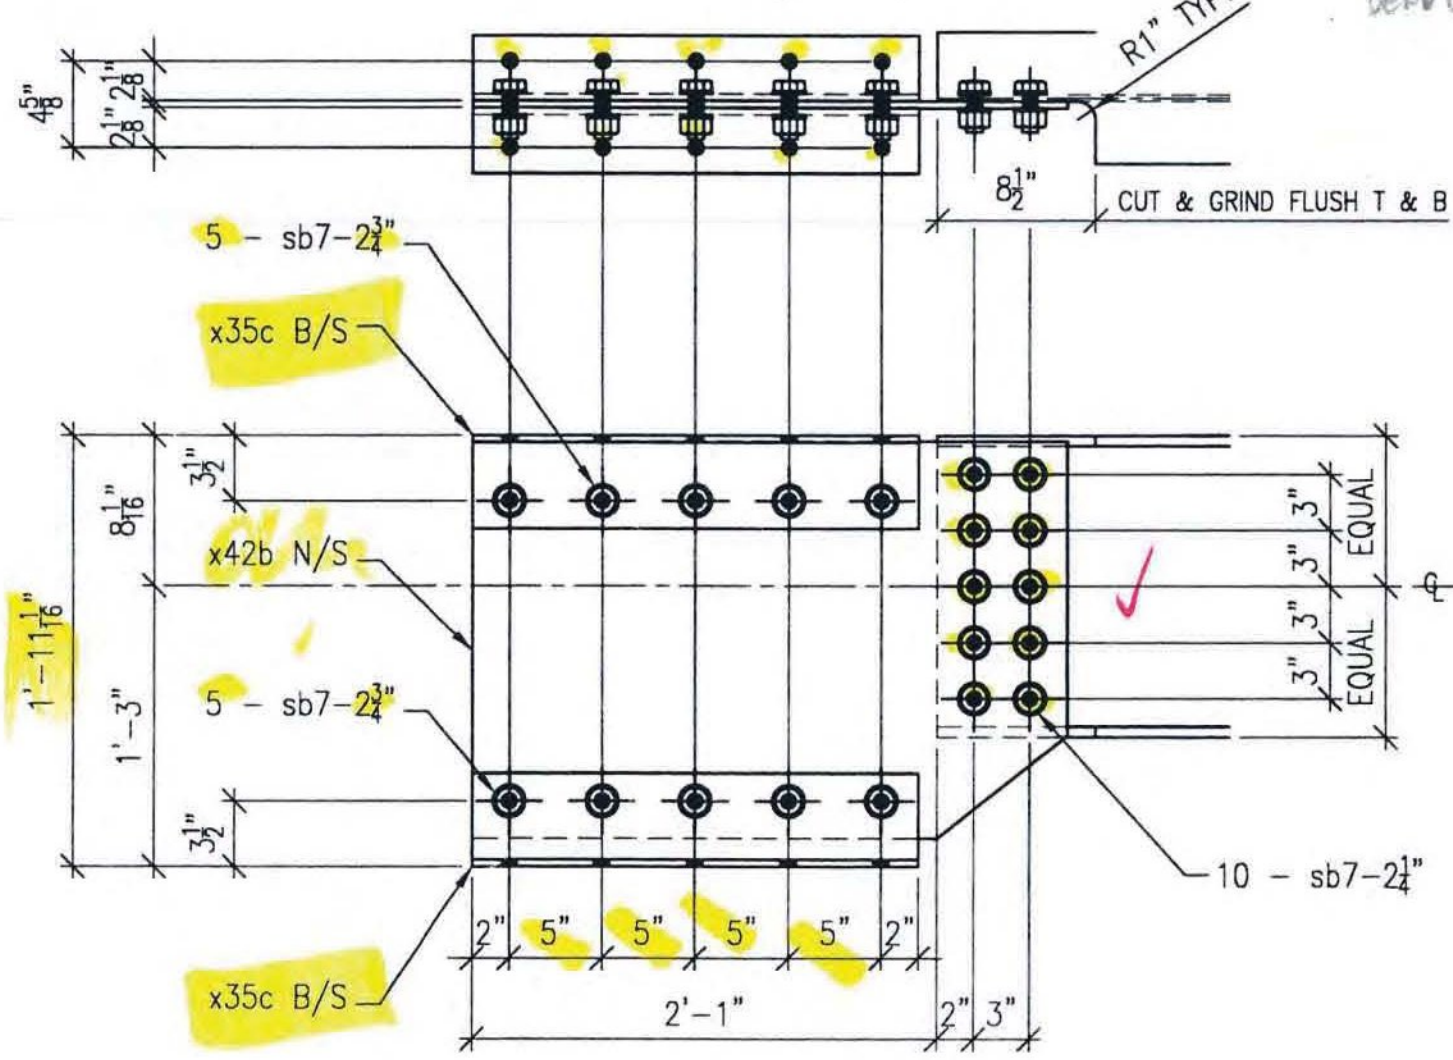

OVER ALL DEPTH OF TRUSS 1'-1 1/8\"/>

- NO EXCEPTION TAKEN
- REJECTED
- MAKE CORRECTIONS NOTED
- REVISE AND RESUBMIT
- SUBMIT SPECIFIED ITEM

CHECKING IS ONLY FOR GENERAL CONFORMANCE WITH THE DESIGN CONCEPT OF THE PROJECT AND GENERAL COMPLIANCE WITH THE INFORMATION GIVEN IN THE CONTRACT DOCUMENTS. ANY ACTION SHOWN IS SUBJECT TO THE REQUIREMENTS OF THE PLANS AND SPECIFICATIONS. CONTRACTOR IS RESPONSIBLE FOR DIMENSIONS WHICH SHALL BE CONFIRMED AND CORRELATED AT THE JOB SITE; FABRICATION PROCESSES AND TECHNIQUES OF CONSTRUCTION; COORDINATION OF HIS WORK WITH THAT OF ALL OTHER TRADES AND THE SATISFACTORY PERFORMANCE OF THE WORK.

DATE 5/9/12 BY *PKT/dl*

BILL OF MATERIALS												
LINE	SEQ	SHIPPING PICS	ASSEMBLY PICS	MARK	SHAPE	DESCRIPTION	LENGTH		REMARKS	MATERIAL ASTM A709-50 T2 U.N.O.		
							ft	in		MATL GRADE	MATL REMARK	WEIGHT
1												
2	ONE			M31A	W	16 x 45	17	4 5/16				
3	2			x35c	L	5 x 3 1/2 x 3/8	2	0				
4												
5												
6	ONE			x42b	PL	3/8 x 21 1/4	2	8				
7												
8	10			sb7-225	BOLT	7/8 #		2 1/4	Incl/2w	A325		
9	10			sb7-275	BOLT	7/8 #		2 3/4	Incl/2w	A325		
10												
11												
12												
13	ONE			M31B	W	16 x 45	17	4 5/16				
14	2			x35c	L	5 x 3 1/2 x 3/8	2	0				
15												
16	ONE			x42b	PL	3/8 x 21 1/4	2	8				
17												
18	10			sb7-225	BOLT	7/8 #		2 1/4	Incl/2w	A325		
19	10			sb7-275	BOLT	7/8 #		2 3/4	Incl/2w	A325		
20												
21												
22												
23												

ALL HOLES TO BE PUNCHED U.N.O.

*U2-U3
20'-9 3/16 (299 3/16)*

20'-11 1/8

PAINT NOTES:

- ALL ITEMS THIS SHEET TO RECEIVE UPPER STEEL PAINT SYSTEM PER GN1.
- CLEAN AND PRIME BOLTED PARTS PRIOR TO ASSEMBLY.
- PRIMER ONLY, WITHIN 3" FROM ALL OPEN HOLES, (A307) SHIPPING BOLTS AND NUTS OR TO NEAREST EDGE OR PERPENDICULAR SURFACE (WHICHEVER IS LESS) UNLESS SPECIFICALLY NOTED OTHERWISE.
- ALL TORQUED BOLTS TO RECEIVE COMPLETE PAINT SYSTEM NOTED. NO PAINT ON (A307) SHIPPING BOLTS AND NUTS.

NOTES:

- FOR GENERAL NOTES SEE DRAWING GN1.
- ALL BOLTS THIS SHEET TO BE FULLY TORQUED UNLESS NOTED AS (A307) SHIPPING BOLTS.
- INSTALL WASHER UNDER HEAD OF BOLT AS WELL AS NUT. ADDITIONAL WASHER IS NOT REQUIRED FOR (A307) SHIPPING BOLTS.
- ALL HOLES MARKED "X" OR "X" ARE TO BE FIELD DRILLED HOLES. DO NOT SHOP DRILL.

LEGEND:

- ⊕ = CENTERLINE
- CTR'D = CENTERED
- C/C = CENTER TO CENTER
- FLG = FLANGE
- TOP = TOP
- BTM = BOTTOM
- RDFH = RUNNING DIMENSIONS FROM HERE
- = FIELD BOLTS (QUANTITY) DIAMETER x LENGTH
- ⊕ = ALTERNATE HOLE DIAMETER
- TYP = TYPICAL
- N/S = NEAR SIDE
- F/S = FAR SIDE
- B/S = BOTH SIDES
- BTS = BOLT TO SHIP
- SHPP'G BOLT = SHIPPING BOLT
- ⊕ = SHIPPING BOLT
- D.O.R. = DIRECTION OF ROLL
- T2 = CHARPY V-NOTCH TESTING REQUIRED
- FZ = FRACTURE CRITICAL MATERIAL
- ⊕ = FIELD DRILLED HOLE
- ⊕ = FIELD DRILLED HOLE

ALL DIMENSIONS HAVE BEEN FIELD VERIFIED BY: _____ DATE: _____

FOR APPROVAL			
NO.	DATE	BY	REVISION
A	04/20/12	RC	
STS STEEL, INC. ENGINEERS * FABRICATORS * ERECTORS PH: (518) 370-2693 FAX: (518) 370-2696			
DRAWING TITLE			
UPPER STEEL (U2-U3 & U15-U16)			
PROJECT No. US RT 2 BRIDGE No 24 FEDERAL AID No.			
ENGINEER: CHA			
CUSTOMER: Harrison & Burrowes Bridge Constructors, Inc.			
PROJECT: RICHMOND, VT - TRUSS BRIDGE REHAB			
RICHMOND, VT			
HOLES:	15/16" U.N.O.	PAINT:	PER SPEC
BOLTS:	A325 U.N.O.	DR.BY:	RC
WELDS:	AWS D1.5	CHEK.BY:	SG
		DATE:	03/16/12
		JOB NO.	1156
		DWG NO.	31