


TEMPORARY AND DURABLE 100 mm YELLOW LINE  
 STA. 10+400.0 TO 11+100.0, SOLID LT. & RT.  
 (WITH CENTERLINE BREAK FOR ALLEN MARTIN DR.)

TEMPORARY AND DURABLE 100 mm WHITE LINE  
 STA. 10+400.0 TO 11+100.0, SOLID LT. & RT.  
 (WITH EDGELINE BREAK FOR ALLEN MARTIN DR.)  
 STA. 10+400.0 TO 10+447.0, DOTTED RT. (LANE LINE)

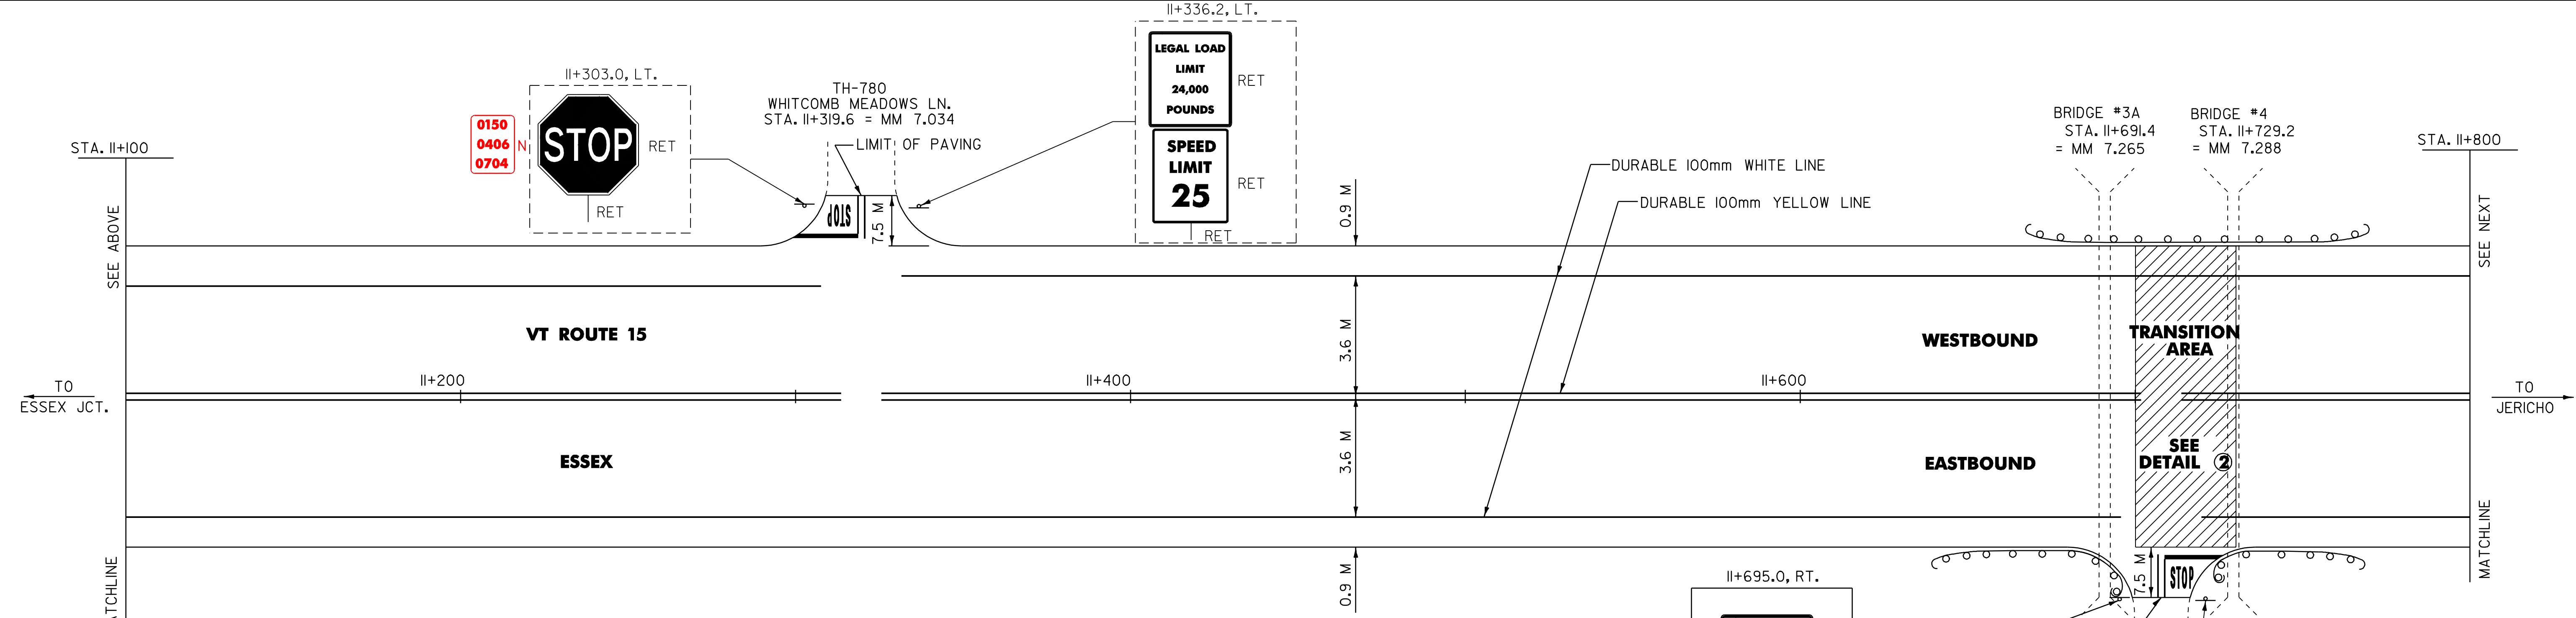

TEMPORARY AND DURABLE 100 mm YELLOW LINE  
 STA. 11+100.0 TO 11+800.0, SOLID LT. & RT.  
 (WITH CENTERLINE BREAKS FOR WHITCOMB MEADOWS LN.  
 AND SAXON HILL RD.)  
 STA. 11+319.6, DOUBLE SOLID LT. (WHITCOMB MEADOWS LN.)  
 STA. 11+707.8, DOUBLE SOLID LT. (SAXON HILL RD.)


TEMPORARY AND DURABLE 100 mm WHITE LINE  
 STA. 11+100.0 TO 11+800.0, SOLID LT. & RT.  
 (WITH EDGELINE BREAKS FOR WHITCOMB  
 MEADOWS LN. AND SAXON HILL RD.)

REMOVAL AND DISPOSAL OF GUARD RAIL  
 639.0 STA. 11+654.5 TO 11+703.9, RT. 703.0  
 STA. 11+671.2 TO 11+754.8, LT.  
 711.0 STA. 11+711.6 TO 11+753.4, RT. 768.0

TEMPORARY AND DURABLE LETTER OR SYMBOL  
 STA. 11+319.6, LT. - "STOP"  
 STA. 11+707.8, RT. - "STOP"

DURABLE 600 mm STOP BAR  
 STA. 11+319.6, LT.  
 STA. 11+707.8, RT.

STEEL BEAM GUARD RAIL  
 639.0 STA. 11+650.7 TO 11+703.9, RT. 703.0  
 656.0 STA. 11+667.4 TO 11+758.6, LT. 770.0  
 711.0 STA. 11+711.6 TO 11+757.2, RT. 768.0

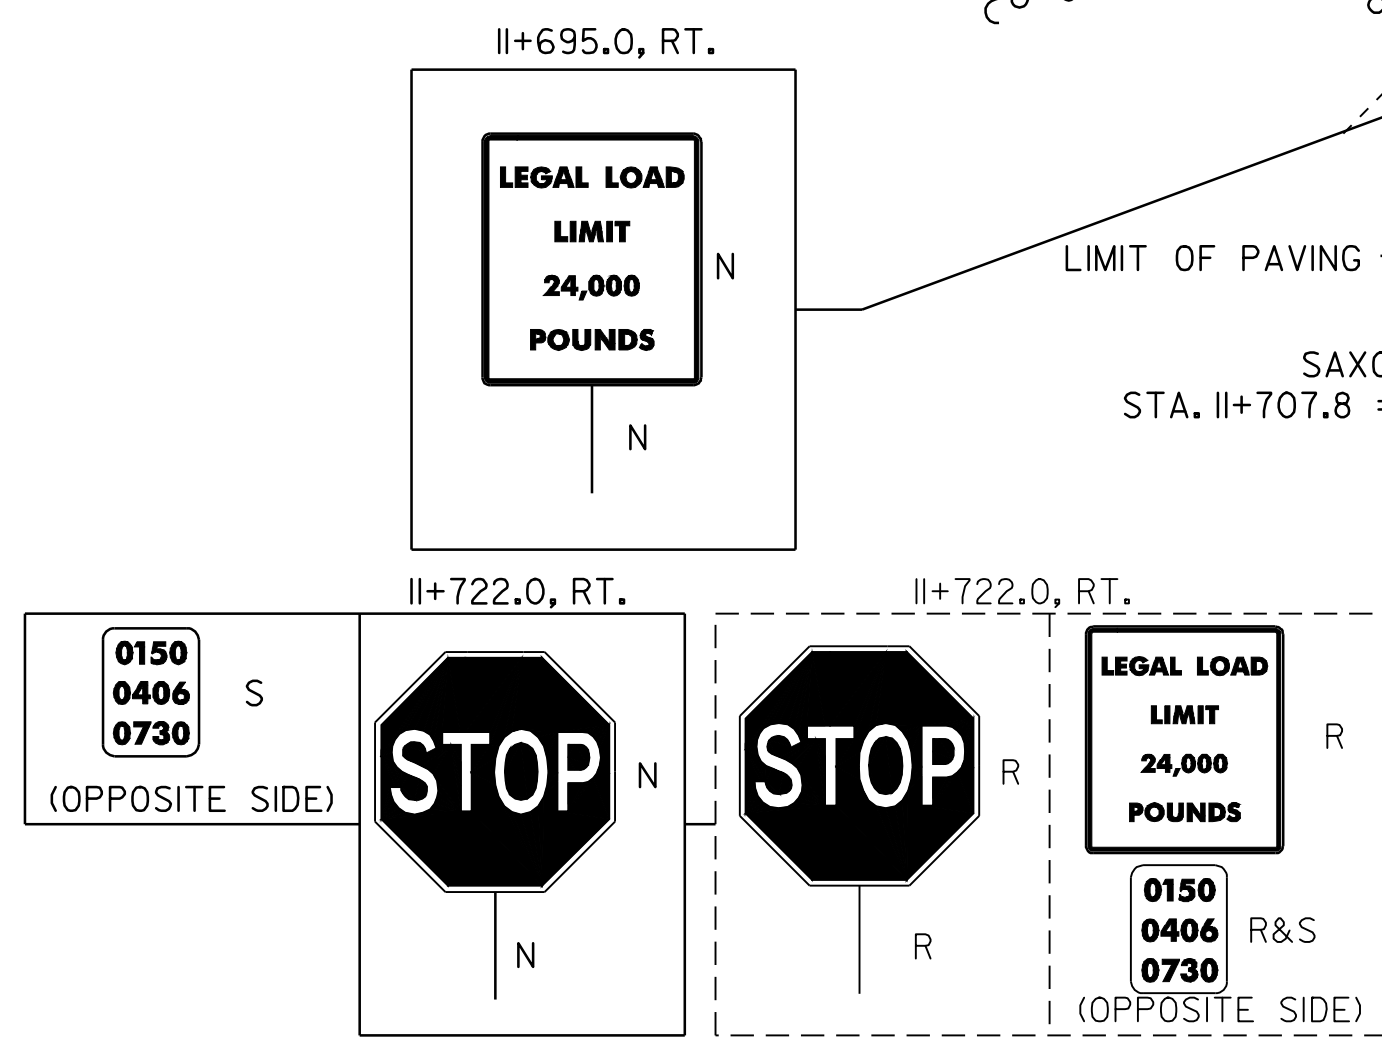

**ARCHIVED  
IN DPR**

NOTE: ALL DIMENSIONS IN MILLIMETERS  
EXCEPT WHERE OTHERWISE INDICATED

DATUM	
VERTICAL	N/A
HORIZONTAL	N/A

REMOVING SIGNS  
AS SHOWN - 3

ERECTING SALVAGED SIGNS  
AS SHOWN - 1

MODIFIED ECCENTRIC LOADER TERMINAL  
 STA. 11+639.3, RT.  
 STA. 11+656.0, LT.  
 STA. 11+757.2, RT. 768.0  
 STA. 11+758.6, LT. 770.0

ANCHOR FOR STEEL BEAM GUARD RAIL  
 STA. 11+703.9, RT. (2)  
 STA. 11+711.6, RT. (2)

NOTES: 1) FOR ANY TOWN HIGHWAY OR STREET  
DETAILS, SEE VAOT STANDARD E-193.  
2) ALL EXISTING SIGNS NOT SHOWN SHALL  
BE RETAINED AS DIRECTED BY THE  
RESIDENT ENGINEER.

**PAVING  
PROJECT  
LAYOUT #3**

SURVEYED BY	W-M	DATE	12/95
DESIGN BY	JLL/GAE	DATE	11/96
DRAWN BY	W-M	DATE	11/96
DESIGN FILE NO.	/pave/92b221/pb221.dgn		
IPARM FILE	pb221i03.1	DATE	11/96
PROJ. NAME	ESSEX-UNDERHILL		
PROJ. NO.	STP 9469(1)S		
SHEET	12 OF 40 SHEETS		