

TEMPORARY AND DURABLE 100 mm YELLOW LINE
 STA. 0+100.0 TO 0+800.0, SOLID LT. & RT.
 (WITH CENTERLINE BREAKS FOR TOWN HIGHWAYS)

TEMPORARY AND DURABLE 100 mm WHITE LINE
 STA. 0+100.0 TO 0+800.0, SOLID LT. & RT.
 (WITH CENTERLINE BREAKS FOR TOWN HIGHWAYS)

BITUMINOUS CONCRETE GUTTERS AND TRAFFIC ISLANDS


STA. 0+640.0 TO 0+800.0, LT.
 STA. 0+698.5 TO 0+763.0 RT.
 STA. 0+500 TO 5+500 LT. & RT.
 STA. 0+640 TO 0+890 LT. & RT.

REMOVING SIGNS
 AS SHOWN - 6

ERECTING SALVAGED SIGNS
 AS SHOWN - 2

DURABLE 600mm STOP BAR
 STA. 0+716 RT.

DURABLE LETTER OR SYMBOL
 STA. 0+716 RT. 'STOP'

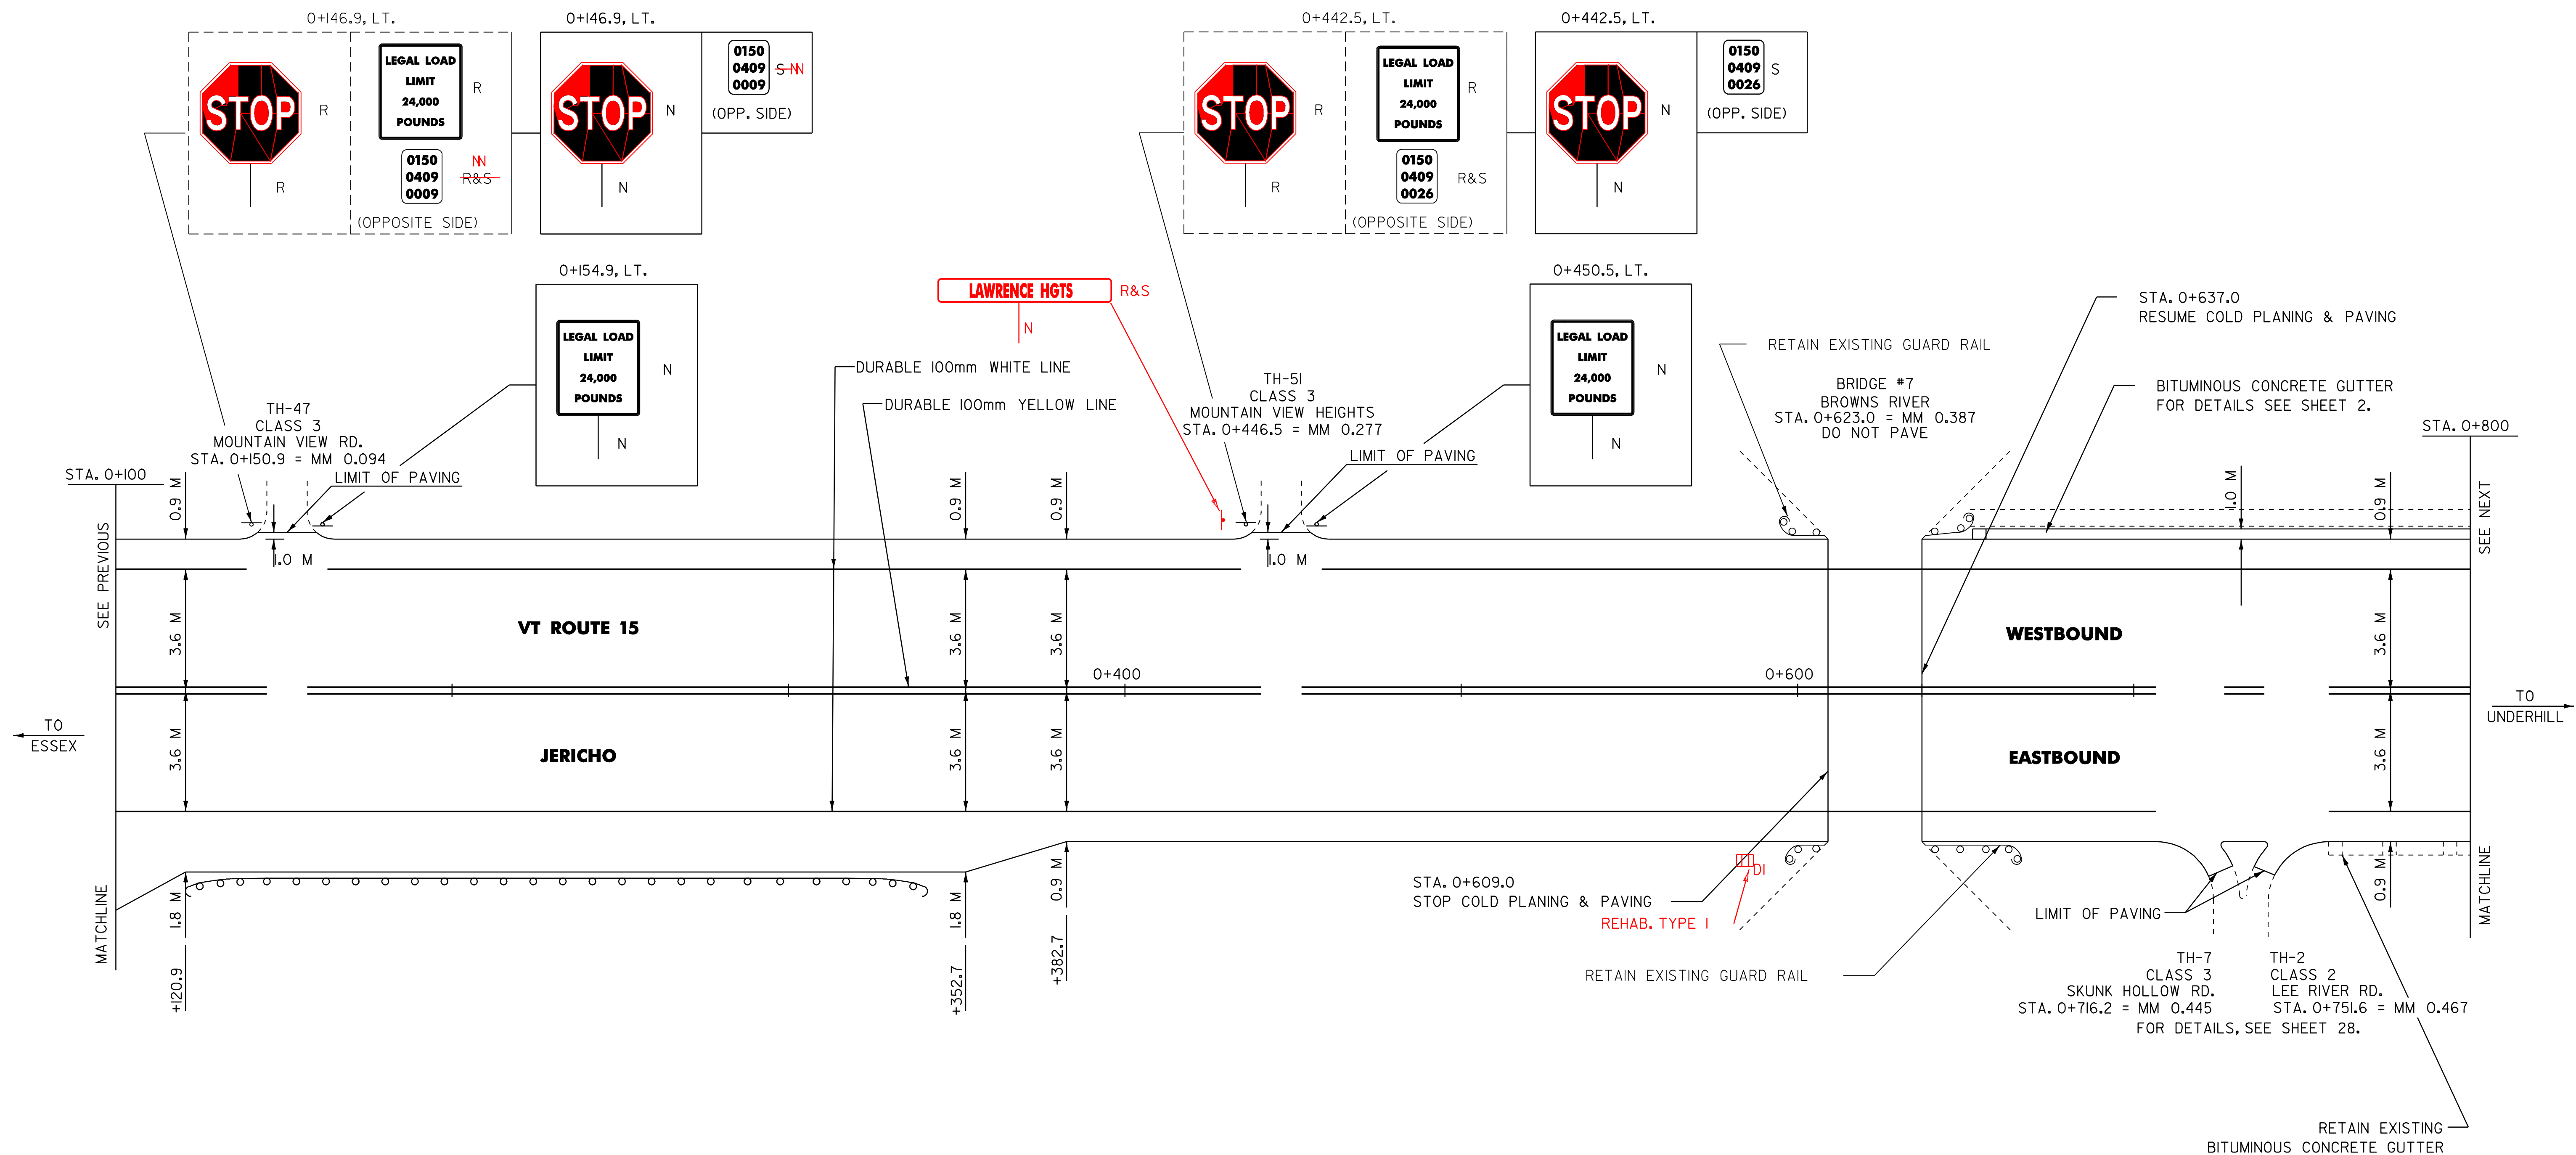

STEEL BEAM GUARDRAIL
 STA. 0+120 TO 0+352 RT.

REMOVAL AND DISPOSAL OF GUARD RAIL
 STA. 0+132.3 TO 0+248.4, RT.
 120.0 352.0

MODIFIED ECCENTRIC LOADER TERMINAL
 STA. 0+120.9, RT.
~~STA. 0+341.3, RT.~~

ANCHOR FOR STEEL BEAM GUARDRAIL
 STA. 0+310.0 RT.

STEEL BEAM GUARDRAIL (MOD. W/ 2.4 M POSTS)
 STA. 0+132.3 TO 0+341.3, RT.
 120.0 352.0

CHANGE ELEVATION OF DI, CB OR MH
 STA. 0+560.0, LT.
 STA. 0+640.0, LT.
 STA. 0+698.5 RT.
 STA. 0+728.0 RT.
 STA. 0+763.0 RT.

DATUM _____
 VERTICAL _____ N/A _____
 HORIZONTAL _____ N/A _____

**ARCHIVED
 IN DPR**

NOTE: ALL DIMENSIONS IN MILLIMETERS
 EXCEPT WHERE OTHERWISE INDICATED

PAVING PROJECT LAYOUT #6	SURVEYED BY	W-M	DATE	12/95
	DESIGN BY	JLL/GAE	DATE	11/96
	DRAWN BY	W-M	DATE	11/96
	DESIGN FILE NO.	/pave/92b221/pb221.dgn		
	IPARM FILE	pb221i06.i	DATE PLOTTED	23-SEP-2009 09:4
PROJ. NAME	ESSEX-UNDERHILL			
PROJ. NO.	STP 9469(1)S			
SHEET	15 OF 40 SHEETS			

NOTES: 1) FOR ANY TOWN HIGHWAY OR STREET DETAILS, SEE VAOT STANDARD E-193.
 2) ALL EXISTING SIGNS NOT SHOWN SHALL BE RETAINED AS DIRECTED BY THE RESIDENT ENGINEER.