

TEMPORARY AND DURABLE 100 mm YELLOW LINE  
 STA. 0+800.0 TO I+500.0, SOLID LT. & RT.  
 (WITH CENTERLINE BREAKS FOR TOWN HIGHWAYS & CROSSWALK)  
 STA. I+308.5, DOUBLE SOLID LT. (OLD PUMP RD.)

TEMPORARY AND DURABLE 100 mm WHITE LINE  
 STA. 0+800.0 TO I+500.0, SOLID LT. & RT.  
 (WITH EDGELINE BREAKS FOR TOWN HIGHWAYS & CROSSWALK)

DURABLE 600 mm STOP BAR  
 STA. I+308.5, LT.


TEMPORARY AND DURABLE LETTER OR SYMBOL  
 STA. I+221.0, RT. - "SCHOOL"  
 STA. I+308.5, LT. - "STOP"  
 STA. I+430.0, LT. - "SCHOOL"

TEMPORARY AND DURABLE CROSSWALK MARKING W/DIAGONAL LINES  
 STA. I+330.0, LT. TO RT.

REMOVING SIGNS  
 AS SHOWN - 12

ERECTING SALVAGED SIGNS  
 AS SHOWN - 4

BITUMINOUS CONCRETE GUTTERS AND TRAFFIC ISLANDS  
 STA. 0+800.0 TO 0+890.0, LT.

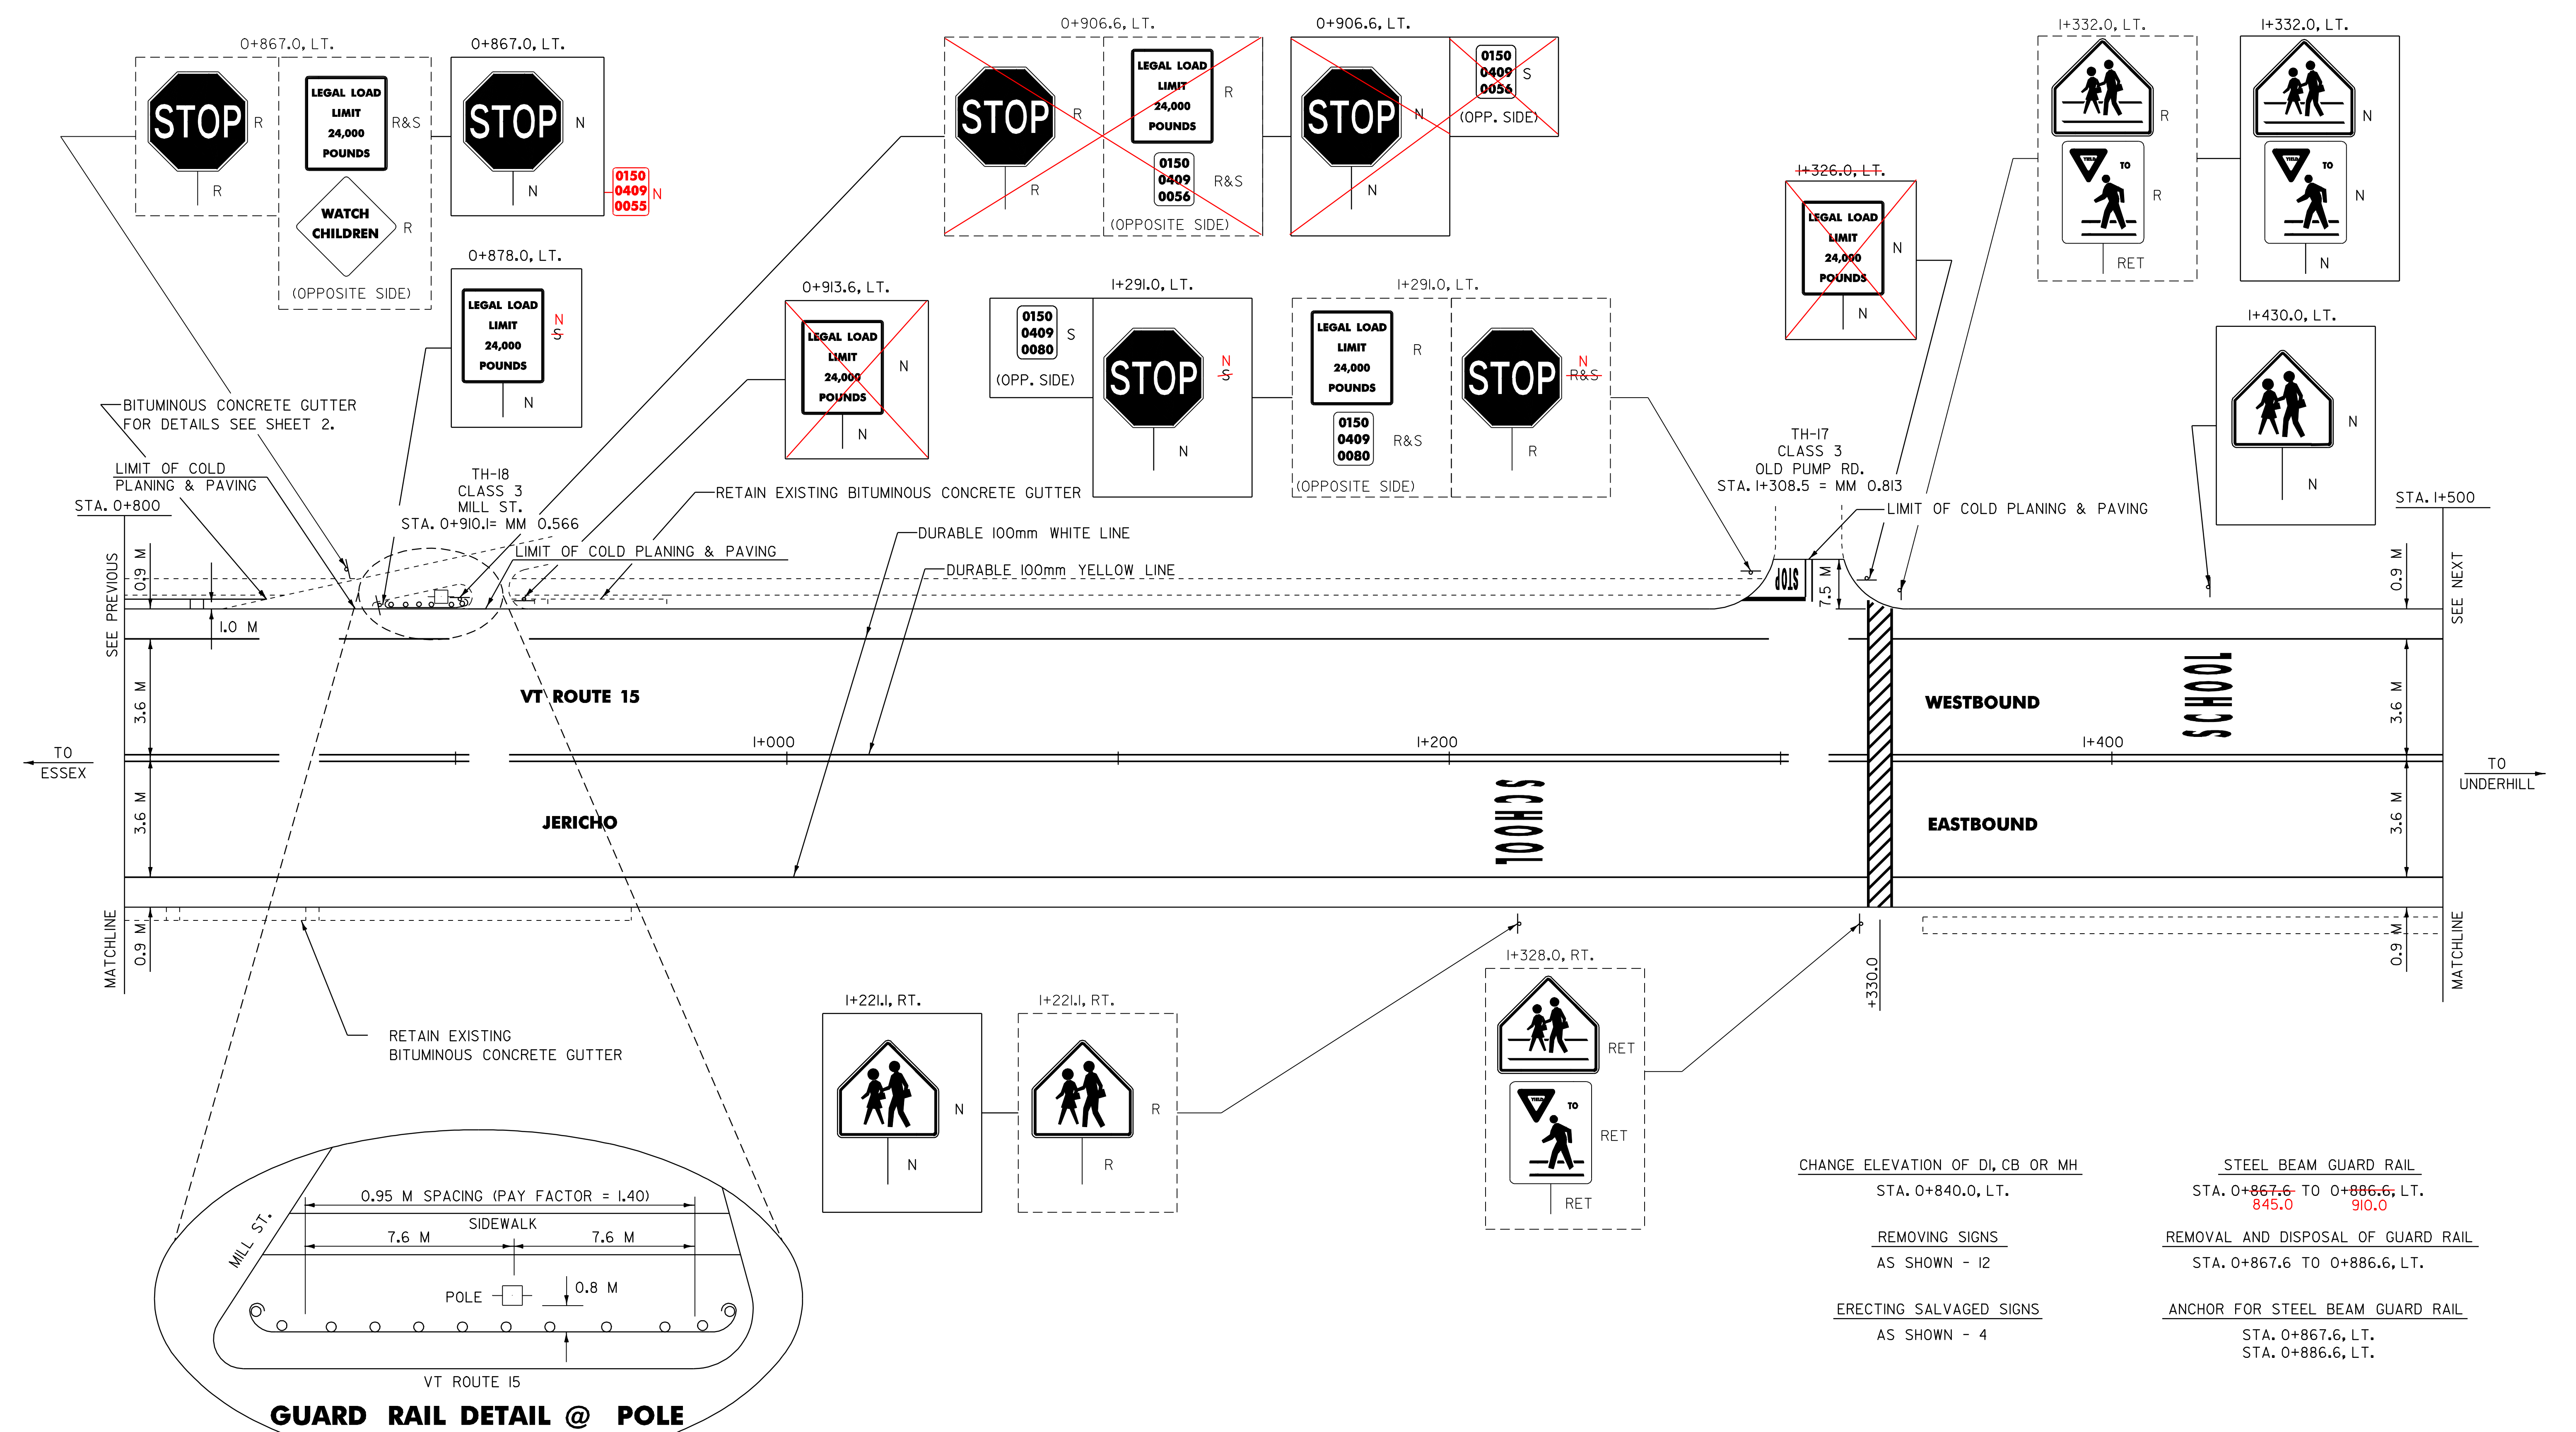

CHANGE ELEVATION OF DI, CB OR MH  
 STA. 0+840.0, LT.

REMOVING SIGNS  
 AS SHOWN - 12

ERECTING SALVAGED SIGNS  
 AS SHOWN - 4

STEEL BEAM GUARD RAIL  
 STA. 0+867.6 TO 0+886.6, LT.  
 845.0 910.0

REMOVAL AND DISPOSAL OF GUARD RAIL  
 STA. 0+867.6 TO 0+886.6, LT.

ANCHOR FOR STEEL BEAM GUARD RAIL  
 STA. 0+867.6, LT.  
 STA. 0+886.6, LT.

NOTE: ALL DIMENSIONS IN MILLIMETERS  
 EXCEPT WHERE OTHERWISE INDICATED

**ARCHIVED  
 IN DPR**

<b>PAVING        PROJECT        LAYOUT #7</b>	SURVEYED BY	W-M	DATE	12/95
	DESIGN BY	JLL/GAE	DATE	11/96
	DRAWN BY	W-M	DATE	11/96
	DESIGN FILE NO.	/pave/92b221/pb221.dgn		
	IPARM FILE	pb221i07.i	DATE	PLOTTED-SEP-2009 09
	PROJ. NAME	ESSEX-UNDERHILL		
PROJ. NO.	STP 9469(1)S			
SHEET		16 OF 40 SHEETS		

NOTES: 1) FOR ANY TOWN HIGHWAY OR STREET  
 DETAILS, SEE VAOT STANDARD E-193.  
 2) ALL EXISTING SIGNS NOT SHOWN SHALL  
 BE RETAINED AS DIRECTED BY THE  
 RESIDENT ENGINEER.

DATUM	
VERTICAL	N/A
HORIZONTAL	N/A