

TEMPORARY AND DURABLE 100 mm YELLOW LINE
 STA. 4+900.0 TO 5+600.0, SOLID LT. & RT.
 (WITH CENTERLINE BREAKS FOR TOWN HIGHWAYS & CROSSWALK)
 STA 5+556.0, DOUBLE SOLID LT. (RACEWAY RD.)

TEMPORARY AND DURABLE 100 mm WHITE LINE
 STA. 4+900.0 TO 5+600.0, SOLID LT. & RT.
 (WITH EDGELINE BREAKS FOR TOWN HIGHWAYS & CROSSWALK)

TEMPORARY AND DURABLE LETTER OR SYMBOL
 STA. 5+375.0, RT. - "SCHOOL"
 STA. 5+556.0, LT. - "STOP"
 STA. 5+595.0, LT. - "SCHOOL"


DURABLE 600 mm STOP BAR
 STA. 5+556.0, LT.

REMOVING SIGNS
 AS SHOWN - 12

ERECTING SALVAGED SIGNS
 AS SHOWN - 5

TEMPORARY AND DURABLE CROSSWALK MARKING W/DIAGONAL LINES
 STA. 5+485.0, LT. TO RT.

REHABILITATION OF DI, CB OR MH
 STA. 4+915.3, RT.
 STA. 4+942.7, LT.
 STA. 4+954.0, RT.

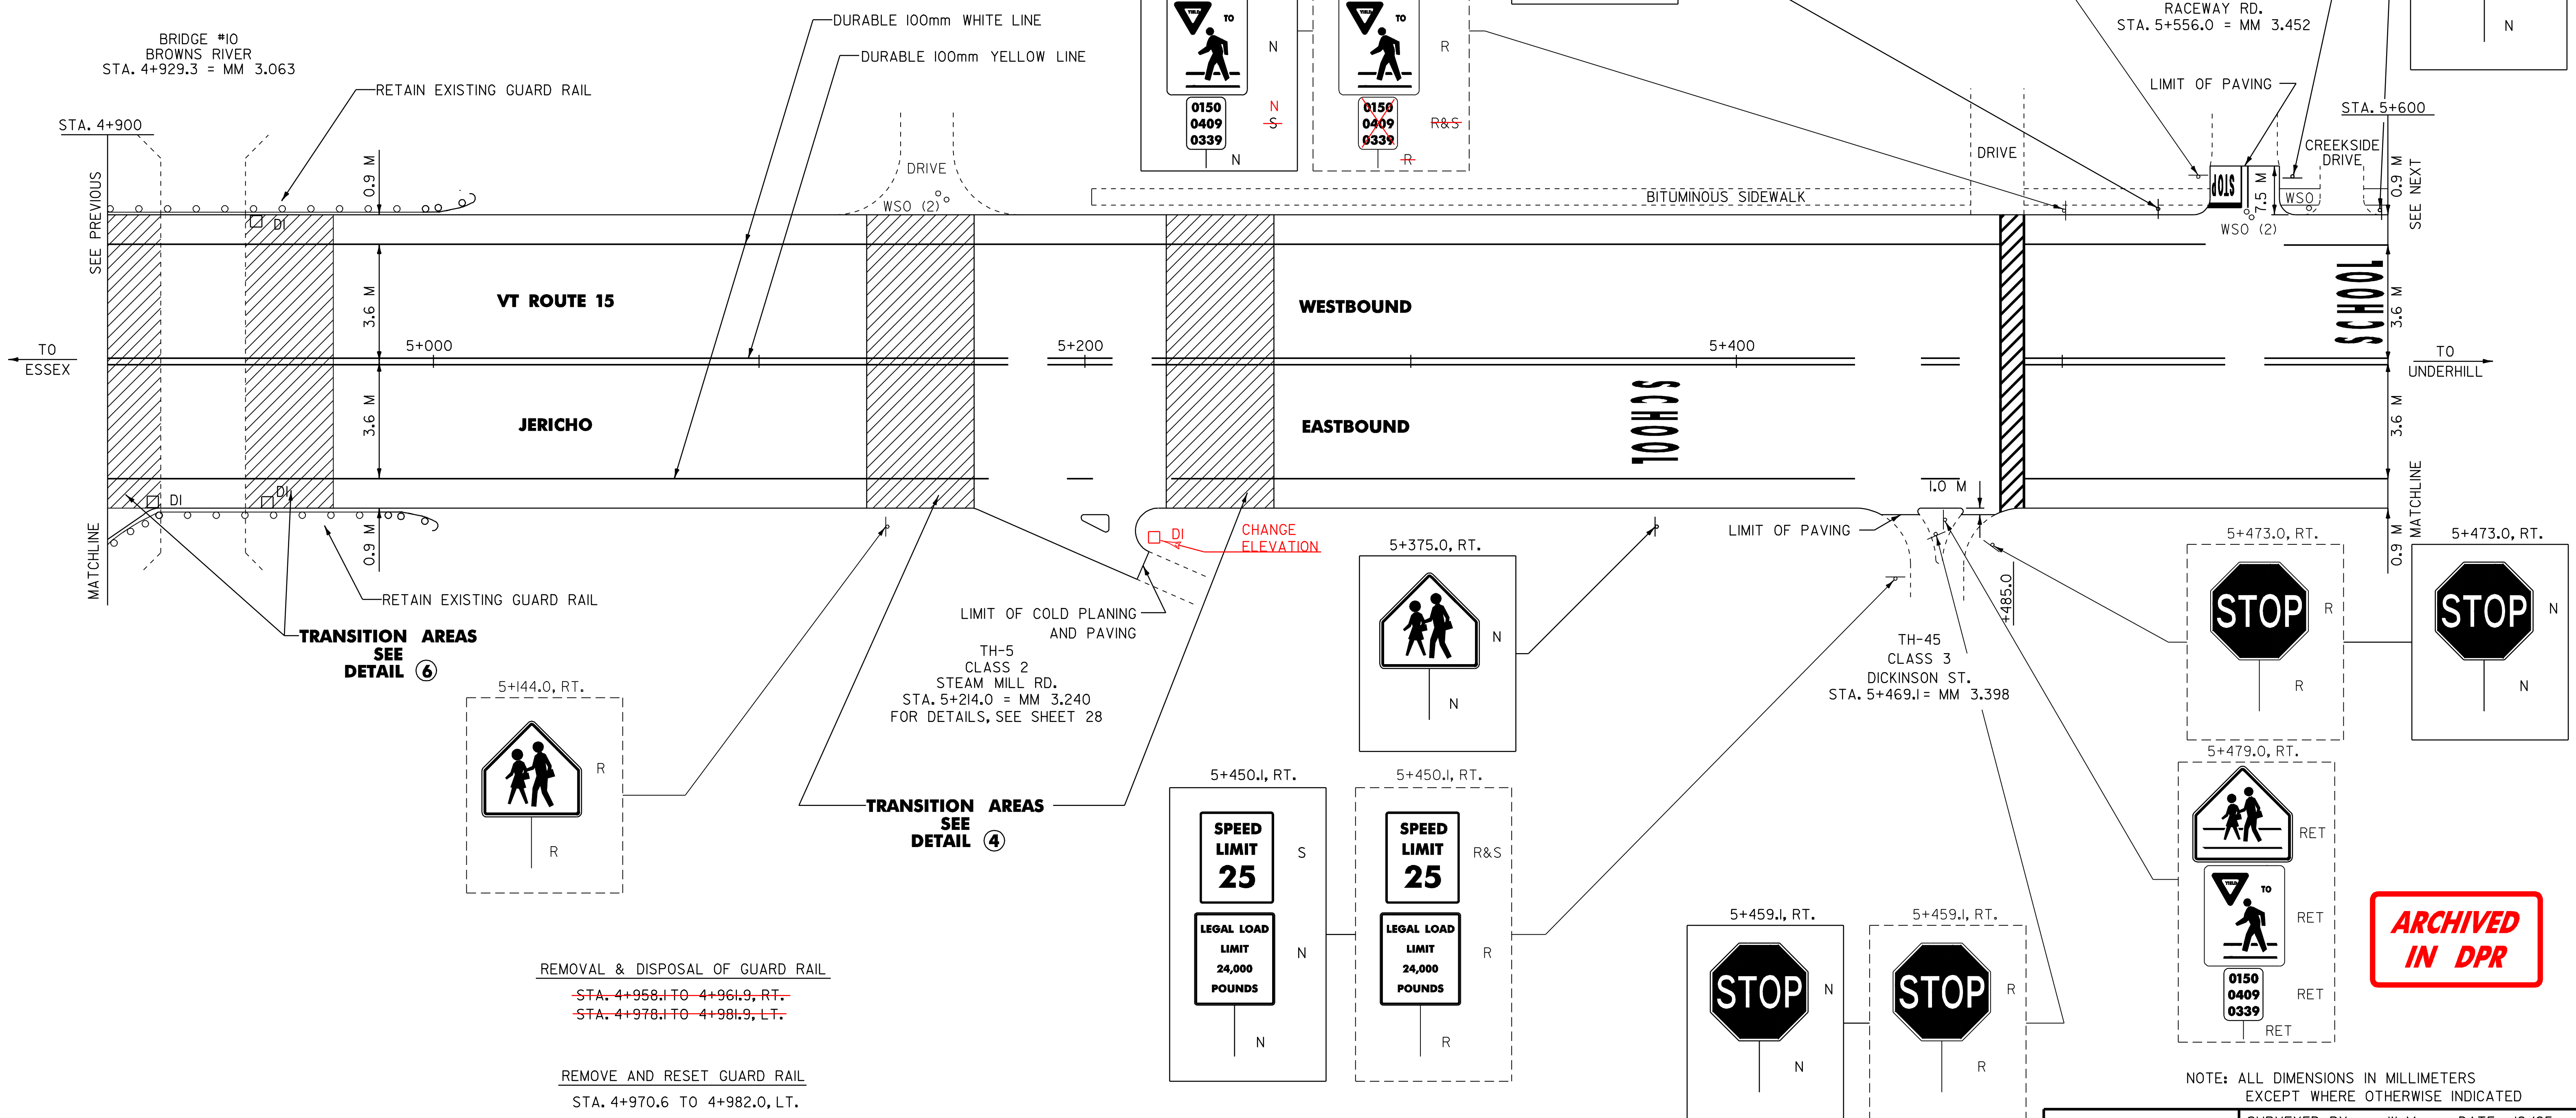

DATUM	
VERTICAL	N/A
HORIZONTAL	N/A

REMOVAL & DISPOSAL OF GUARD RAIL
~~STA. 4+958.1 TO 4+961.9, RT.~~
~~STA. 4+978.1 TO 4+981.9, LT.~~

REMOVE AND RESET GUARD RAIL
 STA. 4+970.6 TO 4+982.0, LT.

MODIFIED ECCENTRIC LOADER TERMINAL
~~STA. 4+958.1, RT.~~
~~STA. 4+978.1, LT.~~

**ARCHIVED
IN DPR**

NOTE: ALL DIMENSIONS IN MILLIMETERS EXCEPT WHERE OTHERWISE INDICATED

PAVING PROJECT LAYOUT #11

SURVEYED BY	W-M	DATE	12/95
DESIGN BY	JLL/GAE	DATE	11/96
DRAWN BY	W-M	DATE	11/96
DESIGN FILE NO.	/pave/92b221/pb221.dgn		
IPARM FILE	pb221iii.1	DATE	PLOTTED-SEP-2009 09
PROJ. NAME	ESSEX-UNDERHILL		
PROJ. NO.	STP 9469(1)S		
SHEET	20 OF 40 SHEETS		

NOTES: 1) FOR ANY TOWN HIGHWAY OR STREET DETAILS, SEE VAOT STANDARD E-193.
 2) ALL EXISTING SIGNS NOT SHOWN SHALL BE RETAINED AS DIRECTED BY THE RESIDENT ENGINEER.