

TEMPORARY AND DURABLE 100 mm YELLOW LINE
 JERICO STA. 5+600.0 TO 6+095.2, SOLID LT. & RT.
 JERICO STA. 6+056.0, DOUBLE SOLID RT.(PARK ST.)
 UNDERHILL STA. 0+000.0 TO 0+200.0, SOLID LT. & RT.
 UNDERHILL STA. 0+051.8 DOUBLE SOLID RT.(RIVER RD.)
 (WITH CENTERLINE BREAKS FOR TOWN HIGHWAYS)
 5+864.0, LT.

TEMPORARY AND DURABLE 100 mm WHITE LINE
 JERICO STA. 5+600.0 TO 6+095.2, SOLID LT. & RT.
 UNDERHILL STA. 0+000.0 TO 0+200.0, SOLID LT. & RT.
 (WITH EDGE LINE BREAKS FOR TOWN HIGHWAYS)
 5+864.0, LT.

DURABLE 600 mm STOP BAR
 JERICO STA. 6+050.7, RT.
 UNDERHILL STA. 0+051.8, RT.

TEMPORARY AND DURABLE LETTER OR SYMBOL
 JERICO STA. 6+050.7, RT. - "STOP"
 UNDERHILL STA. 0+051.8, RT. - "STOP"


REMOVING SIGNS
 AS SHOWN - 10

ERECTING SALVAGED SIGNS
 AS SHOWN - 3

BITUMINOUS CONCRETE GUTTERS AND TRAFFIC ISLANDS
 STA. 5+970.7 TO 6+035, LT. 995.0

CHANGE ELEVATION OF DI, CB OR MH
~~STA. 6+035.0, LT.~~
~~STA. 6+067.0, RT.~~
~~STA. 0+000.0, RT.~~
~~STA. 0+035.5, RT.~~
 STA. 0+003.0 RT.

REHAB. OF DI, CB, MN CL III
 STA. 0+040 LT.

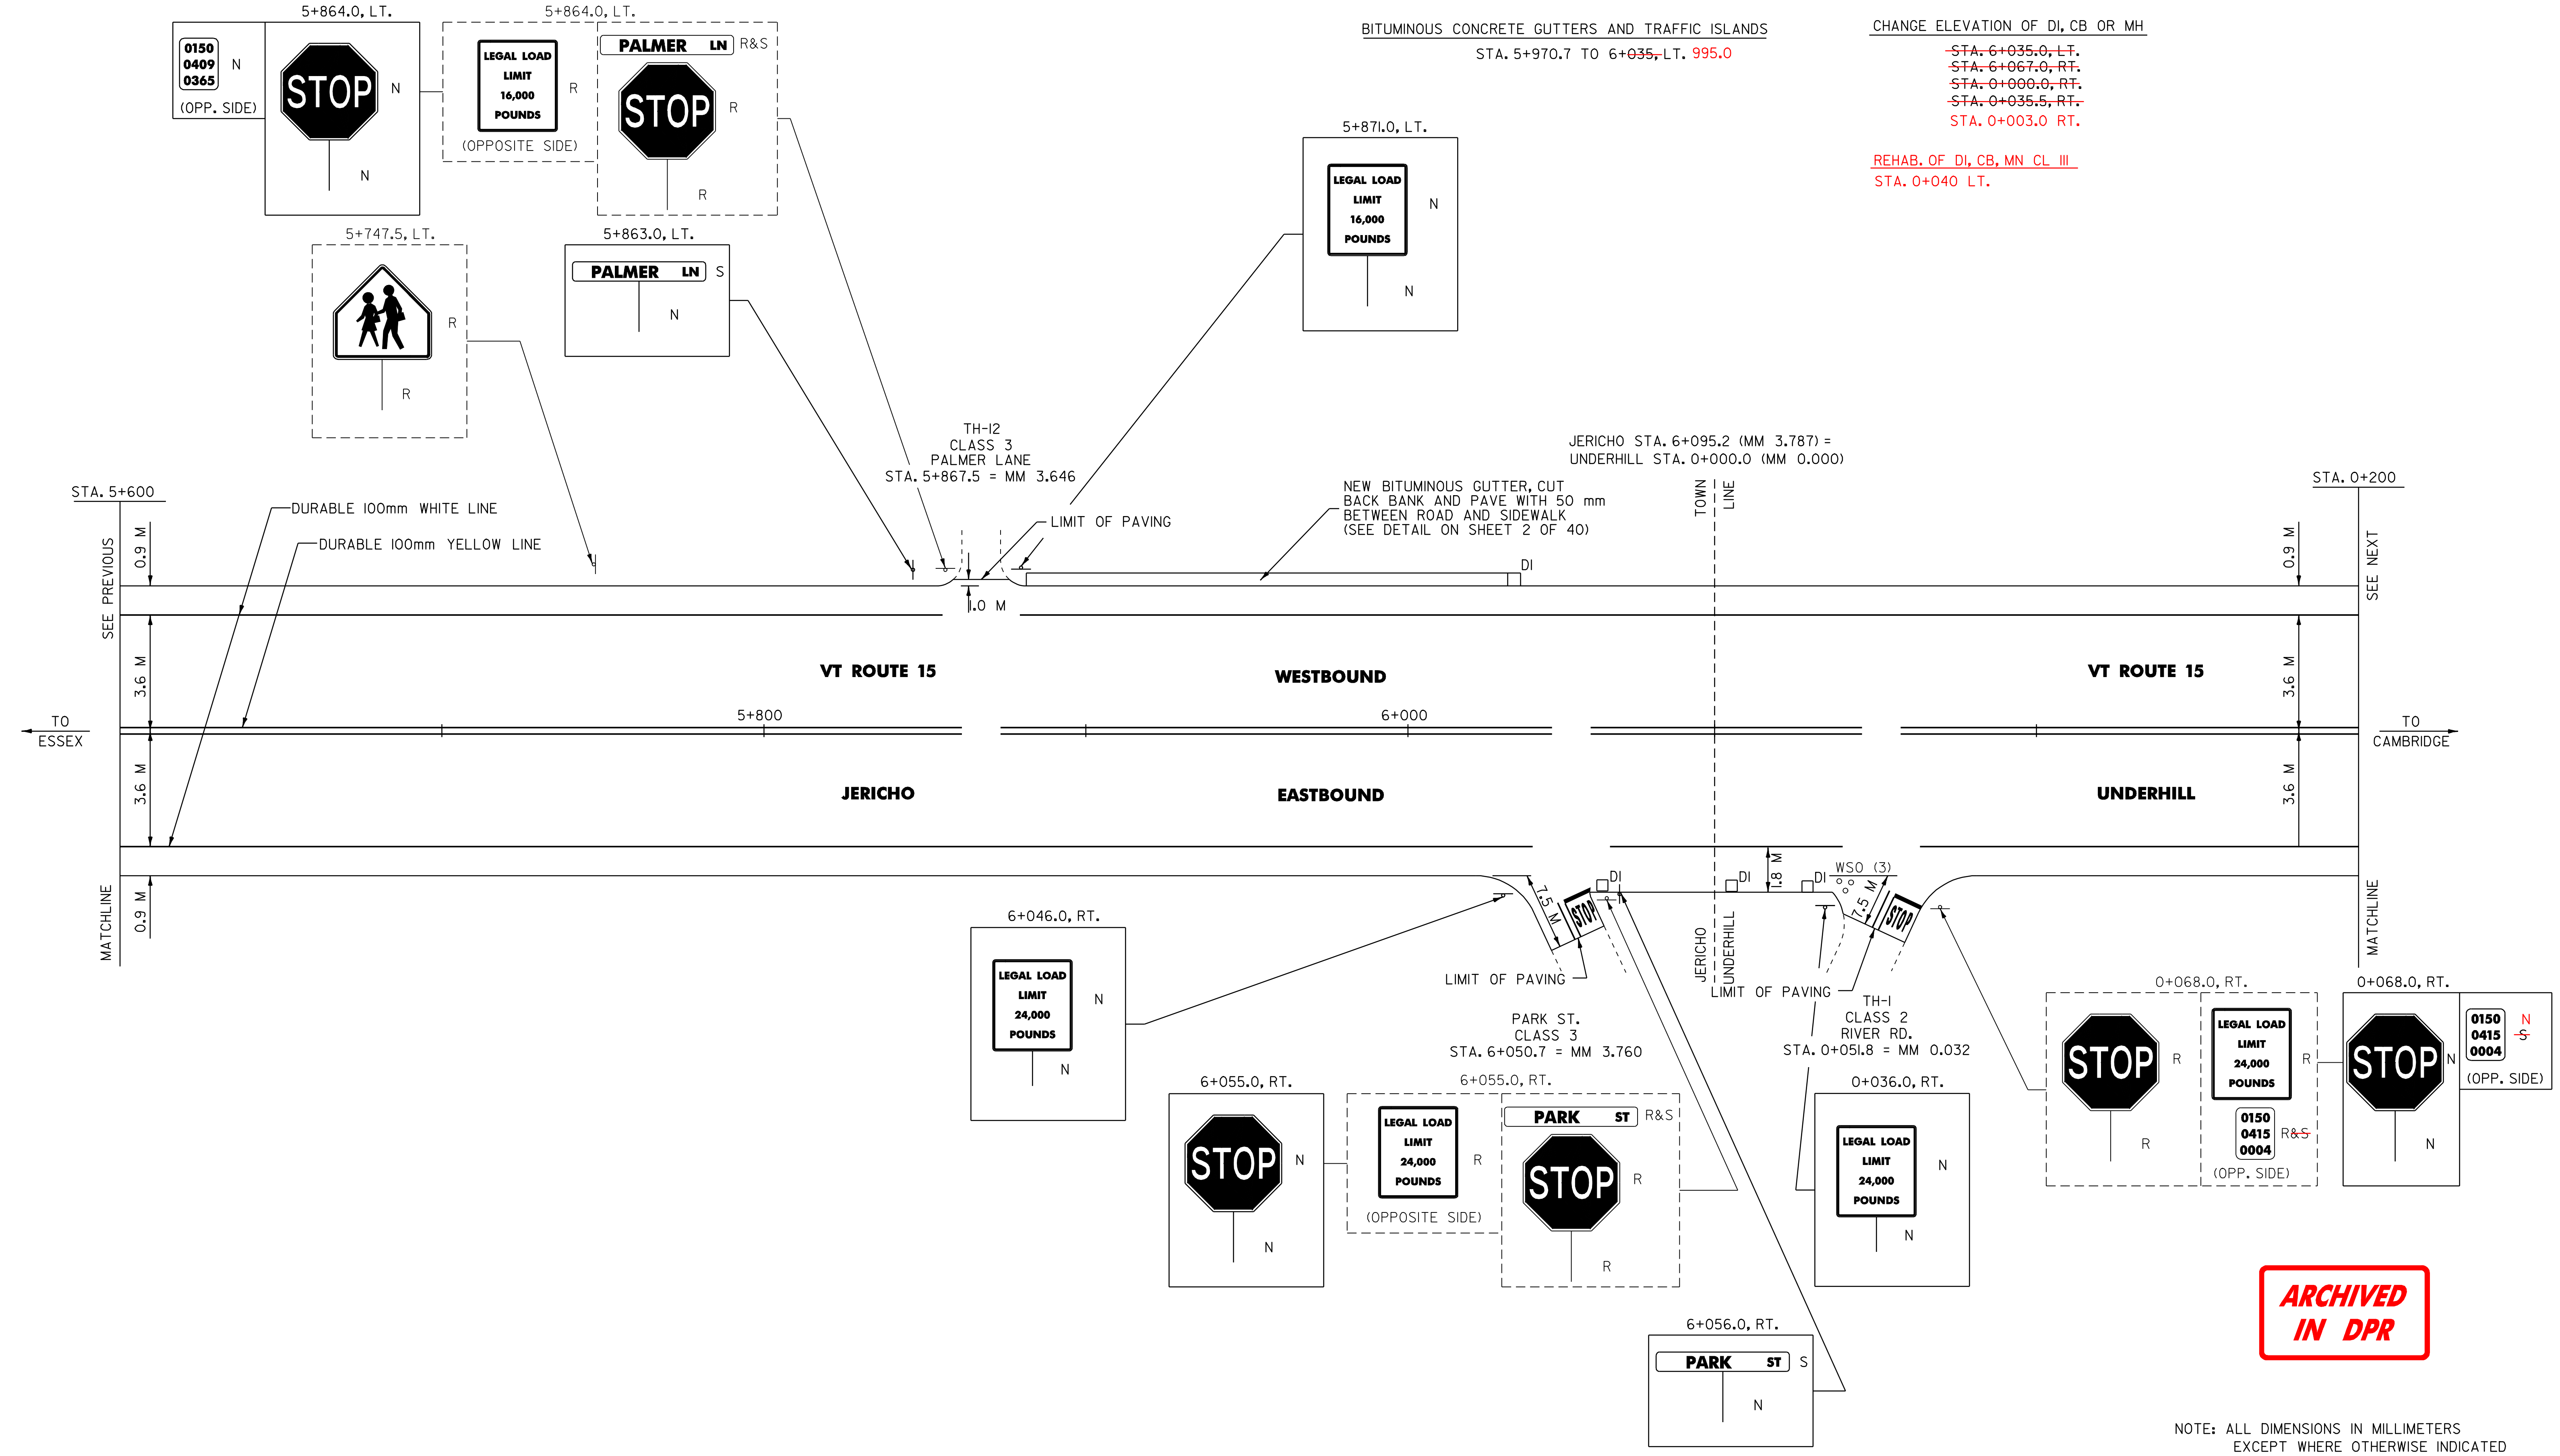

DATUM	
VERTICAL	N/A
HORIZONTAL	N/A

NOTES: 1) FOR ANY TOWN HIGHWAY OR STREET DETAILS, SEE VAOT STANDARD E-193.
 2) ALL EXISTING SIGNS NOT SHOWN SHALL BE RETAINED AS DIRECTED BY THE RESIDENT ENGINEER.

**ARCHIVED
IN DPR**

NOTE: ALL DIMENSIONS IN MILLIMETERS EXCEPT WHERE OTHERWISE INDICATED

PAVING PROJECT LAYOUT #12	SURVEYED BY	W-M	DATE	12/95
	DESIGN BY	JLL/GAE	DATE	11/96
	DRAWN BY	W-M	DATE	11/96
	DESIGN FILE NO.	/pave/92b221/pb221.dgn		
	IPARM FILE	pb21112.1	DATE	PLOTTED 28-SEP-2009 09
	PROJ. NAME	ESSEX-UNDERHILL		
PROJ. NO.	STP 9469(1)S			
SHEET	21 OF 40 SHEETS			