

TEMPORARY AND DURABLE 100 mm YELLOW LINE
 STA. 3+700.0 TO 3+911.0, SOLID LT./DASHED RT.
 STA. 3+911.0 TO 3+975.0, DASHED CENTERLINE
 STA. 3+975.0 TO 4+200.0, DASHED LT./SOLID RT.
 STA. 4+200.0 TO 4+241.0, SOLID LT. & RT.
 (WITH CENTERLINE BREAK FOR REPA RD.)
 STA. 4+241.0 TO 4+400.0, SOLID LT./DASHED RT.

TEMPORARY AND DURABLE 100 mm WHITE LINE
 STA. 3+700.0 TO 4+400.0, SOLID LT. & RT.
 (WITH EDGE LINE BREAK FOR REPA RD.)

REHAB. DI, CB, MH, CL III
 STA. 4+250.0 LT.

TEMPORARY AND DURABLE 600mm STOP BAR
 STA. 4+207.0 LT.

DURABLE LETTER OR SYMBOL
 STA. 4+207.0 LT. 'STOP'

REMOVING SIGNS
 AS SHOWN - 3

ERECTING SALVAGED SIGNS
 AS SHOWN - 1




REMOVAL AND DISPOSAL OF GUARD RAIL
 177.0 STA. 4+181.2 TO 4+344.6, RT. 340.0

MODIFIED ECCENTRIC LOADER TERMINAL
 STA. 4+177.4, RT.

STEEL BEAM GUARD RAIL (MOD. W/2.4 M POSTS)
 STA. 4+188.8 TO 4+340.8, RT.

ANCHOR FOR STEEL BEAM GUARD RAIL
 STA. 4+340.8, RT. (2) I

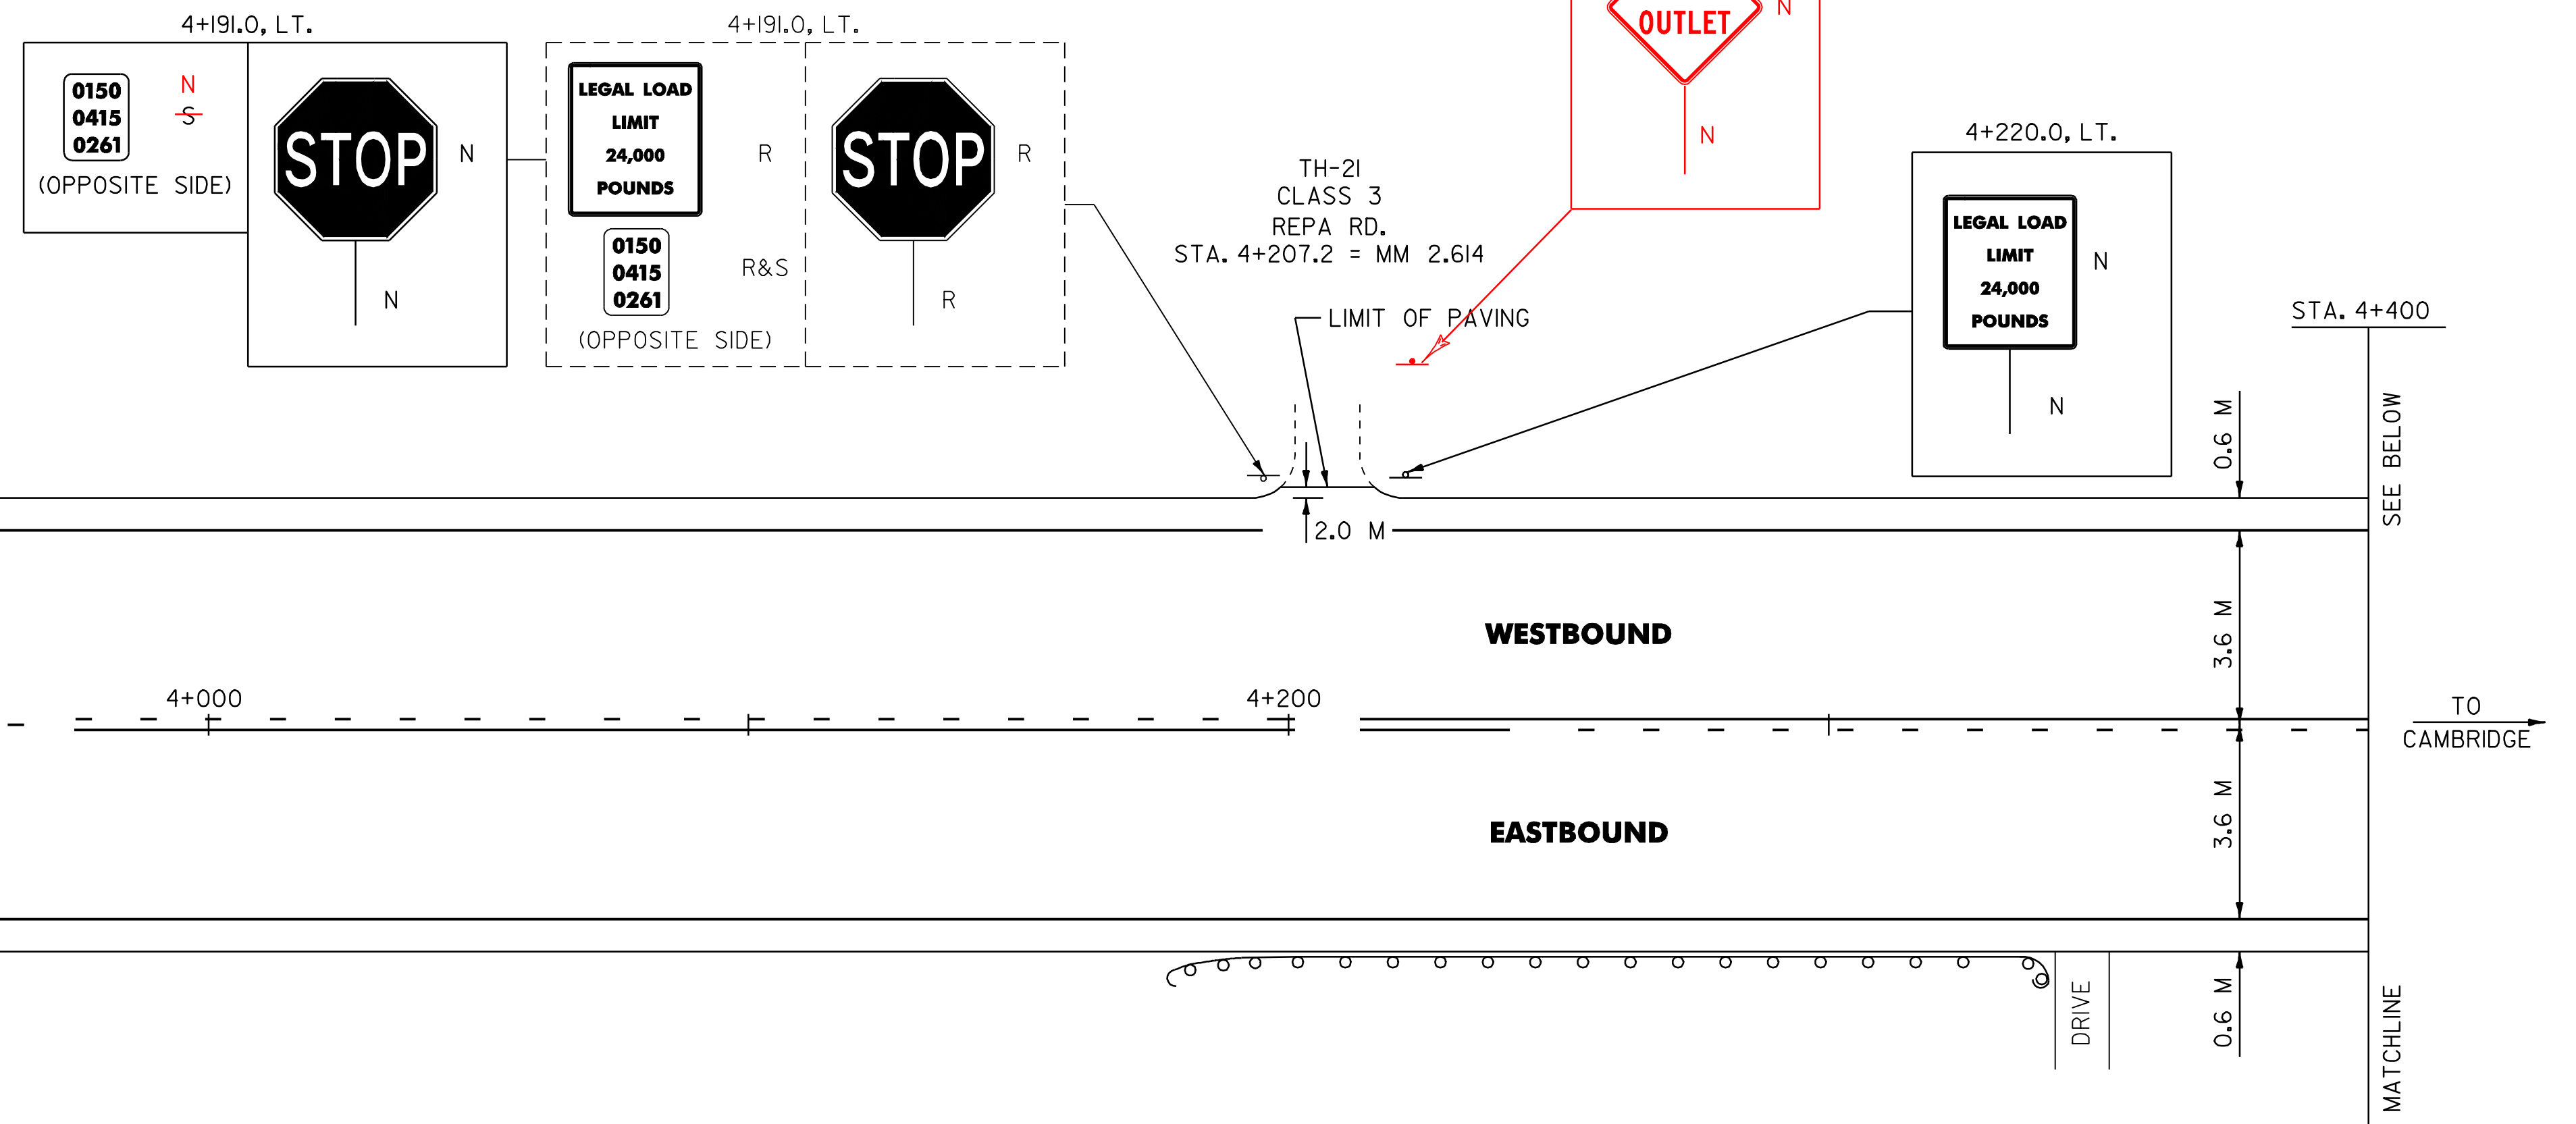

TEMPORARY AND DURABLE 100 mm YELLOW LINE
 STA. 4+400.0 TO 4+458.0, SOLID LT./DASHED RT.
 STA. 4+458.0 TO 4+474.0, SOLID LT. & RT.
 STA. 4+474.0 TO 4+715.0, DASHED LT./SOLID RT.
 STA. 4+715.0 TO 5+100.0, SOLID LT. & RT.

TEMPORARY AND DURABLE 100 mm WHITE LINE
 STA. 4+400.0 TO 5+100.0, SOLID LT. & RT.


REMOVAL AND DISPOSAL OF GUARD RAIL
 444.0 STA. 4+440.7 TO 4+539.5, RT. 535.0
 535.0 STA. 4+555.0 TO 4+808.2, RT. 897.0

MODIFIED ECCENTRIC LOADER TERMINAL
 STA. 4+885.6, RT. 847.0
 STA. 4+947.4, RT. 956.0

STEEL BEAM GUARD RAIL (MOD. W/2.4 M POSTS)
 STA. 4+444.5 TO 4+535.7, RT.
 STA. 4+555.0 TO 4+885.6, RT. 847.0
 901.0 STA. 4+901.8 TO 4+947.4, RT. 956.0

STEEL BEAM GUARD RAIL
 STA. 4+901.0 TO 4+938.0 RT.
 STA. 4+555.0 TO 4+897.0 RT.
 STA. 4+444.0 TO 4+535.0 RT.
 STA. 4+177.0 TO 4+340. RT.

ANCHOR FOR STEEL BEAM GUARD RAIL
 STA. 4+444.5, RT. (2) I
 STA. 4+535.7, RT. (2) I
 STA. 4+555.0, RT. (2) I
 STA. 4+901.8, RT. (2) I

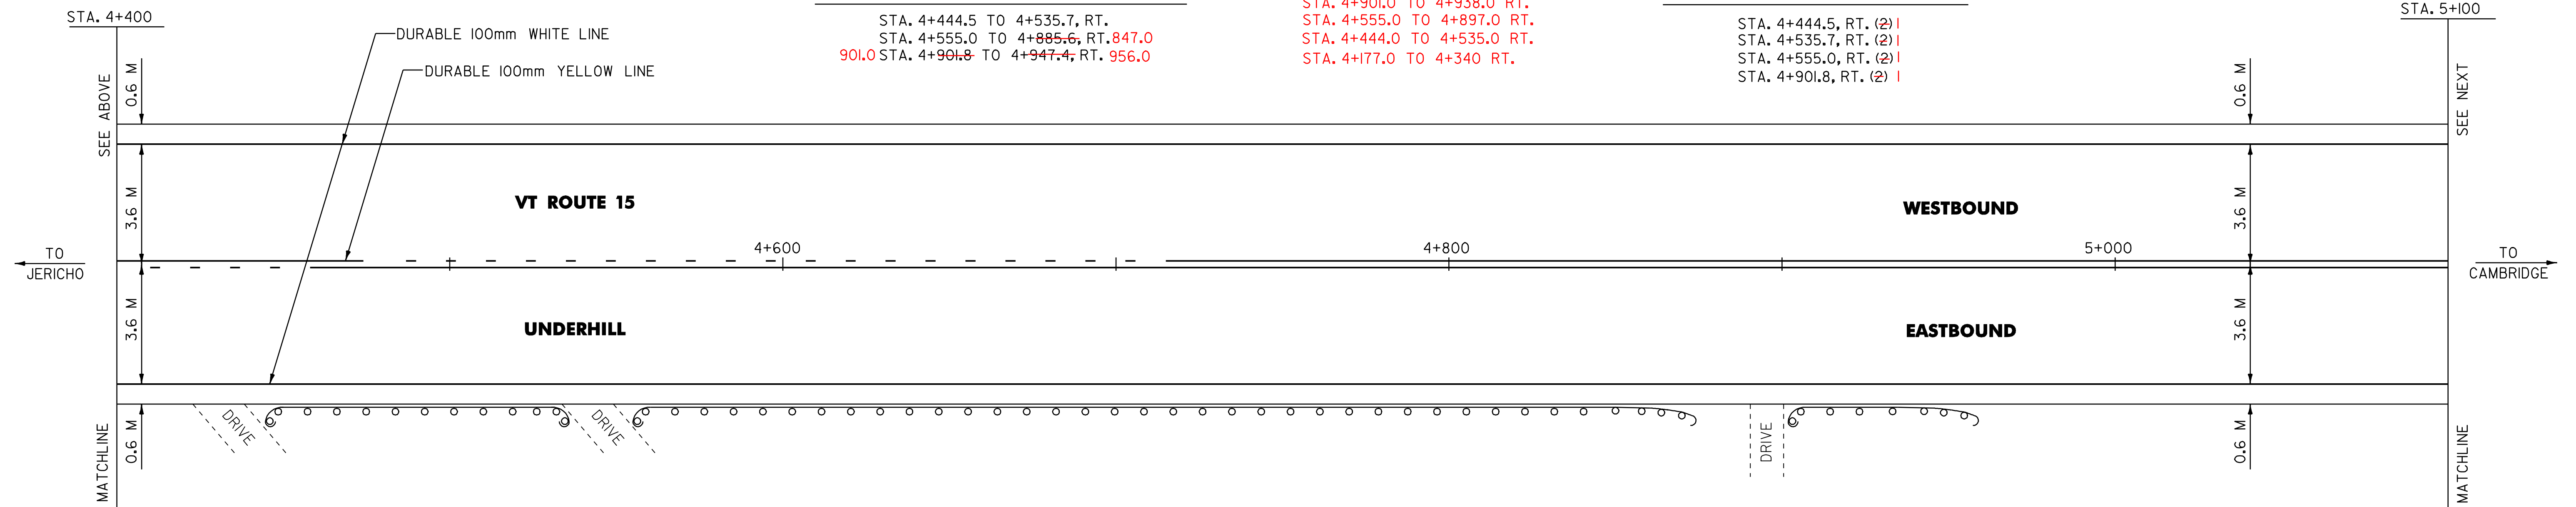

DATUM
 VERTICAL N/A
 HORIZONTAL N/A

**ARCHIVED
 IN DPR**

NOTES: 1) FOR ANY TOWN HIGHWAY OR STREET DETAILS, SEE VAOT STANDARD E-193.
 2) ALL EXISTING SIGNS NOT SHOWN SHALL BE RETAINED AS DIRECTED BY THE RESIDENT ENGINEER.

PAVING PROJECT LAYOUT #16	SURVEYED BY	W-M	DATE	12/95
	DESIGN BY	JLL/GAE	DATE	11/96
	DRAWN BY	W-M	DATE	11/96
	DESIGN FILE NO.	/pave/92b221/pb221.dgn		
	IPARM FILE	pb22116.i	DATE	PLOTTED 28-SEP-2009 09
PROJ. NAME	ESSEX-UNDERHILL			
PROJ. NO.	STP 9469(1)S			
SHEET	25 OF 40 SHEETS			

NOTE: ALL DIMENSIONS IN MILLIMETERS EXCEPT WHERE OTHERWISE INDICATED