


LEGEND

- FINISH GRADE
- - - - EXISTING GROUND
- EOP EXISTING EDGE OF PAVEMENT
- ROW RIGHT OF WAY

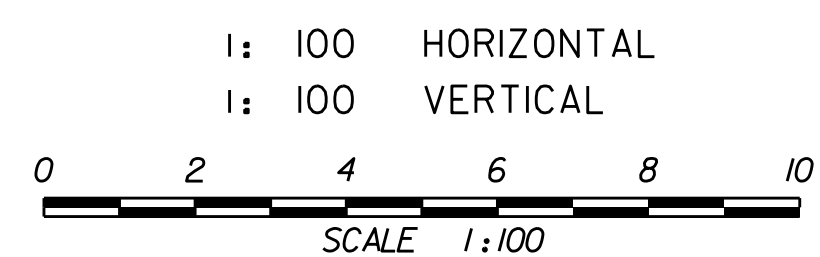

ROUTE 15
CROSS SECTIONS

PROJECT NAME: ESSEX
PROJECT NUMBER: STP 030-1(17)S

PLOT FILE NAME: zstp030-1(17)swrk8.dgn
L&D PROJECT NUMBER: 00-074
DESIGNED BY: LAMOUREUX & DICKINSON
CONSULTING ENGINEERS, INC. SHEET 12

DRAWN BY: PLC
CHECKED BY: RJD