


LEGEND

————	FINISH GRADE
- - - - -	EXISTING GROUND
—+—+—+—	EOP EXISTING EDGE OF PAVEMENT
— — — —	ROW RIGHT OF WAY

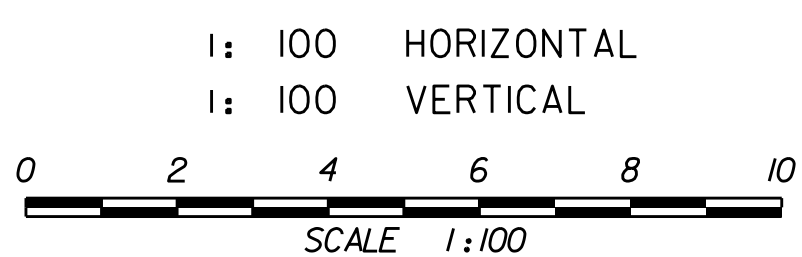

ROUTE 15 CROSS SECTIONS	PROJECT NAME: ESSEX
	PROJECT NUMBER: STP 030-1(17)S
	PLOT FILE NAME: zstp030-1(17)swrk8.dgn
	L&D PROJECT NUMBER: 00-074
DESIGNED BY: LAMOUREUX & DICKINSON	DRAWN BY: PLC
CONSULTING ENGINEERS, INC.	CHECKED BY: RJD
	SHEET 15