


LEGEND

| | |
|--|-------------------------------|
| | FINISH GRADE |
| | EXISTING GROUND |
| | EOP EXISTING EDGE OF PAVEMENT |
| | ROW RIGHT OF WAY |

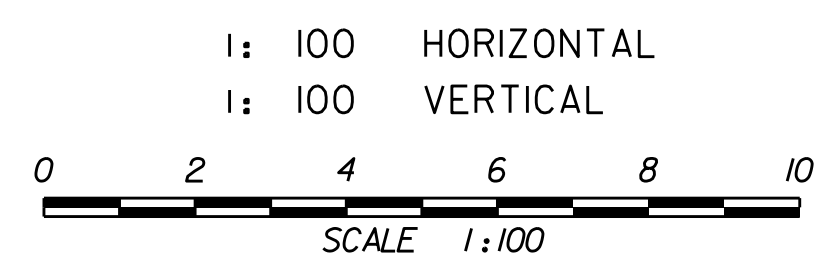

| | |
|------------------------------------|--|
| OLD STAGE ROAD CROSS SECTIONS | PROJECT NAME: ESSEX |
| | PROJECT NUMBER: STP 030-1(17)S |
| | PLOT FILE NAME: zstp030-1(17)swrk8.dgn |
| | L&D PROJECT NUMBER: 00-074 |
| DESIGNED BY: LAMOUREUX & DICKINSON | DRAWN BY: PLC |
| CONSULTING ENGINEERS, INC. | CHECKED BY: RJD |
| | SHEET 18 |