


**LEGEND**

	FINISH GRADE
	EXISTING GROUND
	EOP EXISTING EDGE OF PAVEMENT
	ROW RIGHT OF WAY

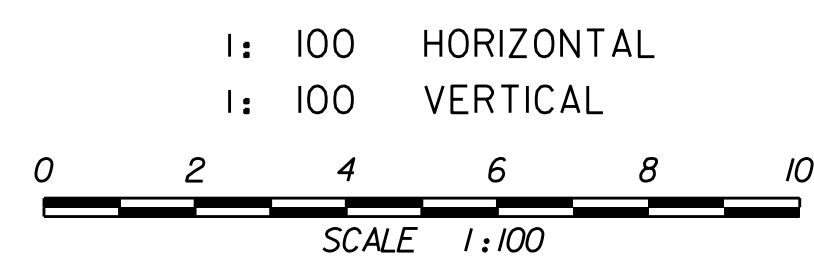

OLD STAGE ROAD CROSS SECTIONS	PROJECT NAME: ESSEX	DRAWN BY: PLC CHECKED BY: RJD CONSULTING ENGINEERS, INC. SHEET 19
	PROJECT NUMBER: STP 030-1(I)7S	
	PLOT FILE NAME: zstp030-1(I)7swrk8.dgn	
	L&D PROJECT NUMBER: 00-074	