


LEGEND

	FINISH GRADE
	EXISTING GROUND
	EOP EXISTING EDGE OF PAVEMENT
	ROW RIGHT OF WAY

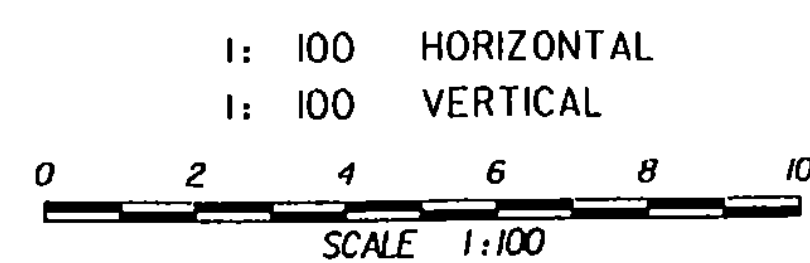

OLD STAGE ROAD
 CROSS SECTIONS

PROJECT NAME: ESSEX
 PROJECT NUMBER: STP 030-1(17)S

PLOT FILE NAME: zstp030-1(17)swrk8.dgn
 L&D PROJECT NUMBER: 00-074
 DESIGNED BY: LAMOUREUX & DICKINSON
 CONSULTING ENGINEERS, INC. SHEET 23 OF 42

DRAWN BY: PLC
 CHECKED BY: RJD