


LEGEND
 ——— FINISH GRADE
 - - - - - EXISTING GROUND
 EOP EXISTING EDGE OF PAVEMENT
 ROW RIGHT OF WAY

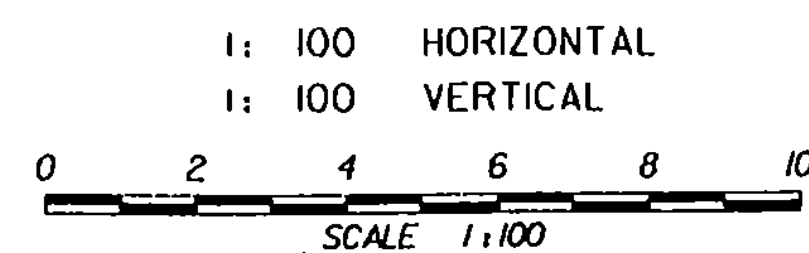

PROJECT NAME: ESSEX
 PROJECT NUMBER: STP 030-1117S
 PLOT FILE NAME: zstp030-1117swrk8.dgn
 L&D PROJECT NUMBER: 00-074
 DESIGNED BY: LAMOUREUX & DICKINSON
 CONSULTING ENGINEERS, INC.
 DRAWN BY: PLC
 CHECKED BY: RJD
 SHEET 24 OF 42