



**ANTENNA MOUNTING DETAIL**  
NTS

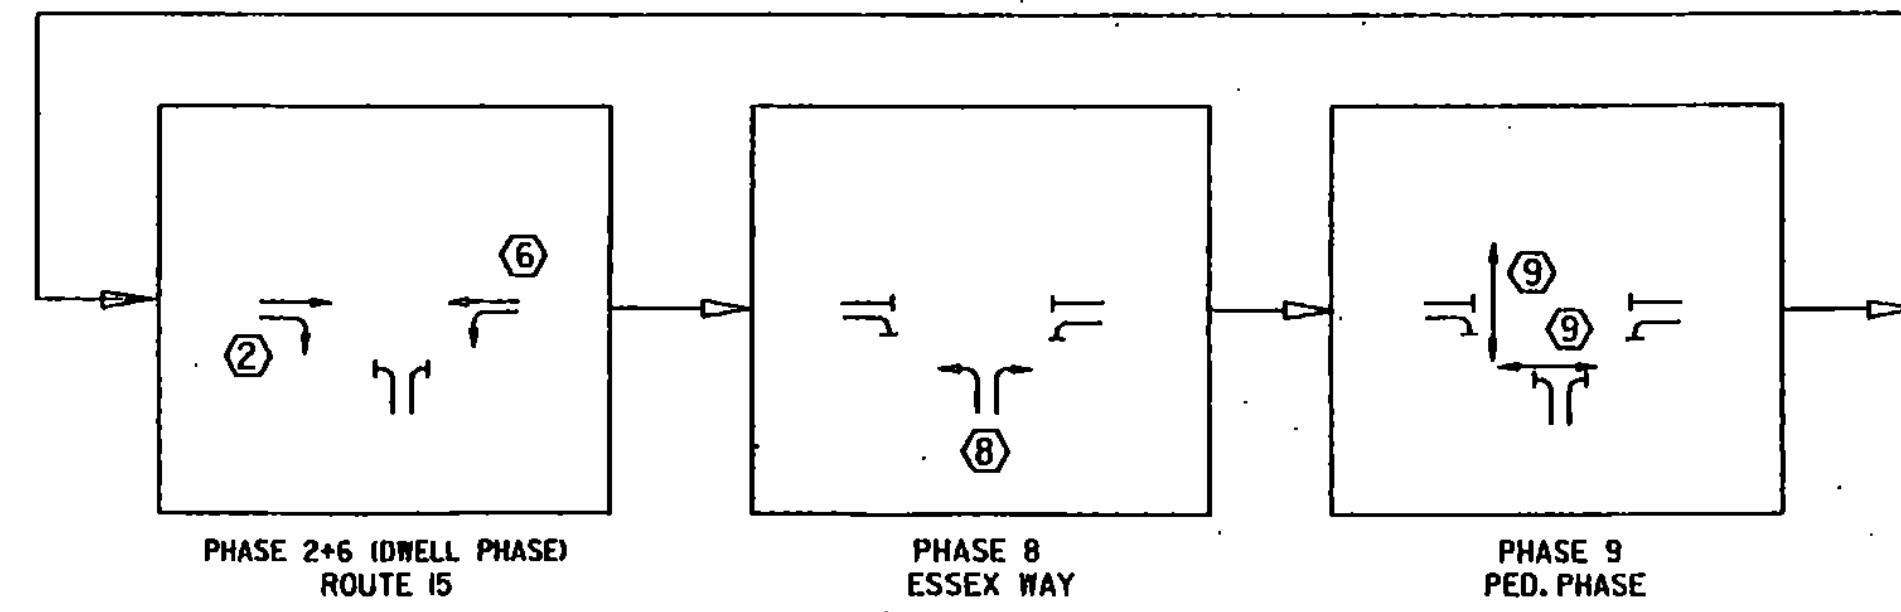


**PHASING PLAN**

PROGRAM CONTROLLER FOR NEMA DUAL RING / FULLY ACTUATED OPERATION		PHASE 2+6 ROUTE 15	PHASE 8 ESSEX WAY	PHASE 9 PEDESTRIAN		
	VEH. EXTENSION		2			
	RT. TURN DELAY	-	5			
	MIN. GREEN	8	7			
	YELLOW CLEAR	4	4			
	RED CLEAR	2	2			
CYCLE LENGTH				MAN (WALK)	FLASHING HAND	HAND
120 SEC.	A.M. PEAK (6:00 - 9:00 AM)	MAX. GREEN	75	4	14	2
80 SEC.	OFF PEAK	MAX. GREEN	28	4	14	2
120 SEC.	P.M. PEAK (3:00 - 6:00 PM)	MAX. GREEN	63	4	14	2
	FLASHING OPERATION (EMERGENCY ONLY)	② + ⑥ FY	⑧ FR	BLANK		

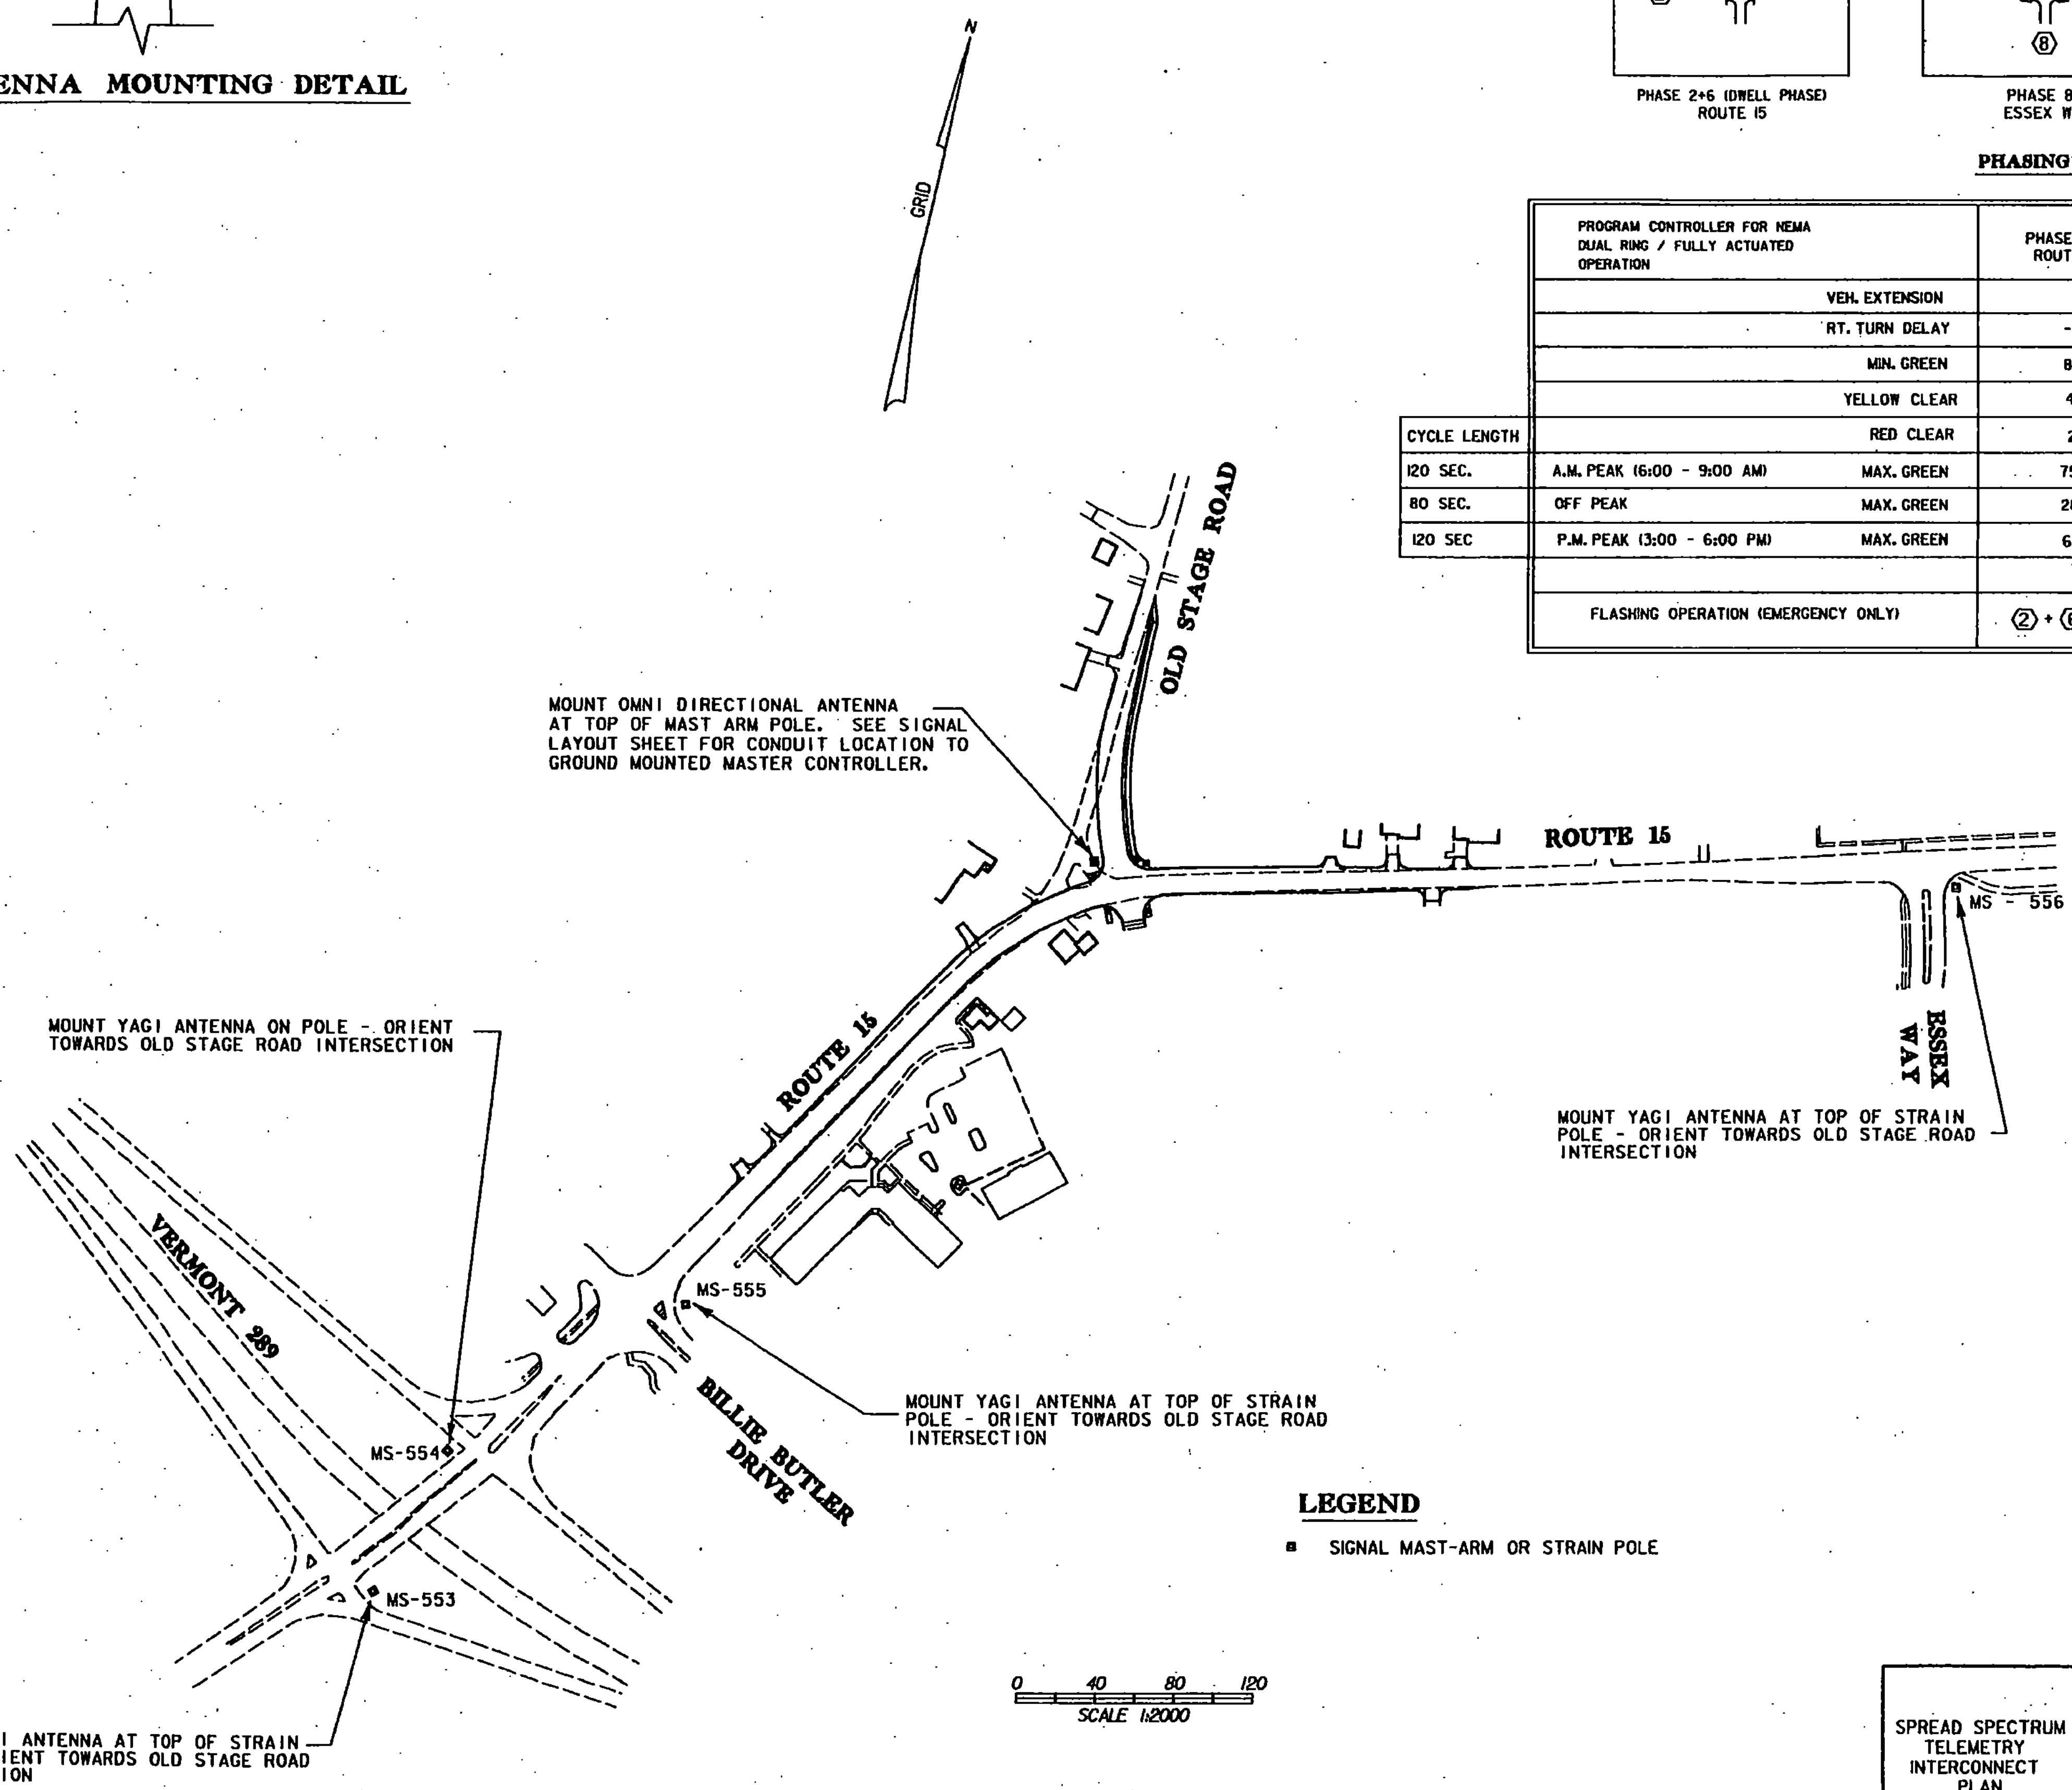

**LEGEND**

■ SIGNAL MAST-ARM OR STRAIN POLE

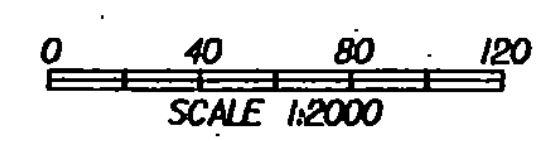

SPREAD SPECTRUM TELEMETRY INTERCONNECT PLAN	PROJECT NAME: ESSEX
	PROJECT NUMBER: STP 030-1(17)S
	PLOT FILE NAME: zstp030-1(17)sfrm7.dgn
	L&D PROJECT NUMBER: 00-074
DESIGNED BY: LAMOUREUX & DICKINSON	DRAWN BY: PLC
CONSULTING ENGINEERS, INC.	CHECKED BY: RJD
	SHEET 41 OF 42