


# STATE OF VERMONT AGENCY OF TRANSPORTATION

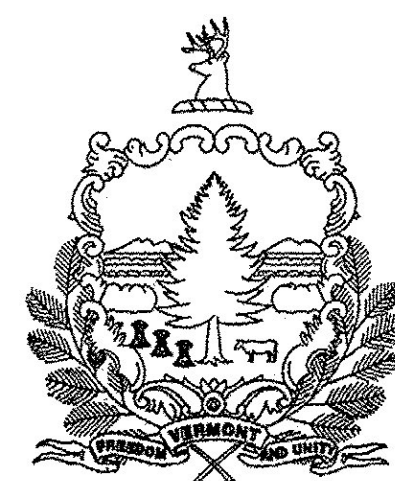

## PROPOSED IMPROVEMENT BRIDGE PROJECT



TOWN OF WARDSBORO  
COUNTY OF WINDHAM

VT ROUTE 100 - (MINOR ARTERIAL)      BRIDGE NO : 68


**PROJECT LOCATION:** BEGINNING ON VT 100 APPROXIMATELY 0.008 MILE SOUTH OF THE INTERSECTION OF VT 100 AND TH 6 AND EXTENDING NORTHERLY ALONG VT 100 FOR 0.057 MILE.

**PROJECT DESCRIPTION:** REPLACEMENT OF EXISTING BRIDGE ON EXISTING ALIGNMENT ALONG WITH RELATED ROADWAY APPROACH AND CHANNEL WORK.

**LENGTH OF STRUCTURE:** 69.67 FEET  
**LENGTH OF ROADWAY:** 280.33 FEET  
**LENGTH OF PROJECT:** 350.00 FEET

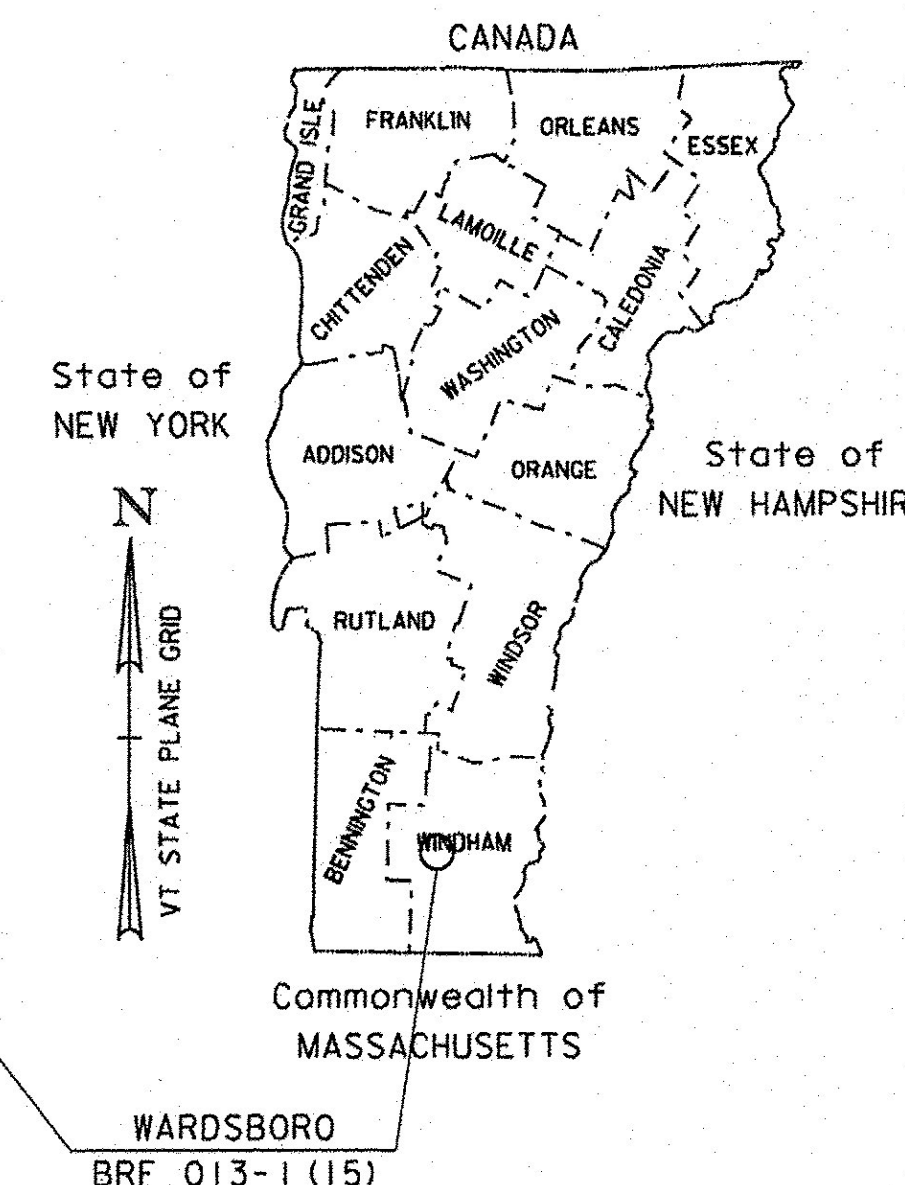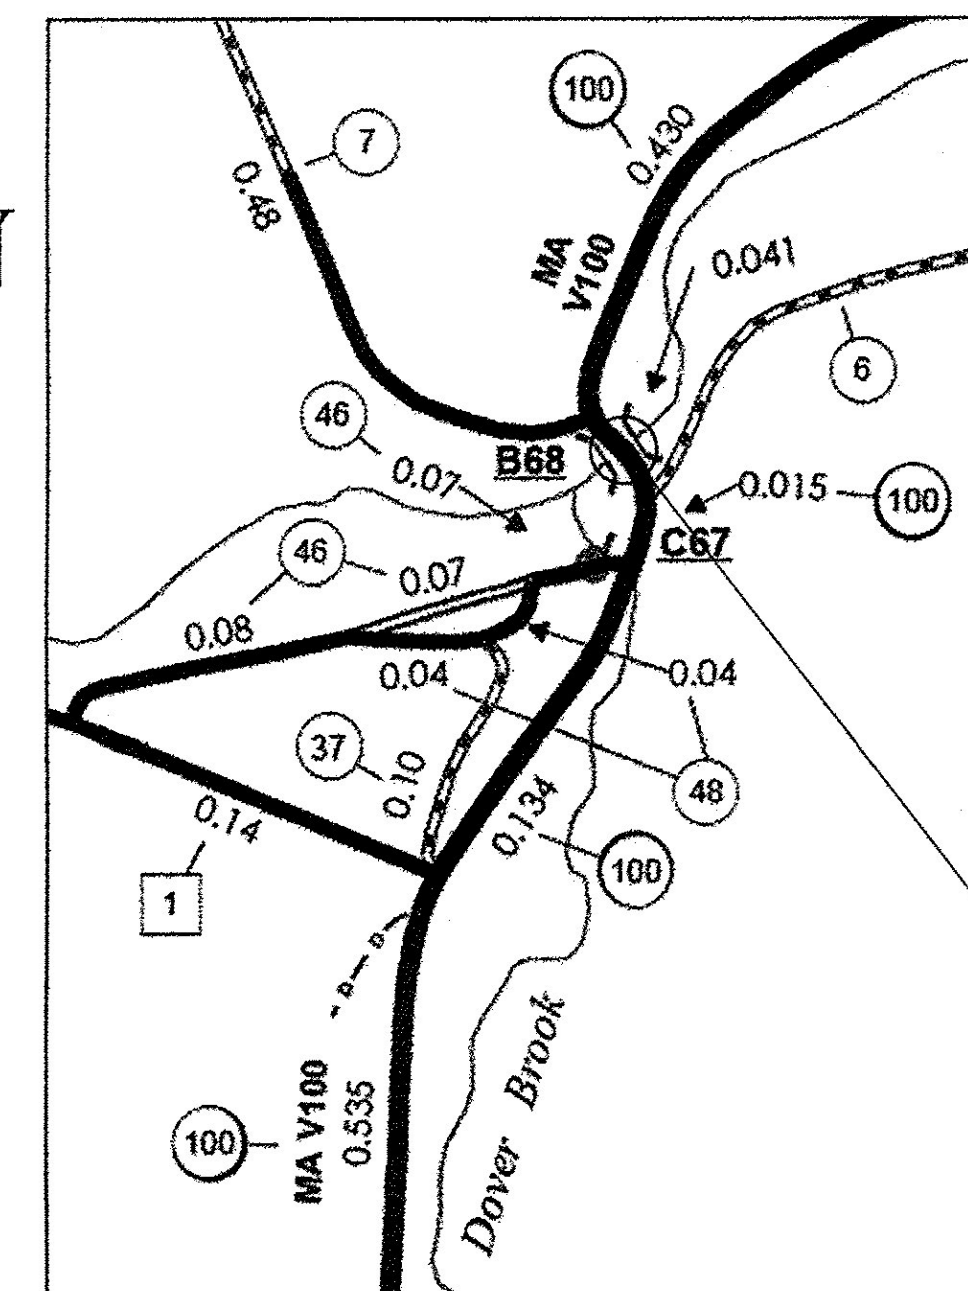

RECORD PLANS	
CONTRACTOR:	RENAUD BROTHERS, INC. - VERNON, VT
RESIDENT ENGINEER:	CHAD GREENWOOD
CONSTRUCTION BEGAN:	MARCH 3, 2016
CONSTRUCTION COMPLETE:	NOVEMBER 7, 2017
RECORD PLANS BY:	CHAD GREENWOOD & AARON WEAVER
I HEREBY CERTIFY THAT ALL THE CONSTRUCTION REQUIRED BY THIS SET OF DRAWINGS HAS BEEN ACCOMPLISHED AS INDICATED HEREIN.	
BY	RESIDENT ENGINEER
DATE	7/17/18
NOTE: Any further information concerning final quantities, amounts or other details relative to this project may be found at Central Files in the electronic archives.	

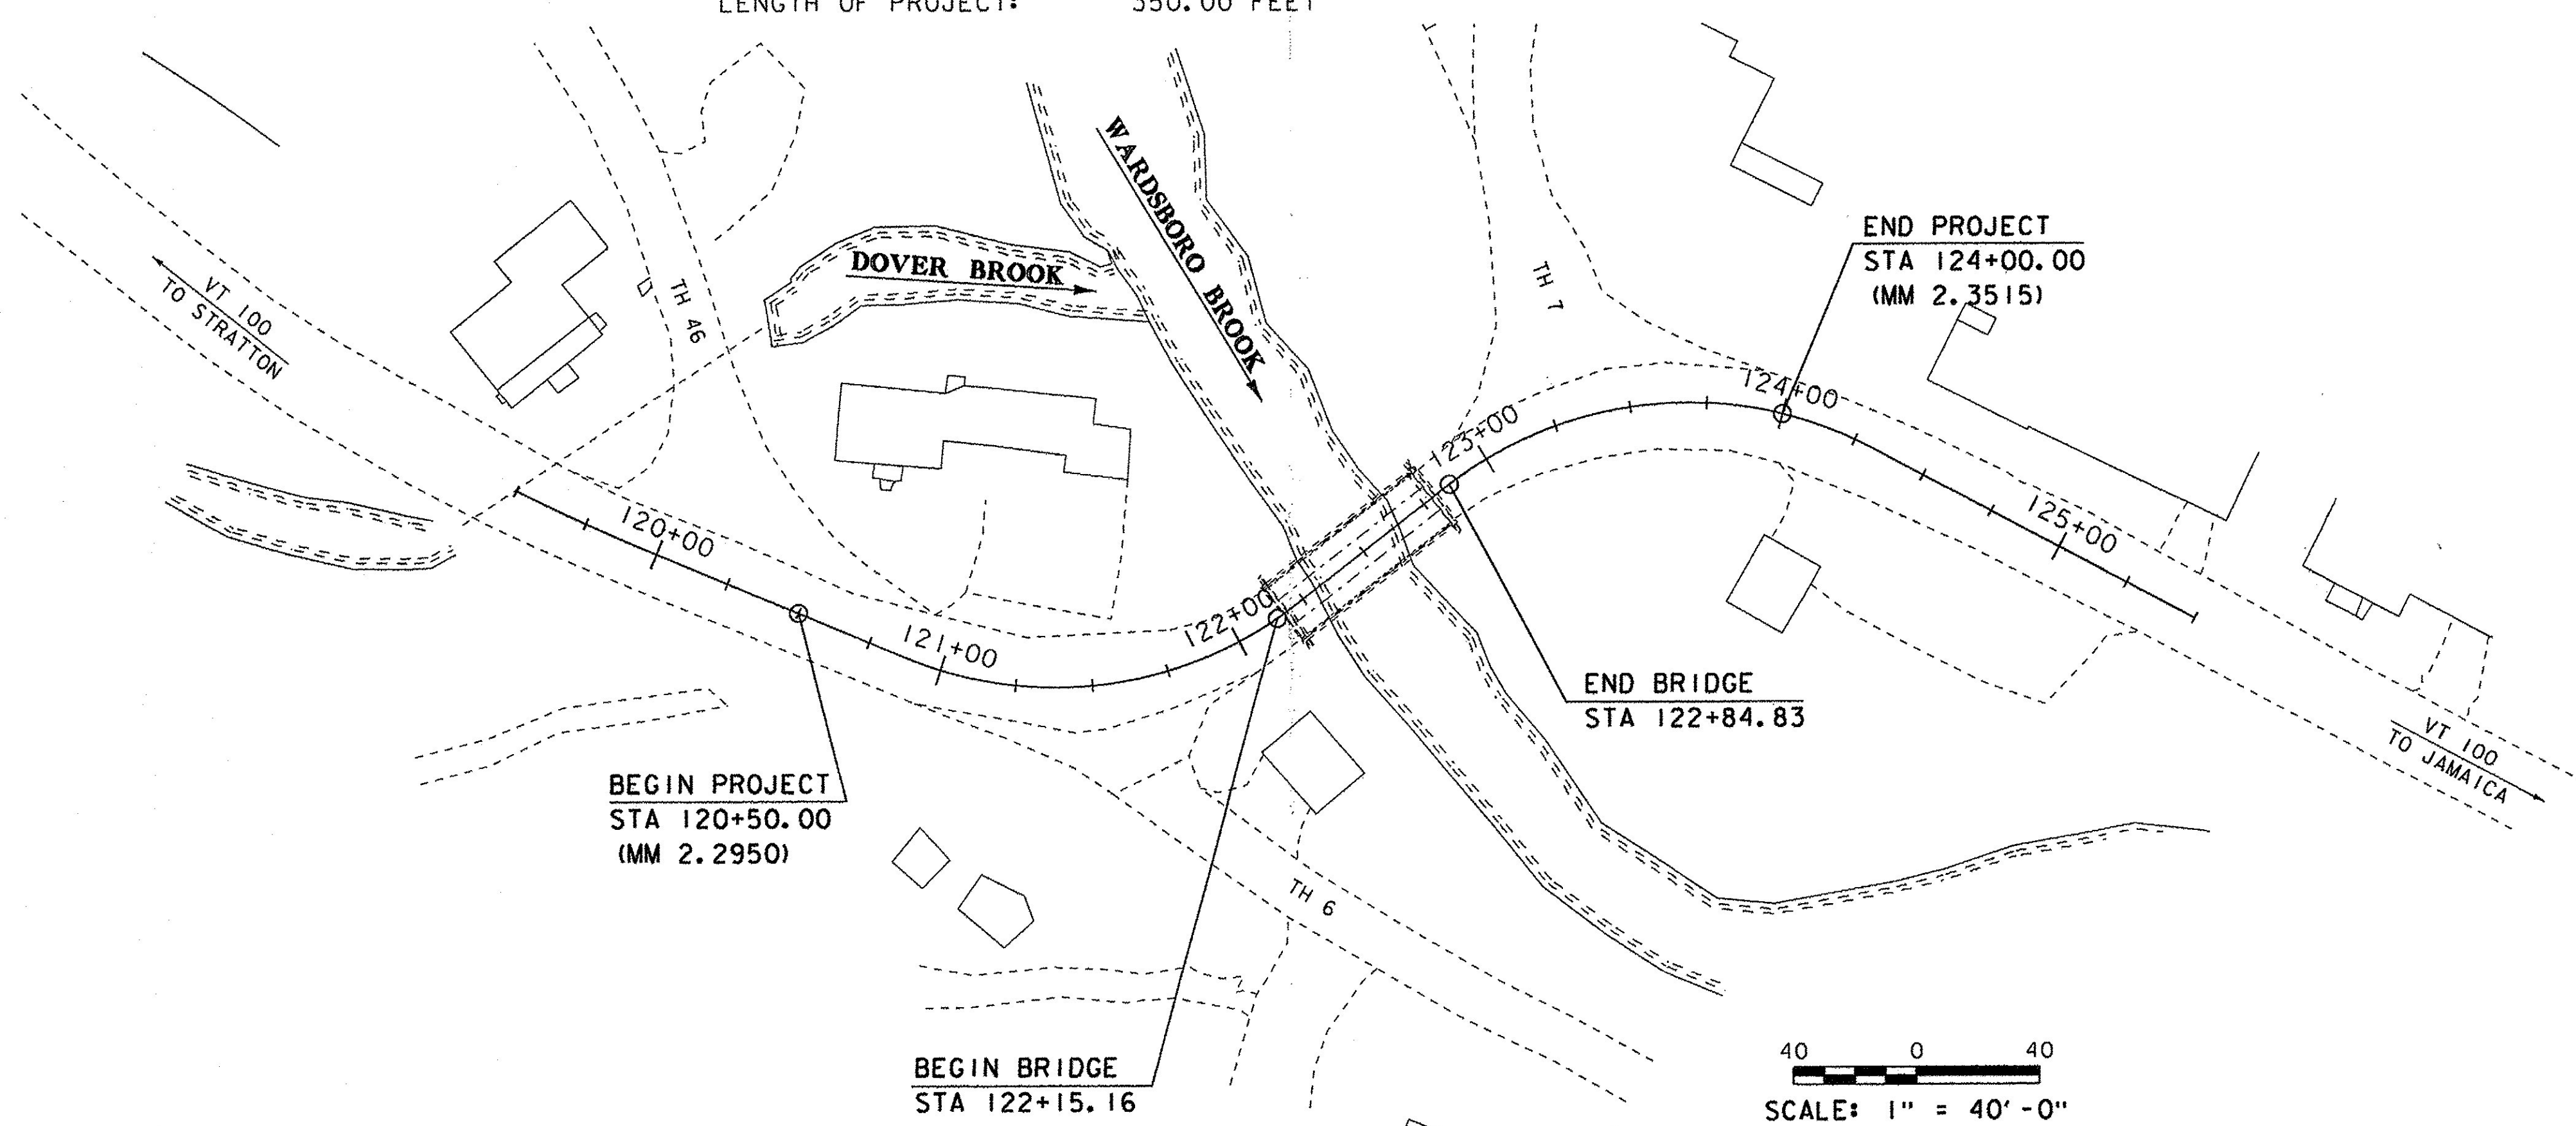

CONSTRUCTION IS TO BE CARRIED ON IN ACCORDANCE WITH THESE PLANS AND THE STANDARD SPECIFICATIONS FOR CONSTRUCTION DATED 2011, AS APPROVED BY THE FEDERAL HIGHWAY ADMINISTRATION ON JULY 20, 2011 FOR USE ON THIS PROJECT, INCLUDING ALL SUBSEQUENT REVISIONS AND SUCH REVISED SPECIFICATIONS AND SPECIAL PROVISIONS AS ARE INCORPORATED IN THESE PLANS.

QUALITY ASSURANCE PROGRAM : LEVEL 2	
SURVEYED BY :	L. ORVIS
SURVEYED DATE :	1-12-2009
DATUM	
VERTICAL	NAVD88
HORIZONTAL	NAD 83 (07)

DIRECTOR OF PROJECT DELIVERY	
APPROVED	DATE 7/14/2015
PROJECT MANAGER : CAROLYN CARLSON, P. E.	
PROJECT NAME : WARDSBORO	
PROJECT NUMBER : BRF 013-1 (15)	
SHEET 1 OF 51 SHEETS	