


BRIDGE TYPICAL SECTION
SCALE: 3/8" = 1'-0"

SEE REVISED SHEET 3B
DATED 10/5/15

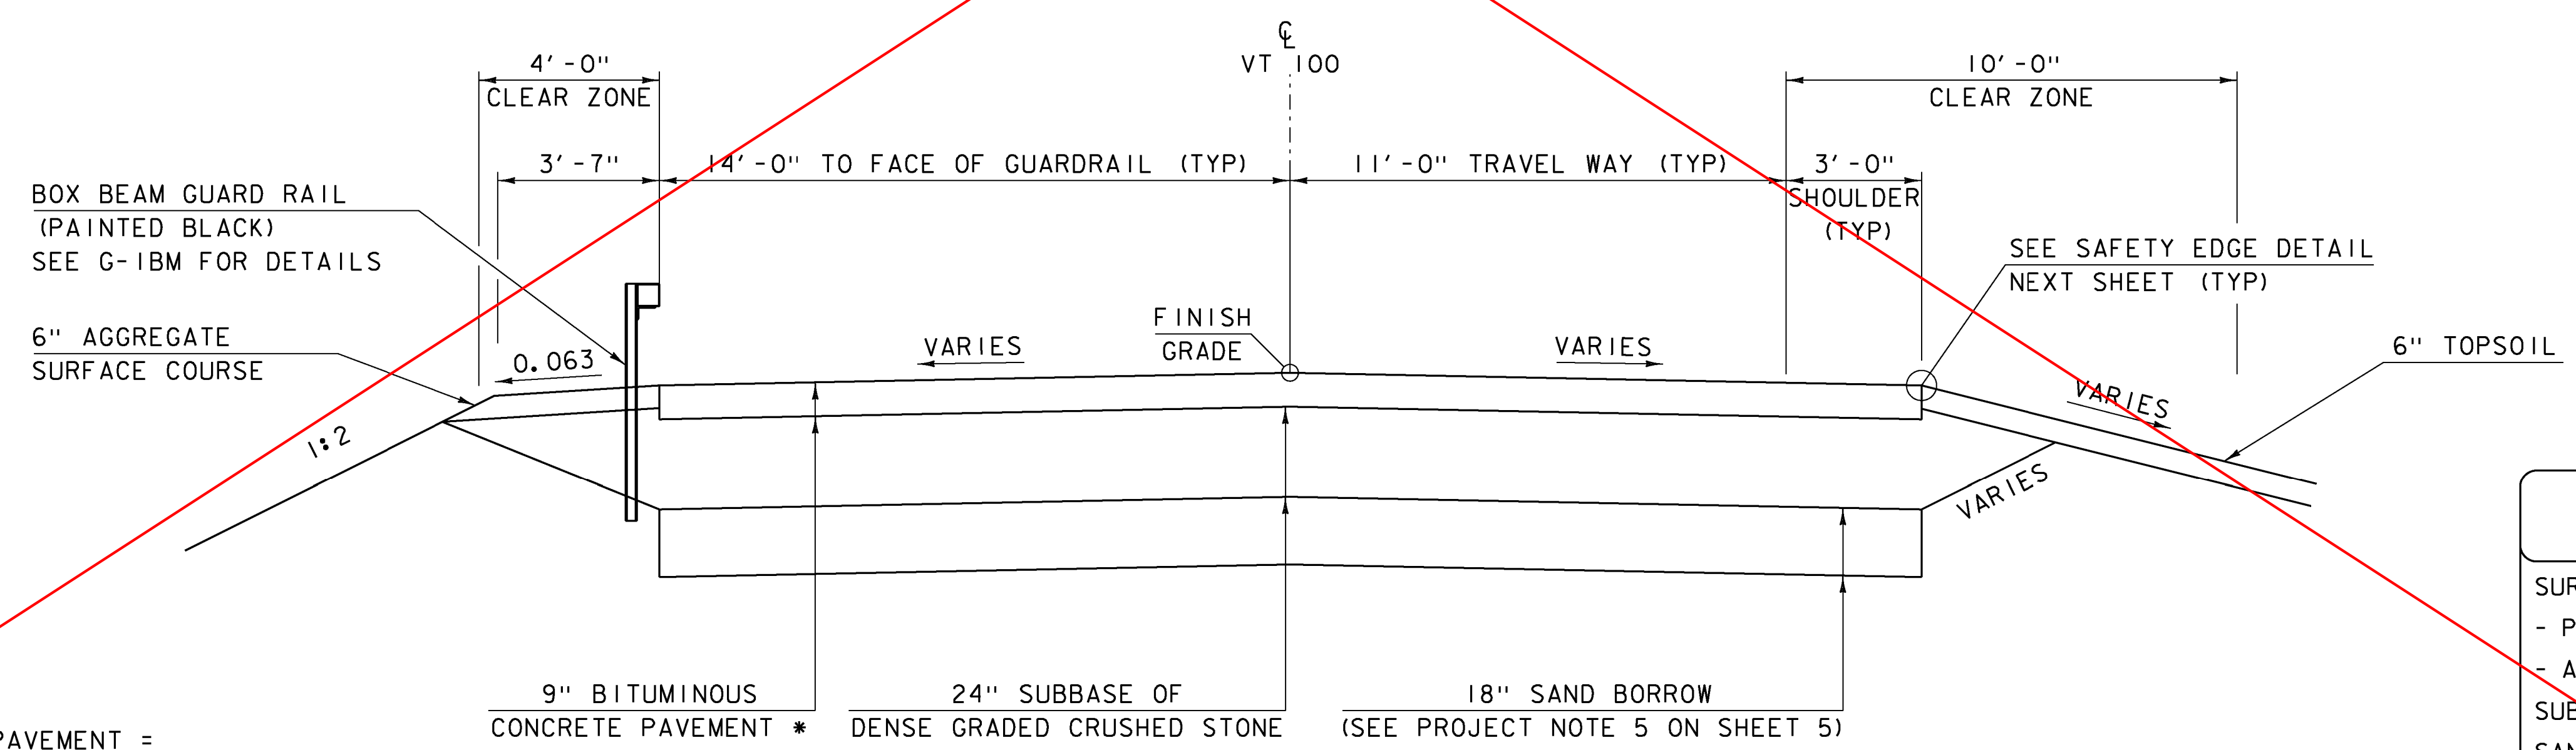

ROADWAY TYPICAL SECTION
SCALE: 3/8" = 1'-0"

MATERIAL TOLERANCES (IF USED ON PROJECT)	
SURFACE	
- PAVEMENT (TOTAL THICKNESS)	+/- 1/4"
- AGGREGATE SURFACE COURSE	+/- 1/2"
SUBBASE	+/- 1"
SAND BORROW	+/- 1"

BITUMINOUS CONCRETE PAVEMENT = SPECIAL PROVISION (BITUMINOUS CONCRETE PAVEMENT, SMALL QUANTITY)

TACK COAT: EMULSIFIED ASPHALT IS TO BE APPLIED AT THE RATE OF 0.025 GAL/SY ON ALL COLD PLANED SURFACES AND BETWEEN SUCCESSIVE COURSES OF PAVEMENT AS DIRECTED BY THE ENGINEER.

WITH GUARDRAIL
* 1 1/2" TYPE IVS
OVER 1 1/2" TYPE IVS
OVER 3" TYPE IIS
OVER 3" TYPE IIS

PROJECT NAME:	WARDSBORO	PLOT DATE:	15-JUL-2015
PROJECT NUMBER:	BRF 013-1(15)	DRAWN BY:	R. PELLETT
FILE NAME:	s92b283+yp.dgn	DESIGNED BY:	D. PETERSON
TYPICAL SECTIONS 1		CHECKED BY:	D. PETERSON
		SHEET	3A OF 51