


DECK PLAN  
SCALE 1/4" = 1'-0"

SEE REVISED SHEET 25B  
DATED 10/5/15

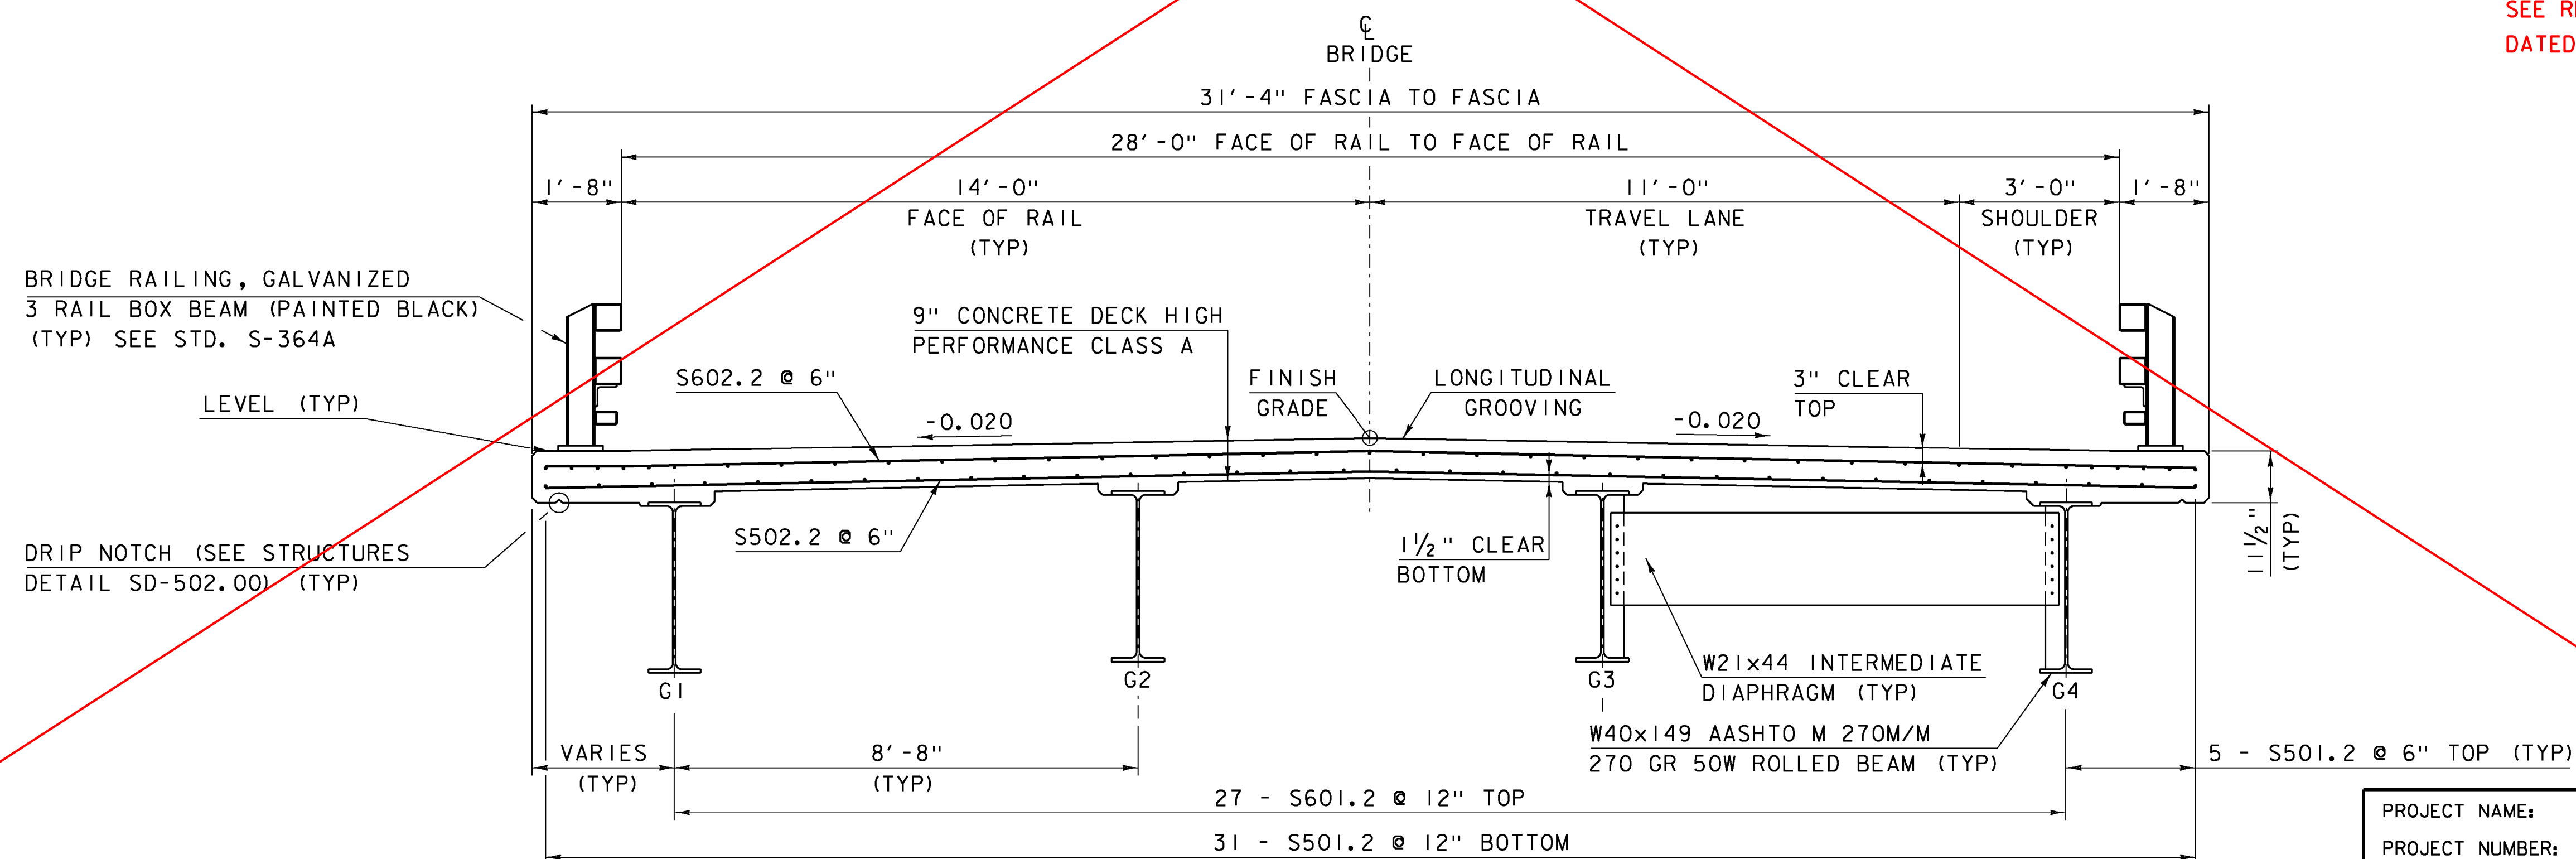

DECK TYPICAL  
SCALE 1/2" = 1'-0"

NOTE:  
NF = NEAR FACE  
FF = FAR FACE  
EF = EACH FACE  
▲ = CUT TO FIT IN FIELD  
3" CLEAR, UNLESS OTHERWISE SPECIFIED ON THE PLANS.  
2'-2" BAR LAP UNLESS OTHERWISE SPECIFIED ON THE PLANS.

|                                 |                |              |             |
|---------------------------------|----------------|--------------|-------------|
| PROJECT NAME:                   | WARDSBORO      | PLOT DATE:   | 15-JUL-2015 |
| PROJECT NUMBER:                 | BRF 013-1(15)  | DRAWN BY:    | R. PELLETT  |
| FILE NAME:                      | s92b283sup.dgn | DESIGNED BY: | D. PETERSON |
| PROJECT LEADER:                 | C. CARLSON     | CHECKED BY:  | D. PETERSON |
| DECK REINFORCING PLAN & TYPICAL |                | SHEET        | 25A OF 51   |