



**DECK FRAMING PLAN**

SCALE 1/4" = 1'-0"

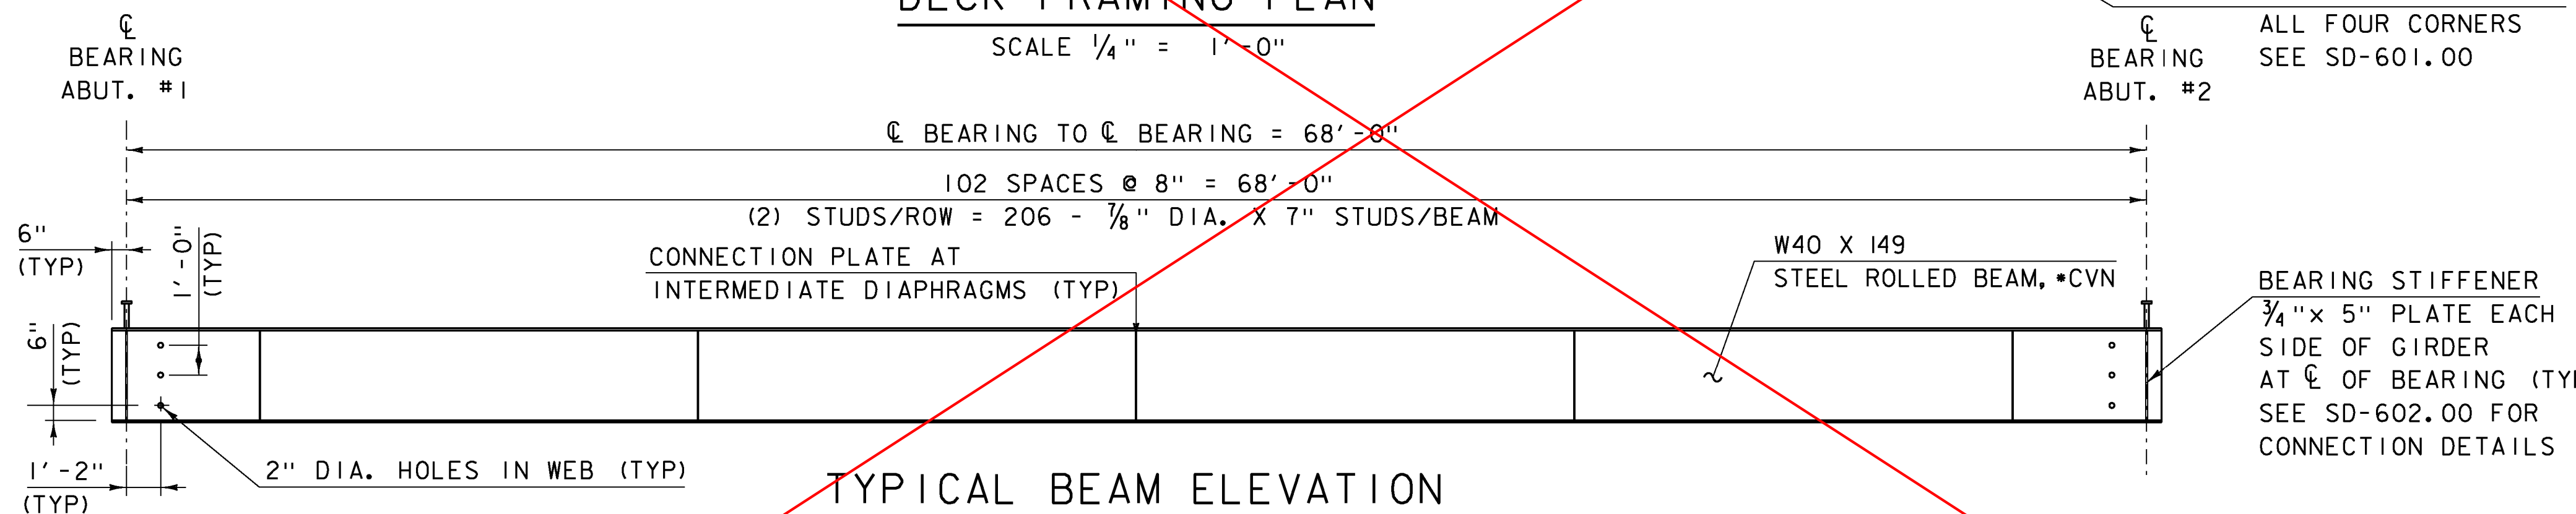


**TYPICAL BEAM ELEVATION**

SCALE 1/4" = 1'-0"

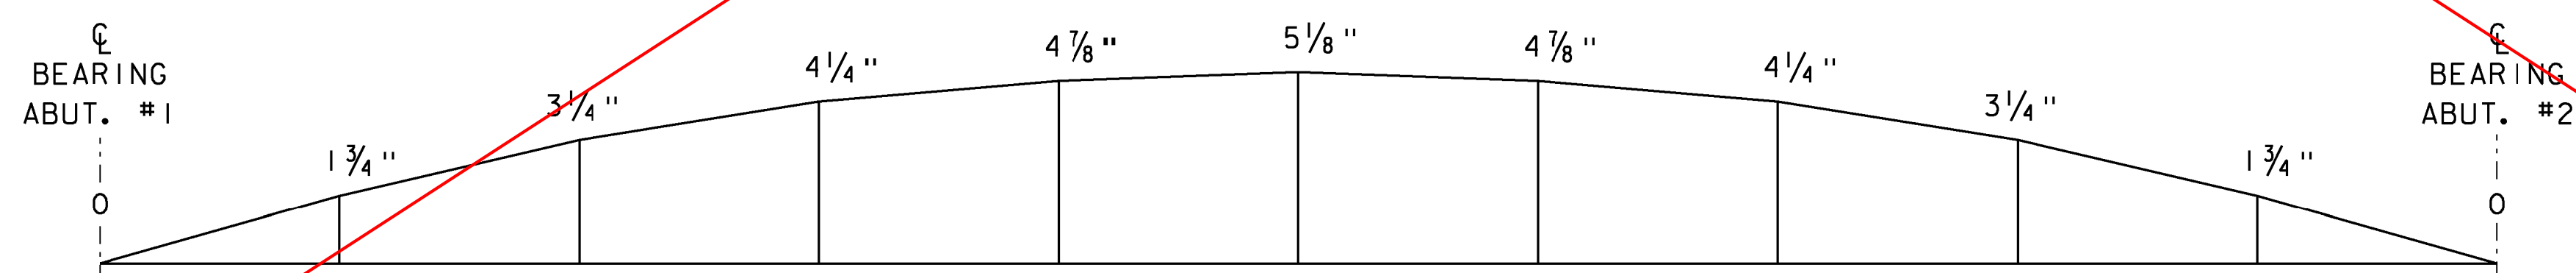

**CAMBER DIAGRAM**

NOT TO SCALE

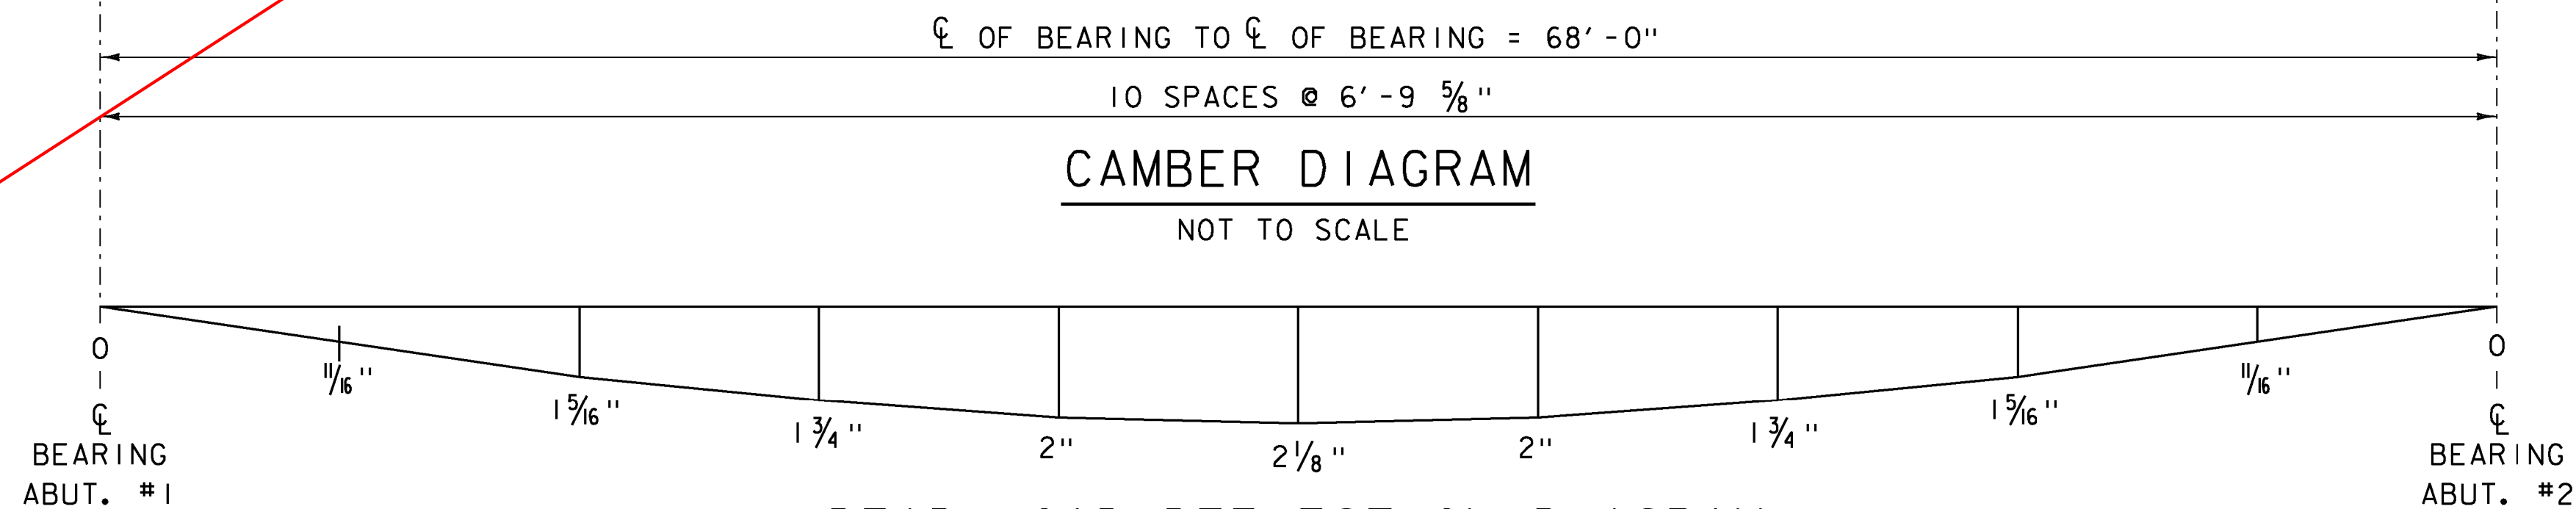

**DEAD LOAD DEFLECTION DIAGRAM**

NOT TO SCALE

SEE REVISED SHEET 26B  
DATED 10/5/15

NOTE:  
\*CVN - SHALL MEET CHARPY V-NOTCH REQUIREMENTS FOR MAIN MEMBERS AS INDICATED IN SECTION 714 OF THE STANDARD SPECIFICATION.  
DEAD LOAD DEFLECTION INCLUDES: BEAM, DIAPHRAGMS, DECK & BRIDGE RAIL.

PROJECT NAME:	WARDSBORO	PLOT DATE:	15-JUL-2015
PROJECT NUMBER:	BRF 013-1(15)	DRAWN BY:	D. KARABEGOVIC
FILE NAME:	s92b283sup.dgn	DESIGNED BY:	D. PETERSON
		CHECKED BY:	D. PETERSON
		DECK FRAMING PLAN	SHEET 26A OF 51