




123+75

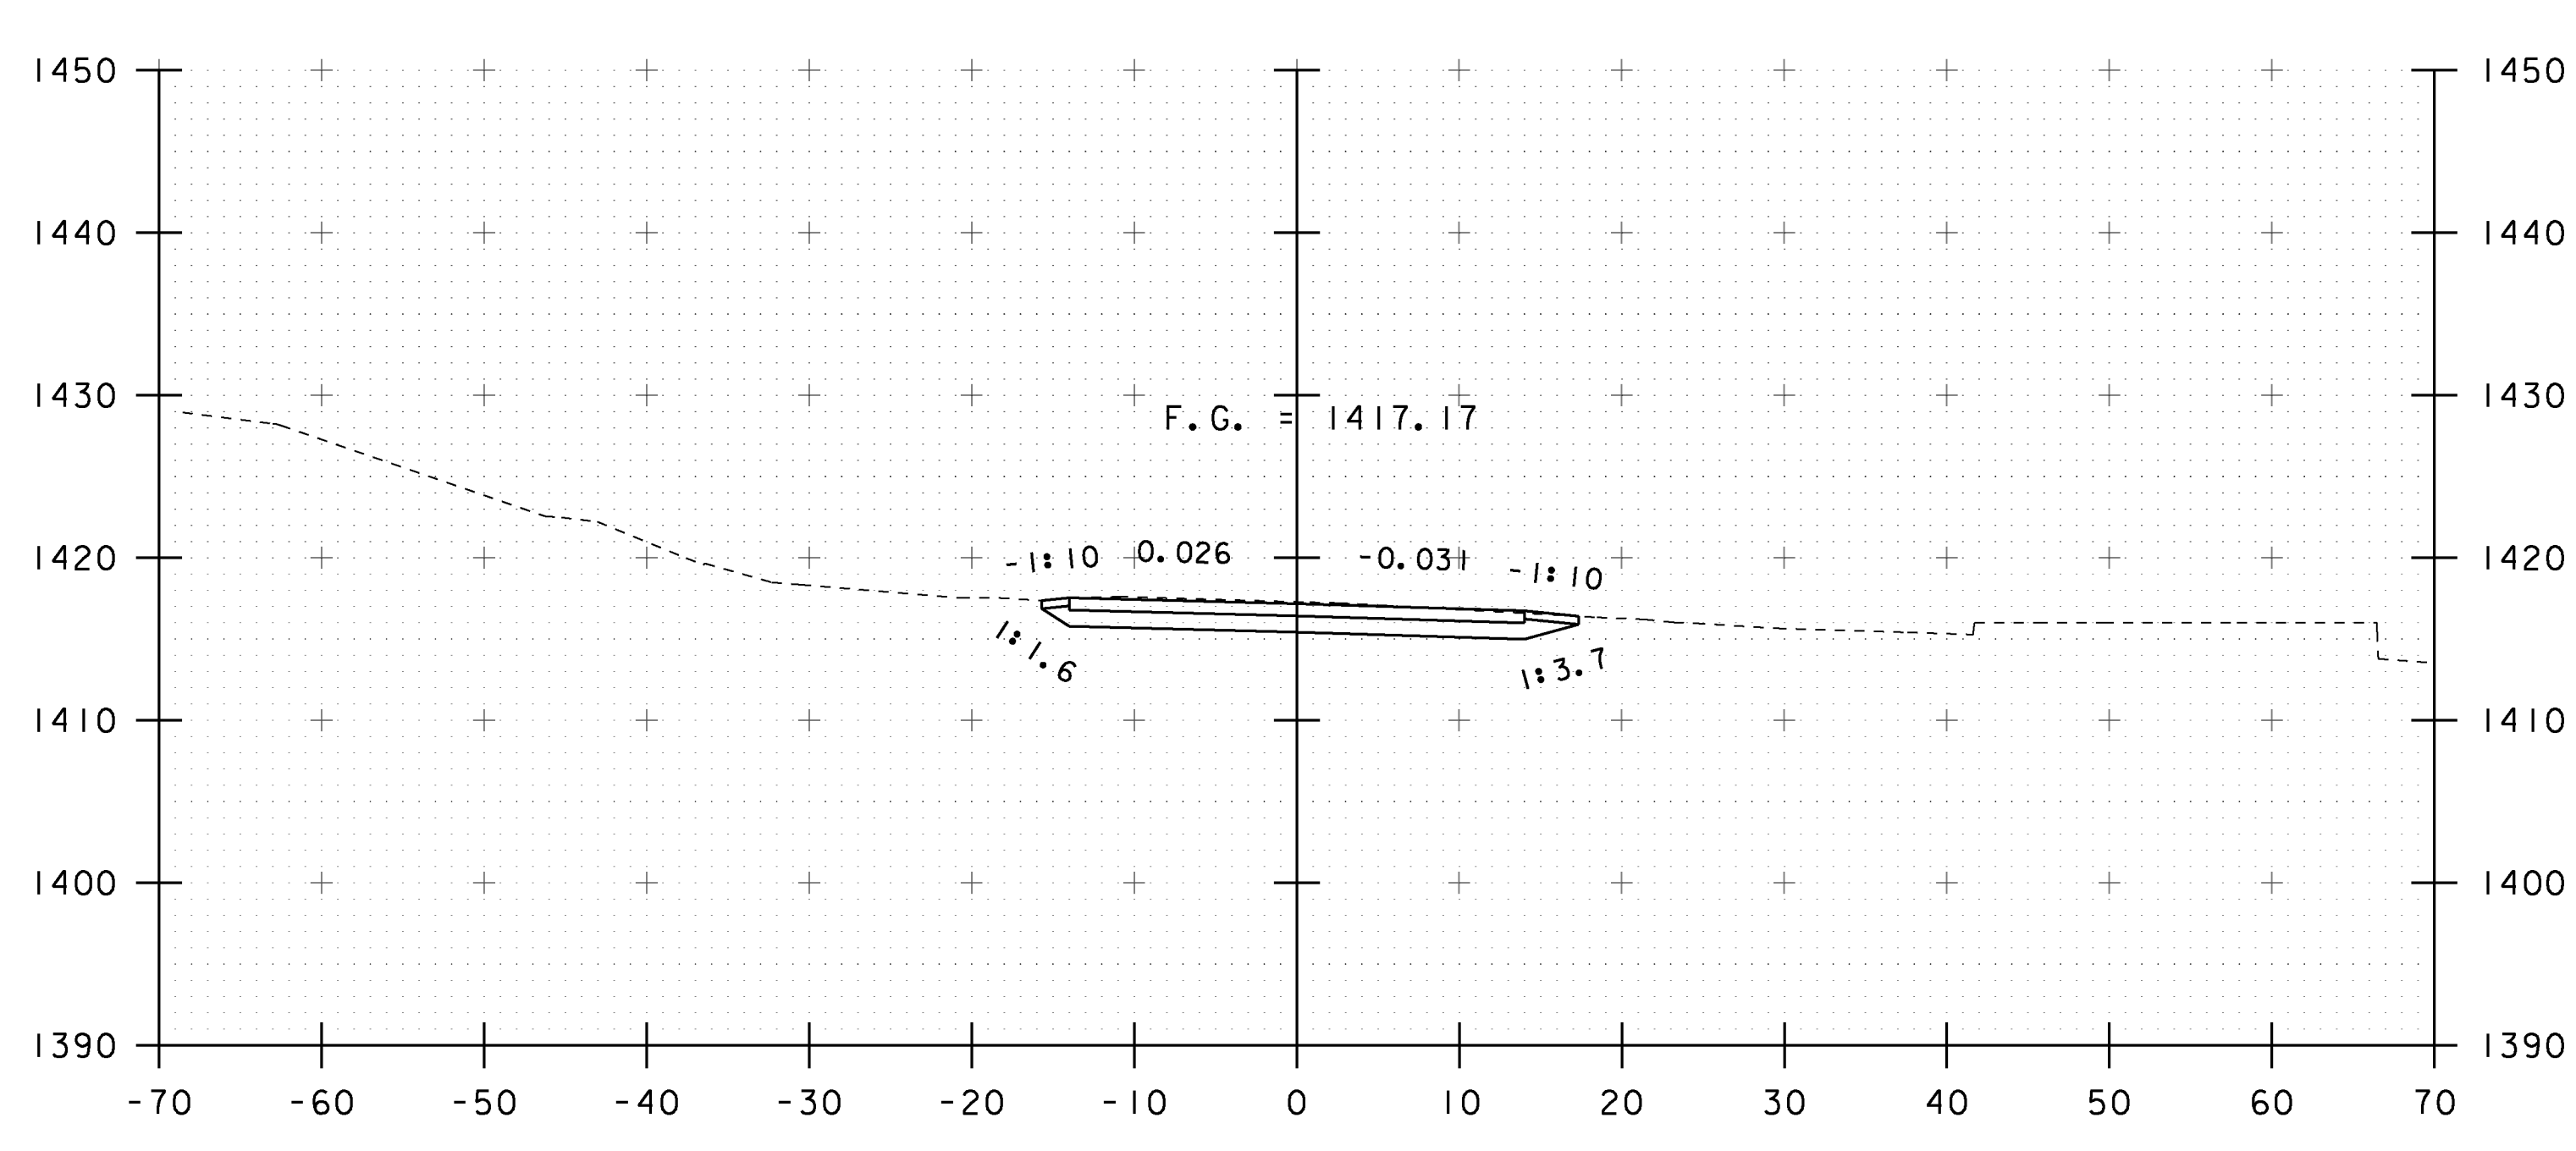

124+25

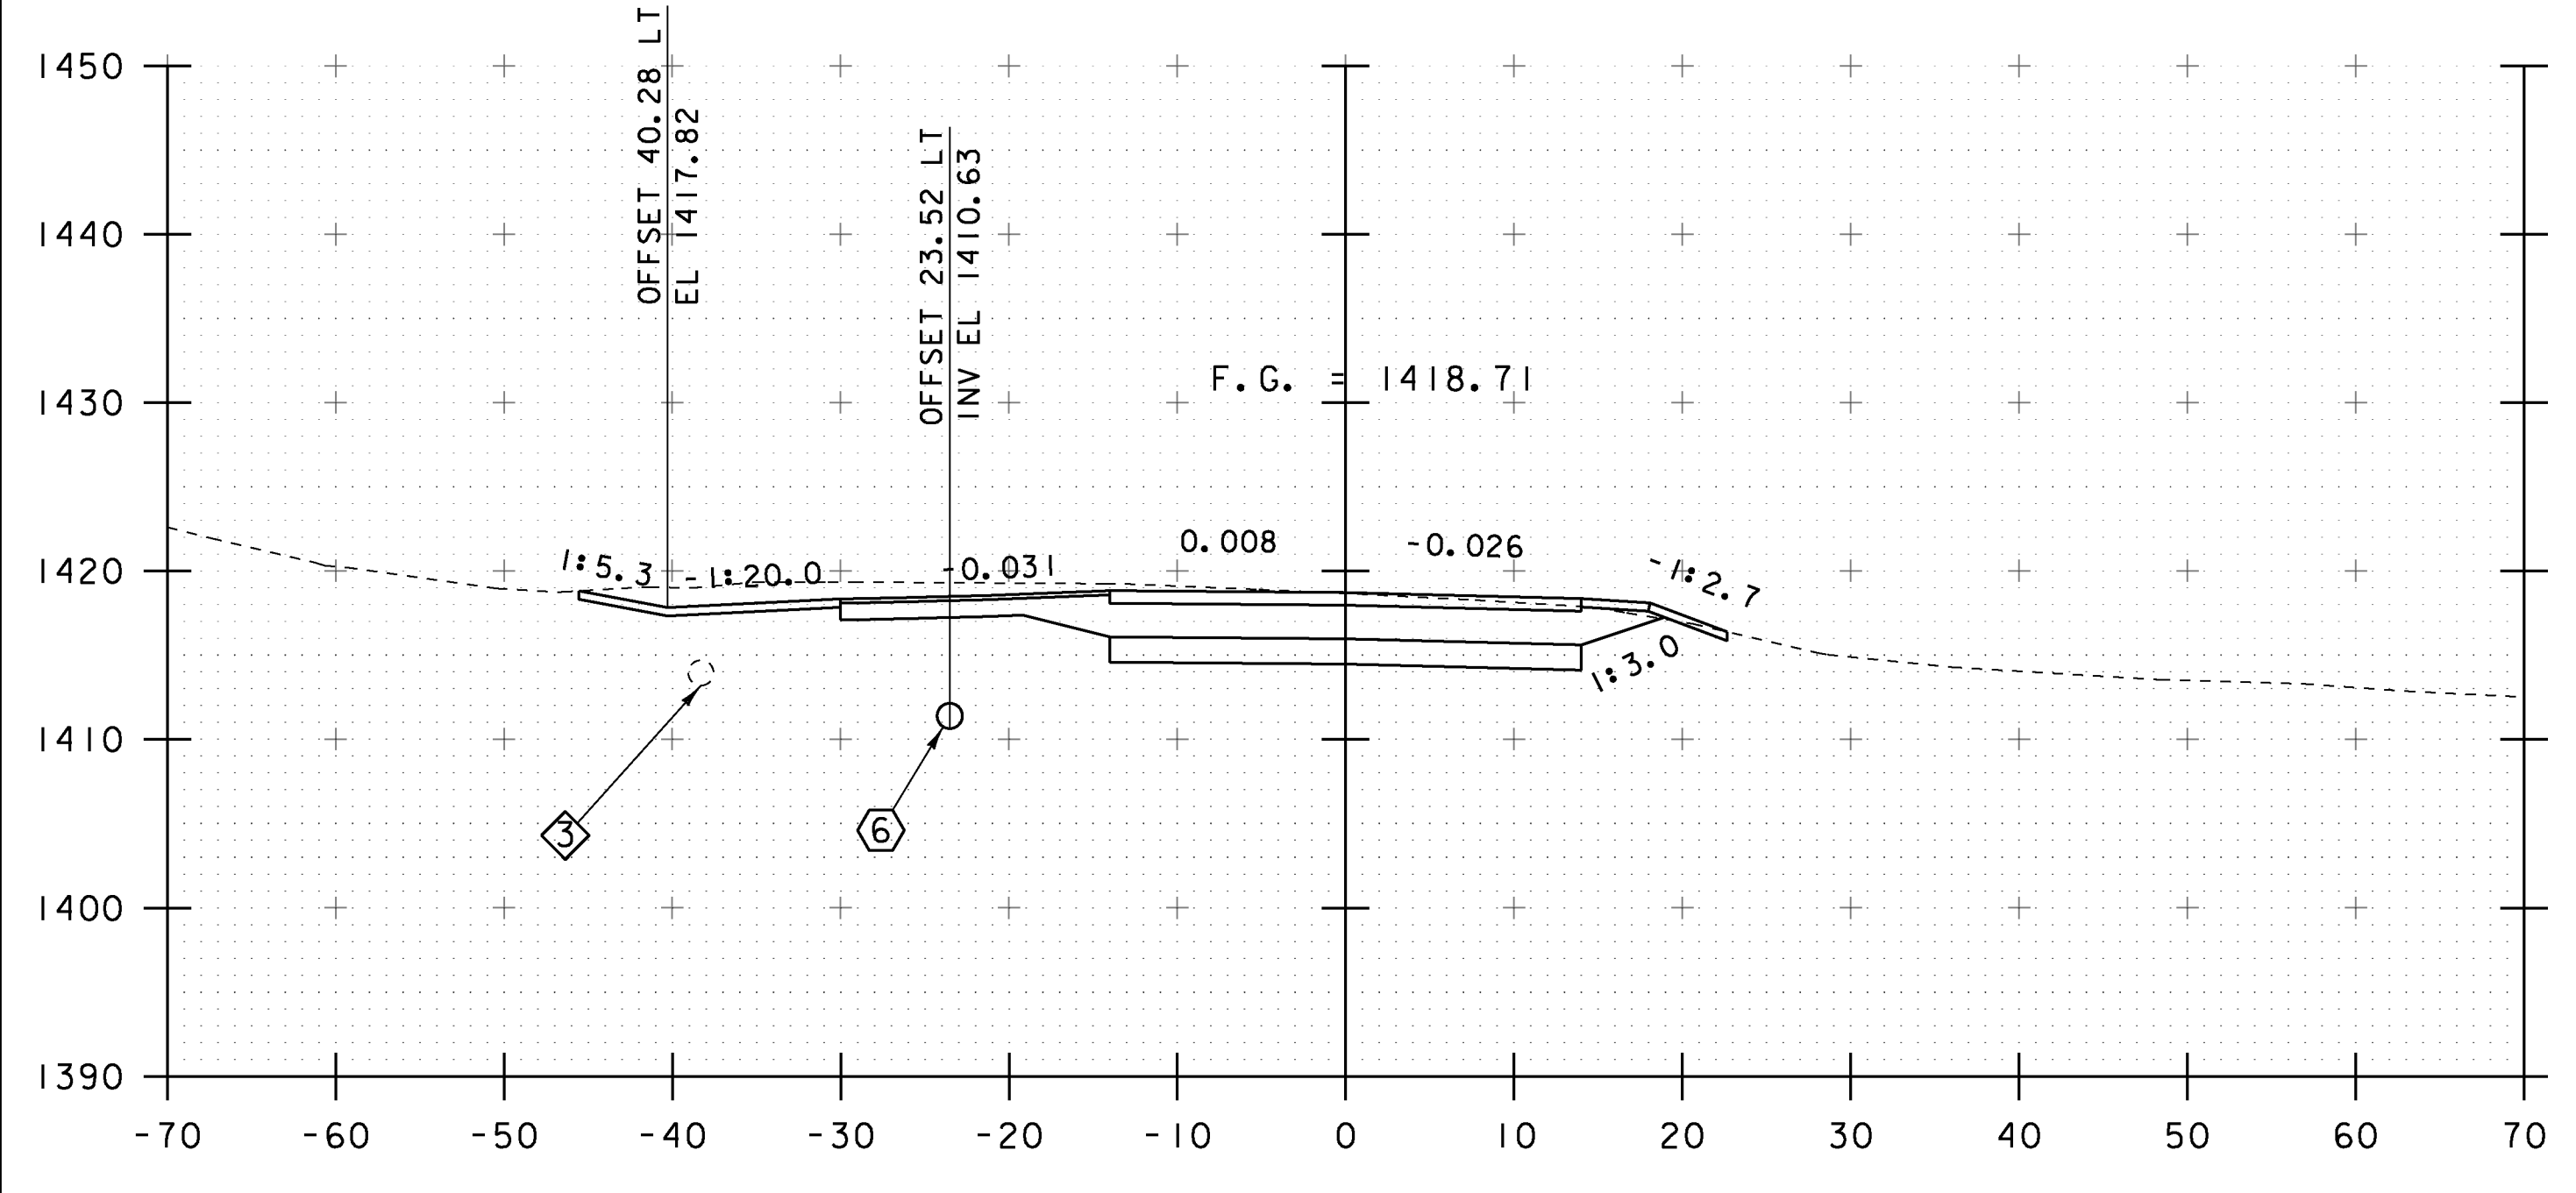

123+50

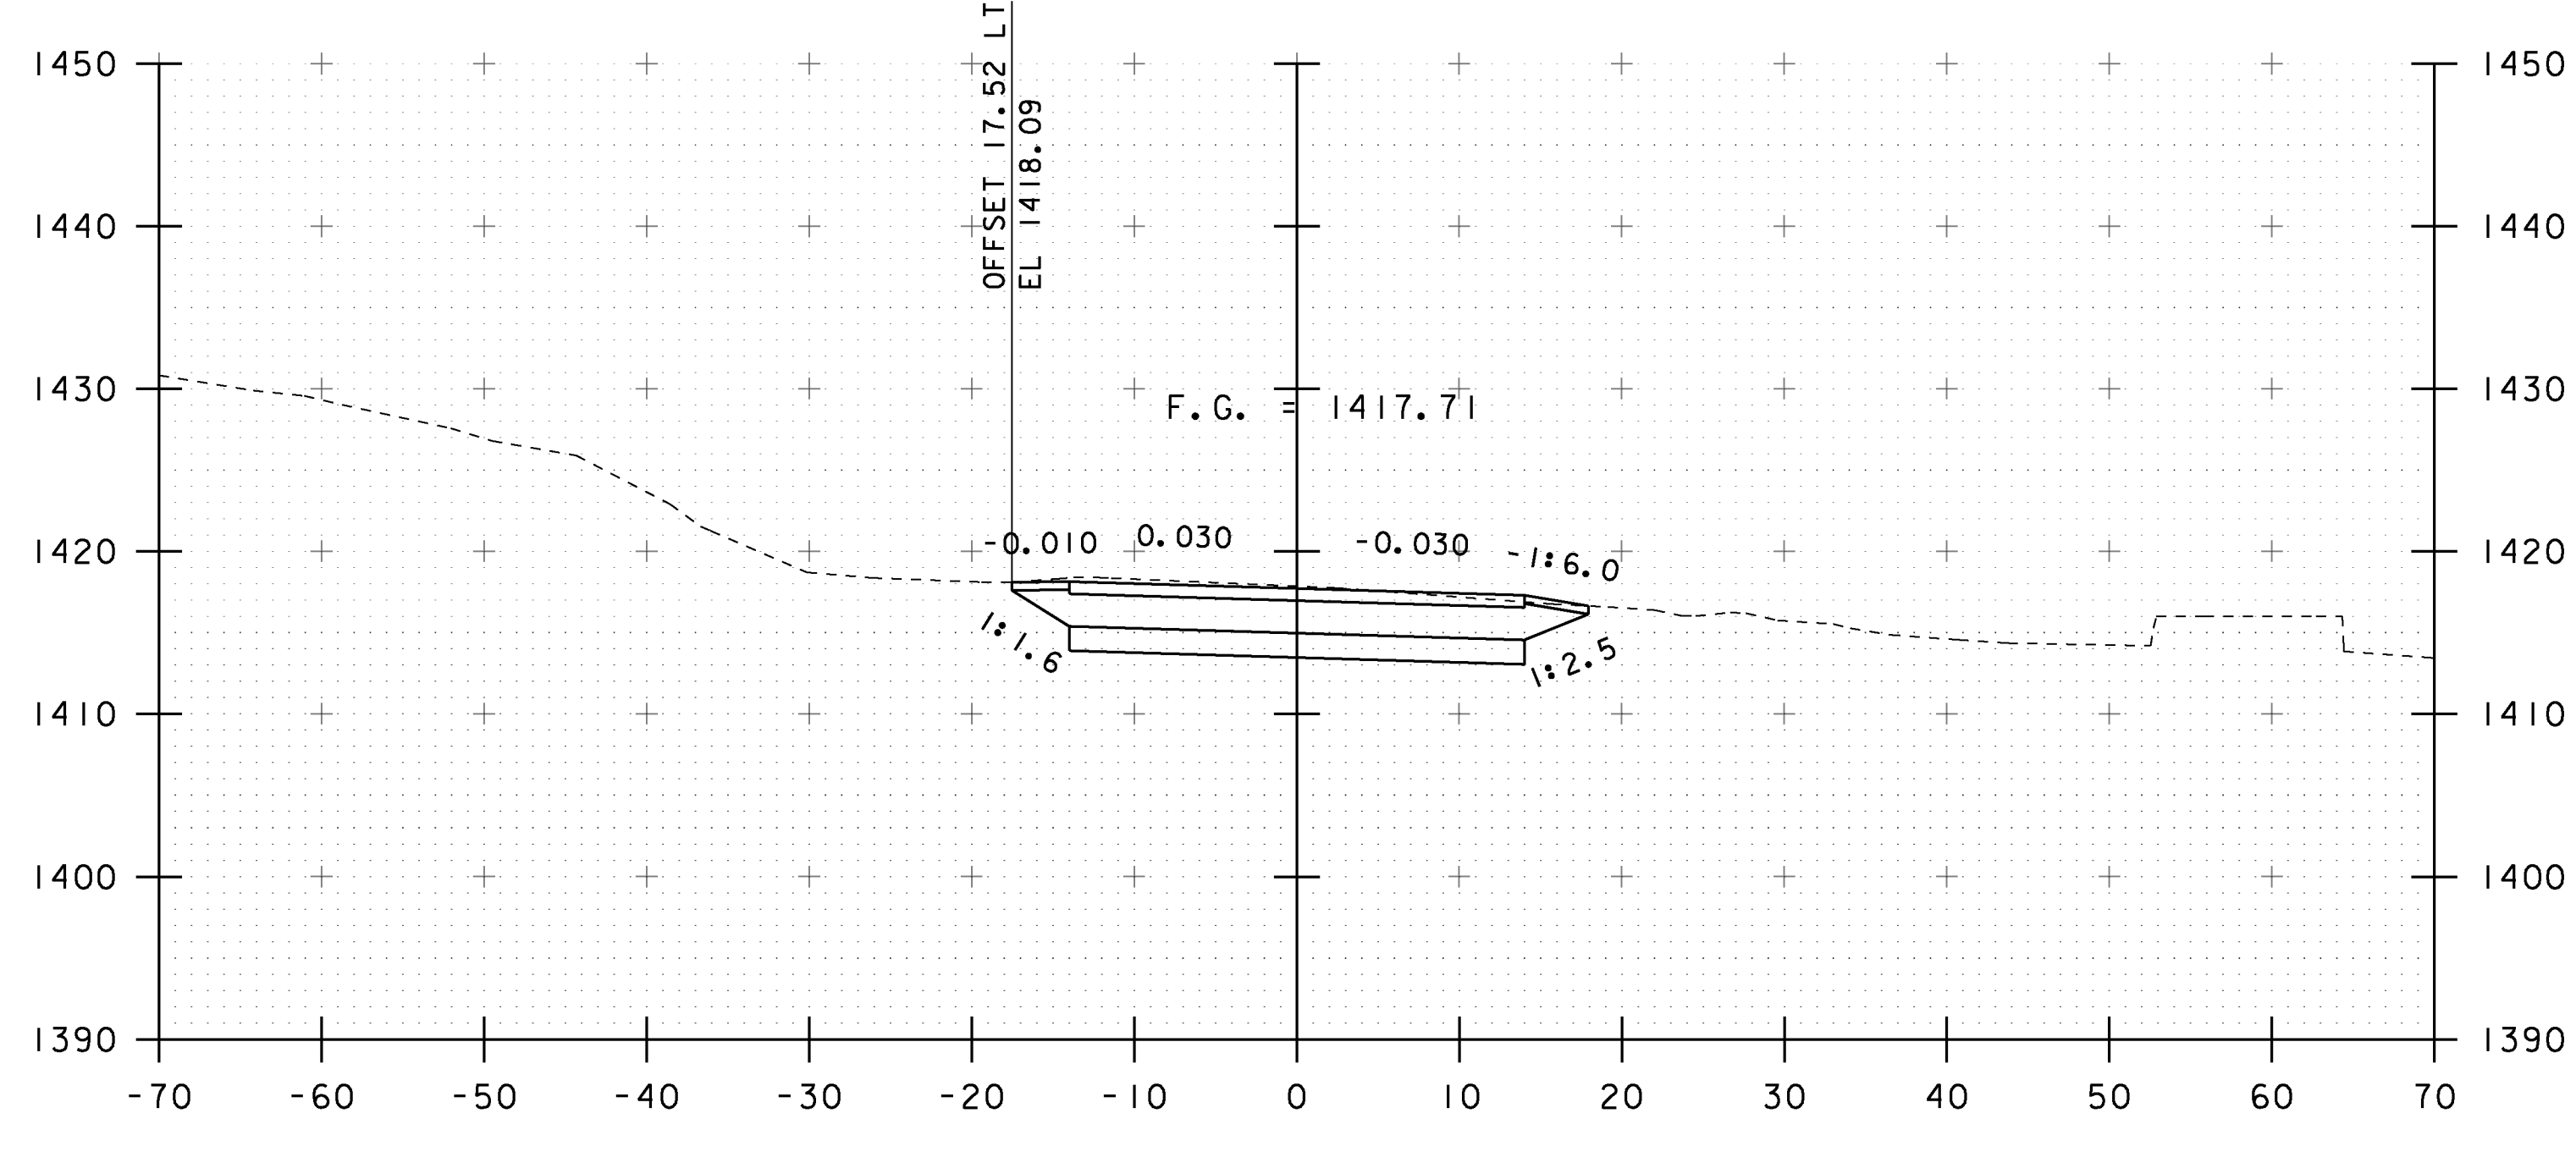

END PROJECT 124+00

STA. 123+50 TO STA. 124+25

PROJECT NAME:	WARDSBORO	PLOT DATE:	15-JUL-2015
PROJECT NUMBER:	BRF 013-1(15)	DRAWN BY:	J. GRIFFIN
FILE NAME:	s92b283xsl.dgn	CHECKED BY:	D. PETERSON
PROJECT LEADER:	C. CARLSON	SHEET	36 OF 51
DESIGNED BY:	J. GRIFFIN		
VT 100 CROSS SECTIONS	5		