


BANKING DIAGRAM
 HORIZONTAL SCALE 1" = 20'-0"
 NO VERTICAL SCALE

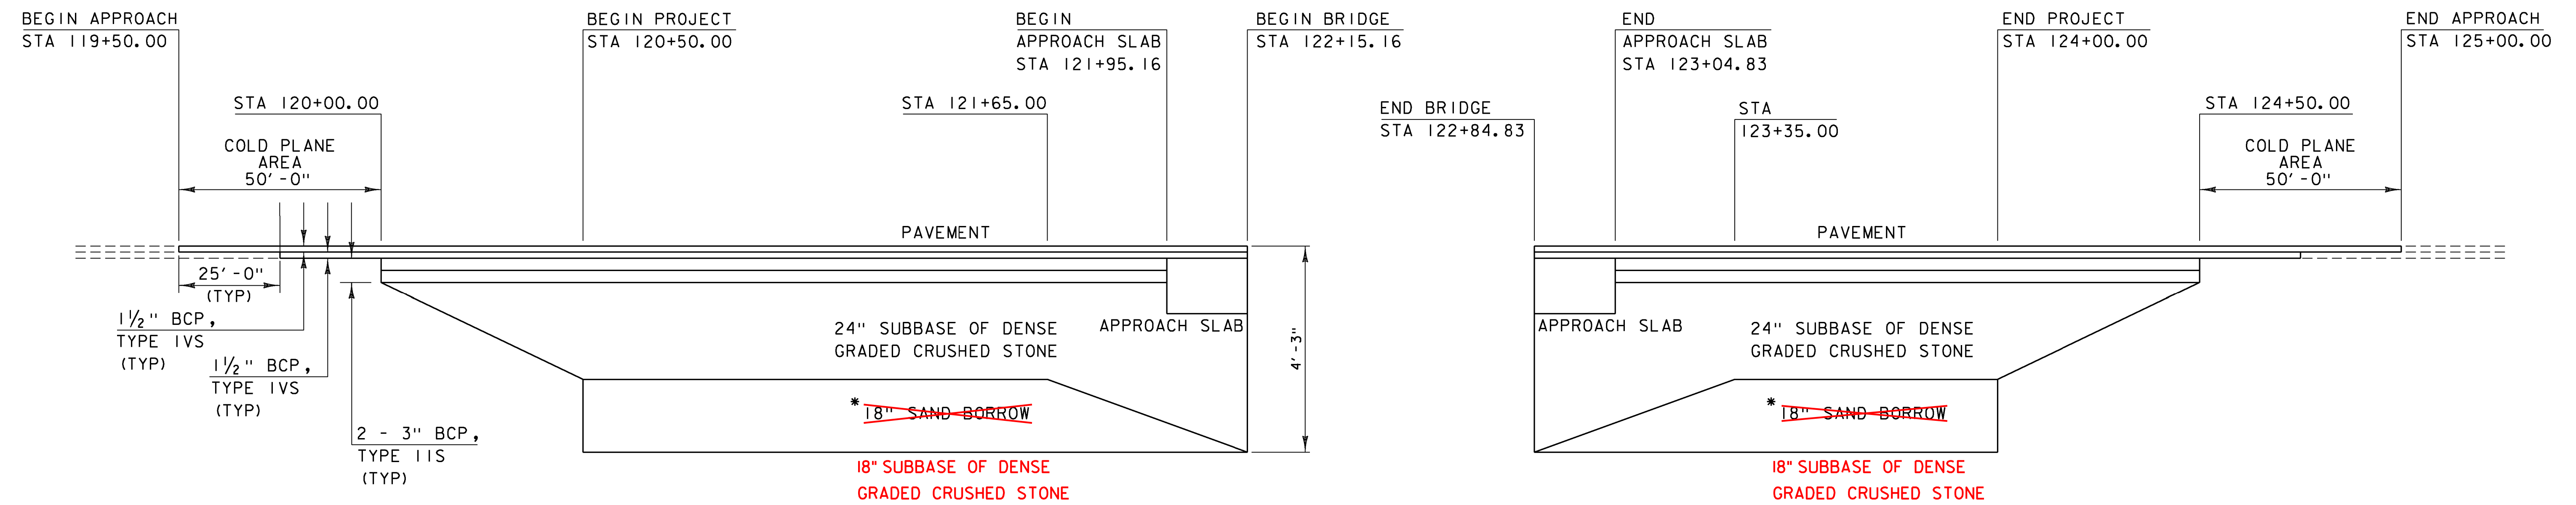

MATERIAL TRANSITION
 HORIZONTAL SCALE 1" = 20'-0"
 NO VERTICAL SCALE

*SEE PROJECT NOTE 5 ON SHEET 5

| | | | |
|-----------------|----------------|-------------------------------|-------------|
| PROJECT NAME: | WARDSBORO | PLOT DATE: | 15-JUL-2015 |
| PROJECT NUMBER: | BRF 013-1(15) | DRAWN BY: | R. PELLETT |
| FILE NAME: | s92b283xsl.dgn | CHECKED BY: | D. PETERSON |
| PROJECT LEADER: | C. CARLSON | SHEET | 38 OF 51 |
| DESIGNED BY: | D. PETERSON | BANKING / MATERIAL TRANSITION | |