




10+25

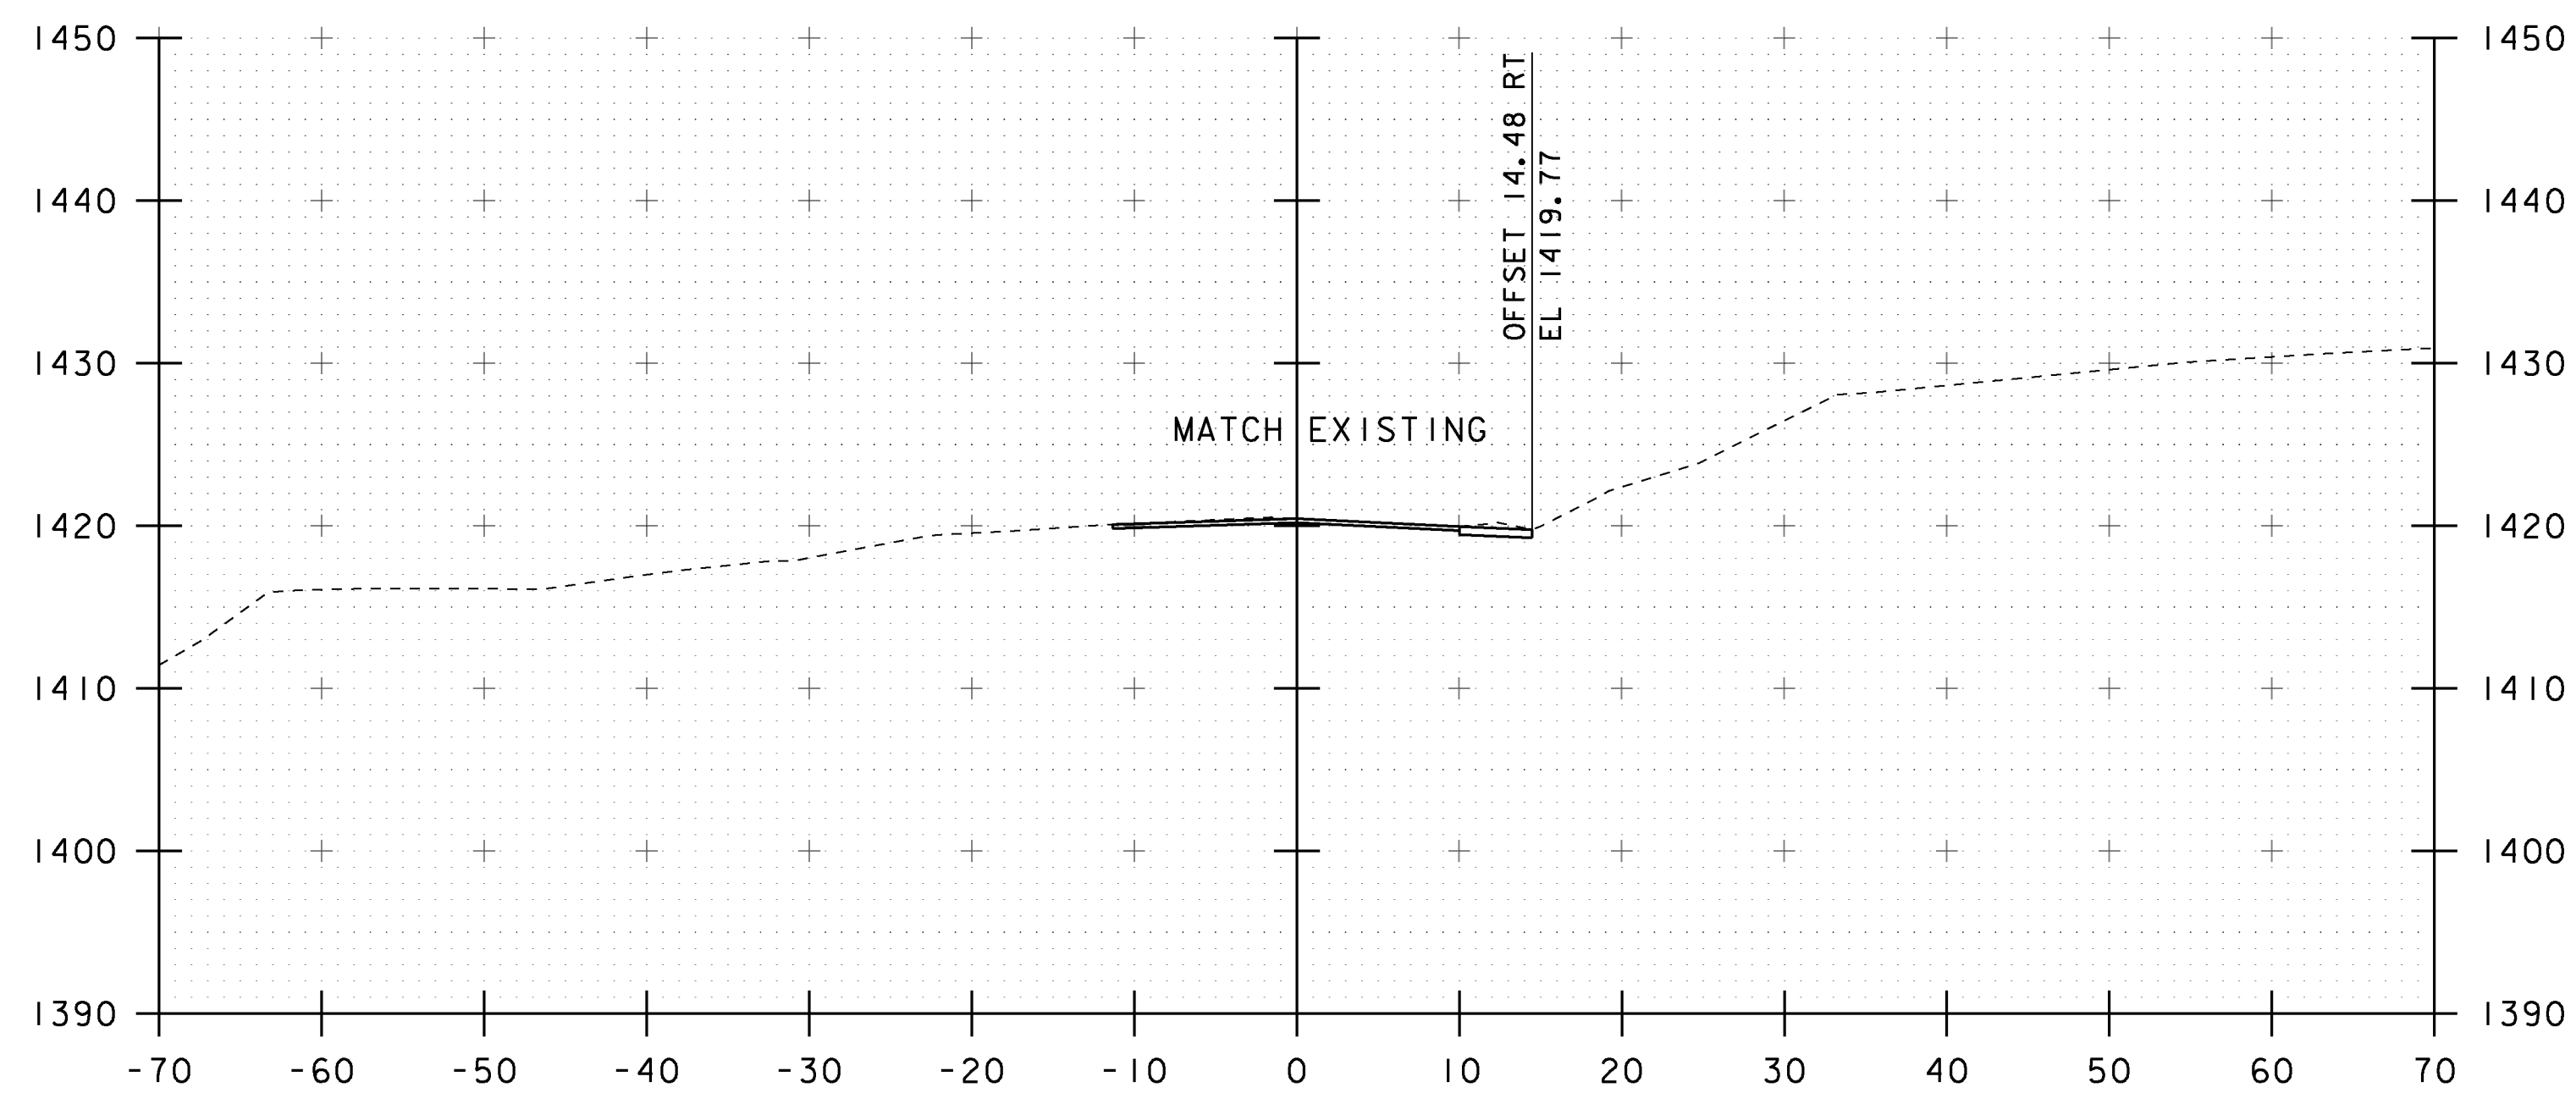

10+75

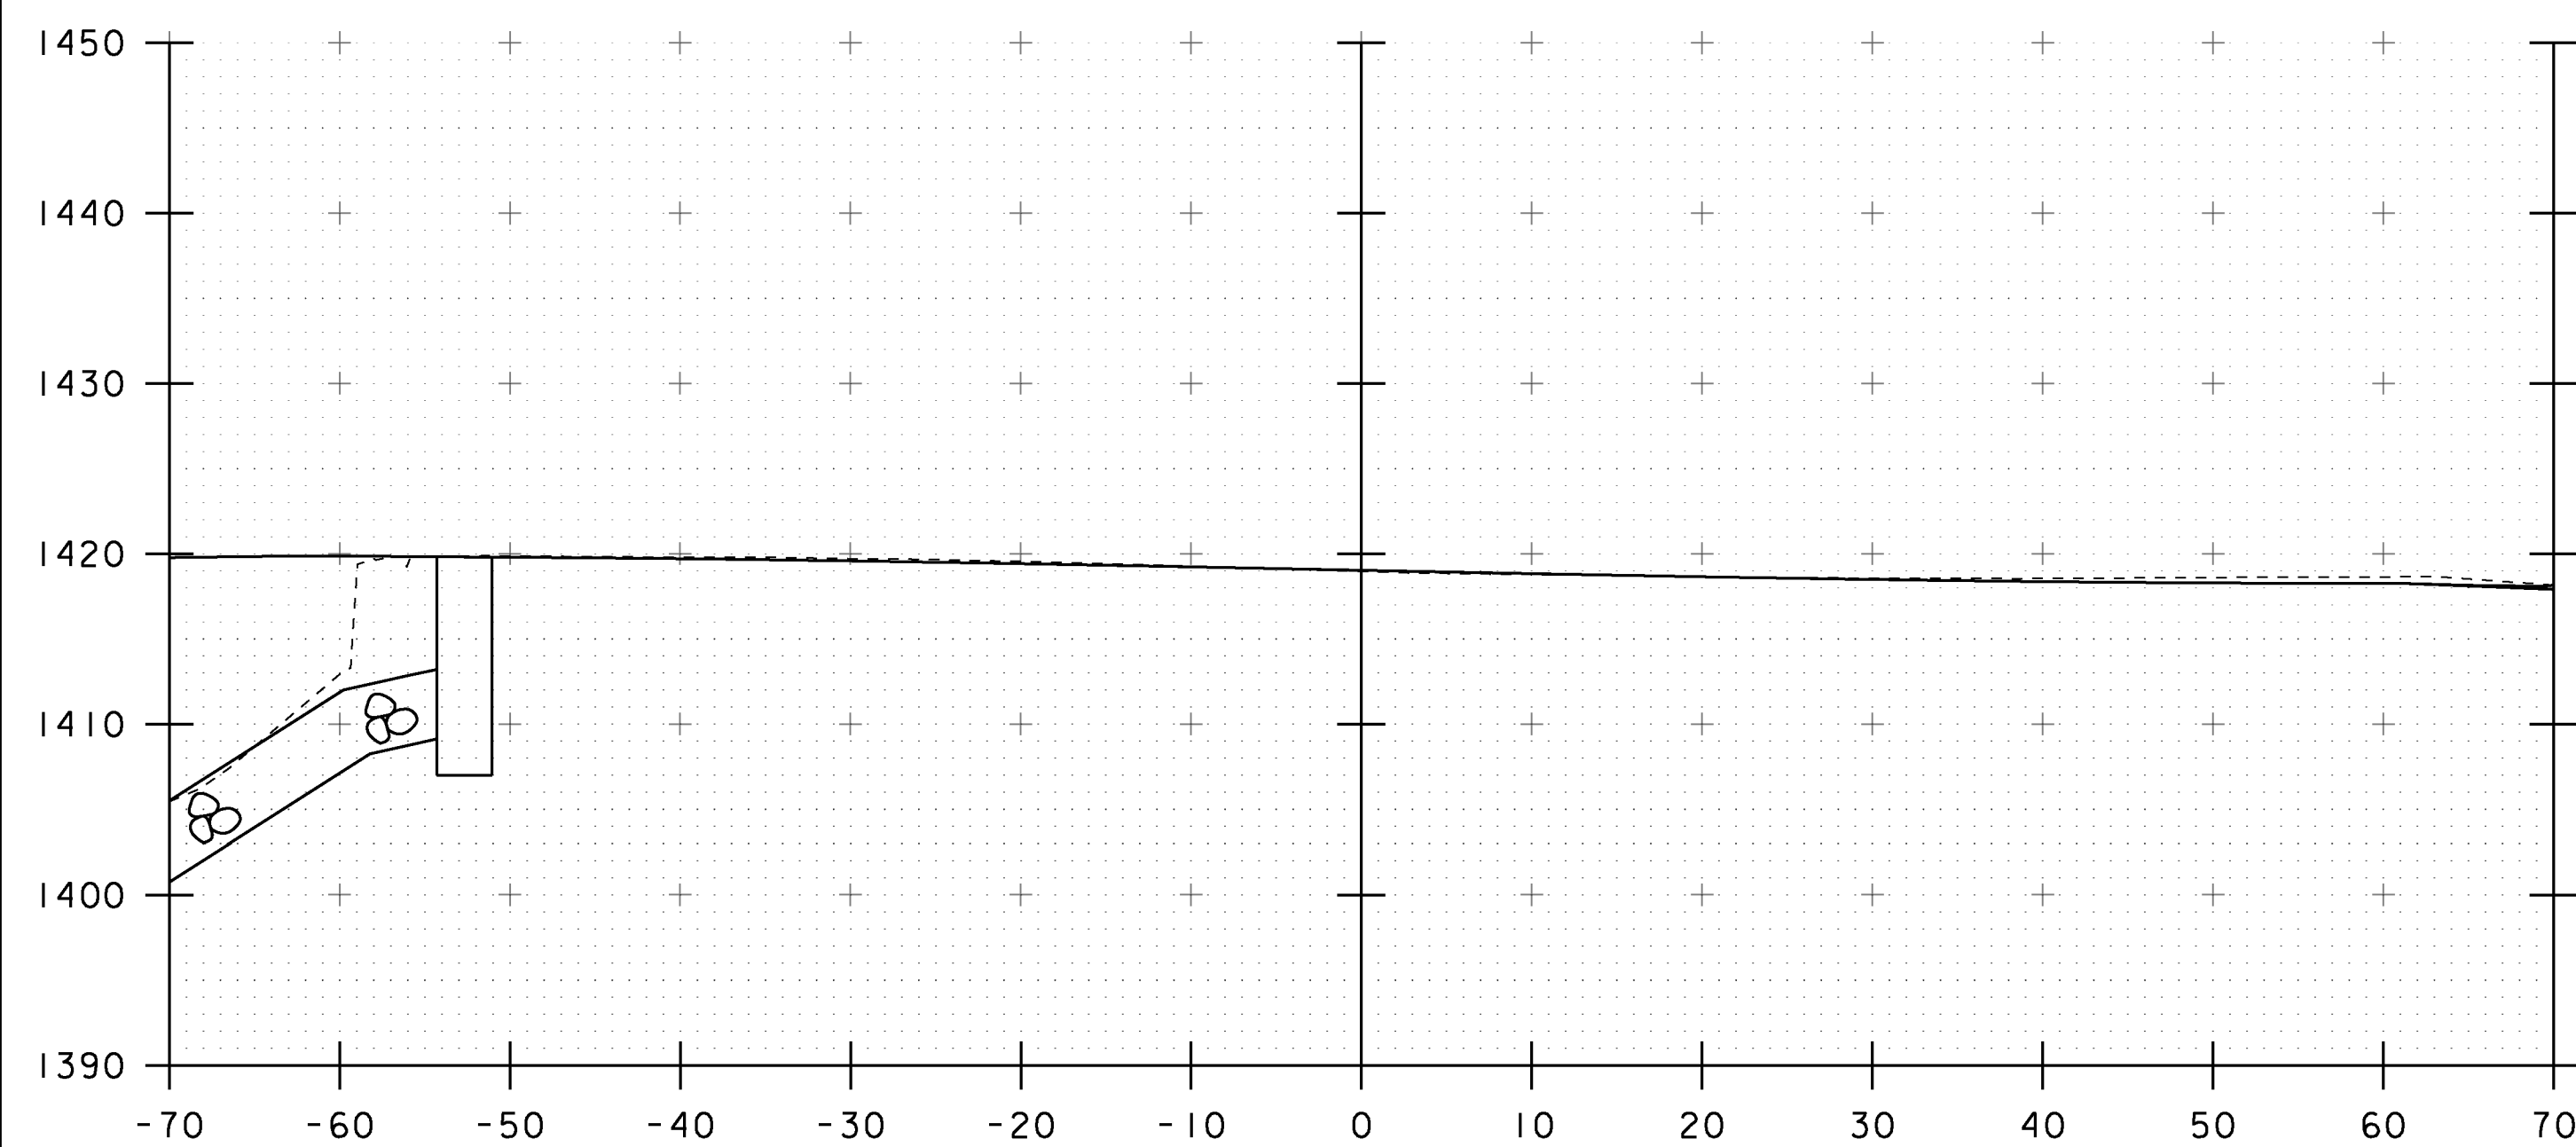

10+00

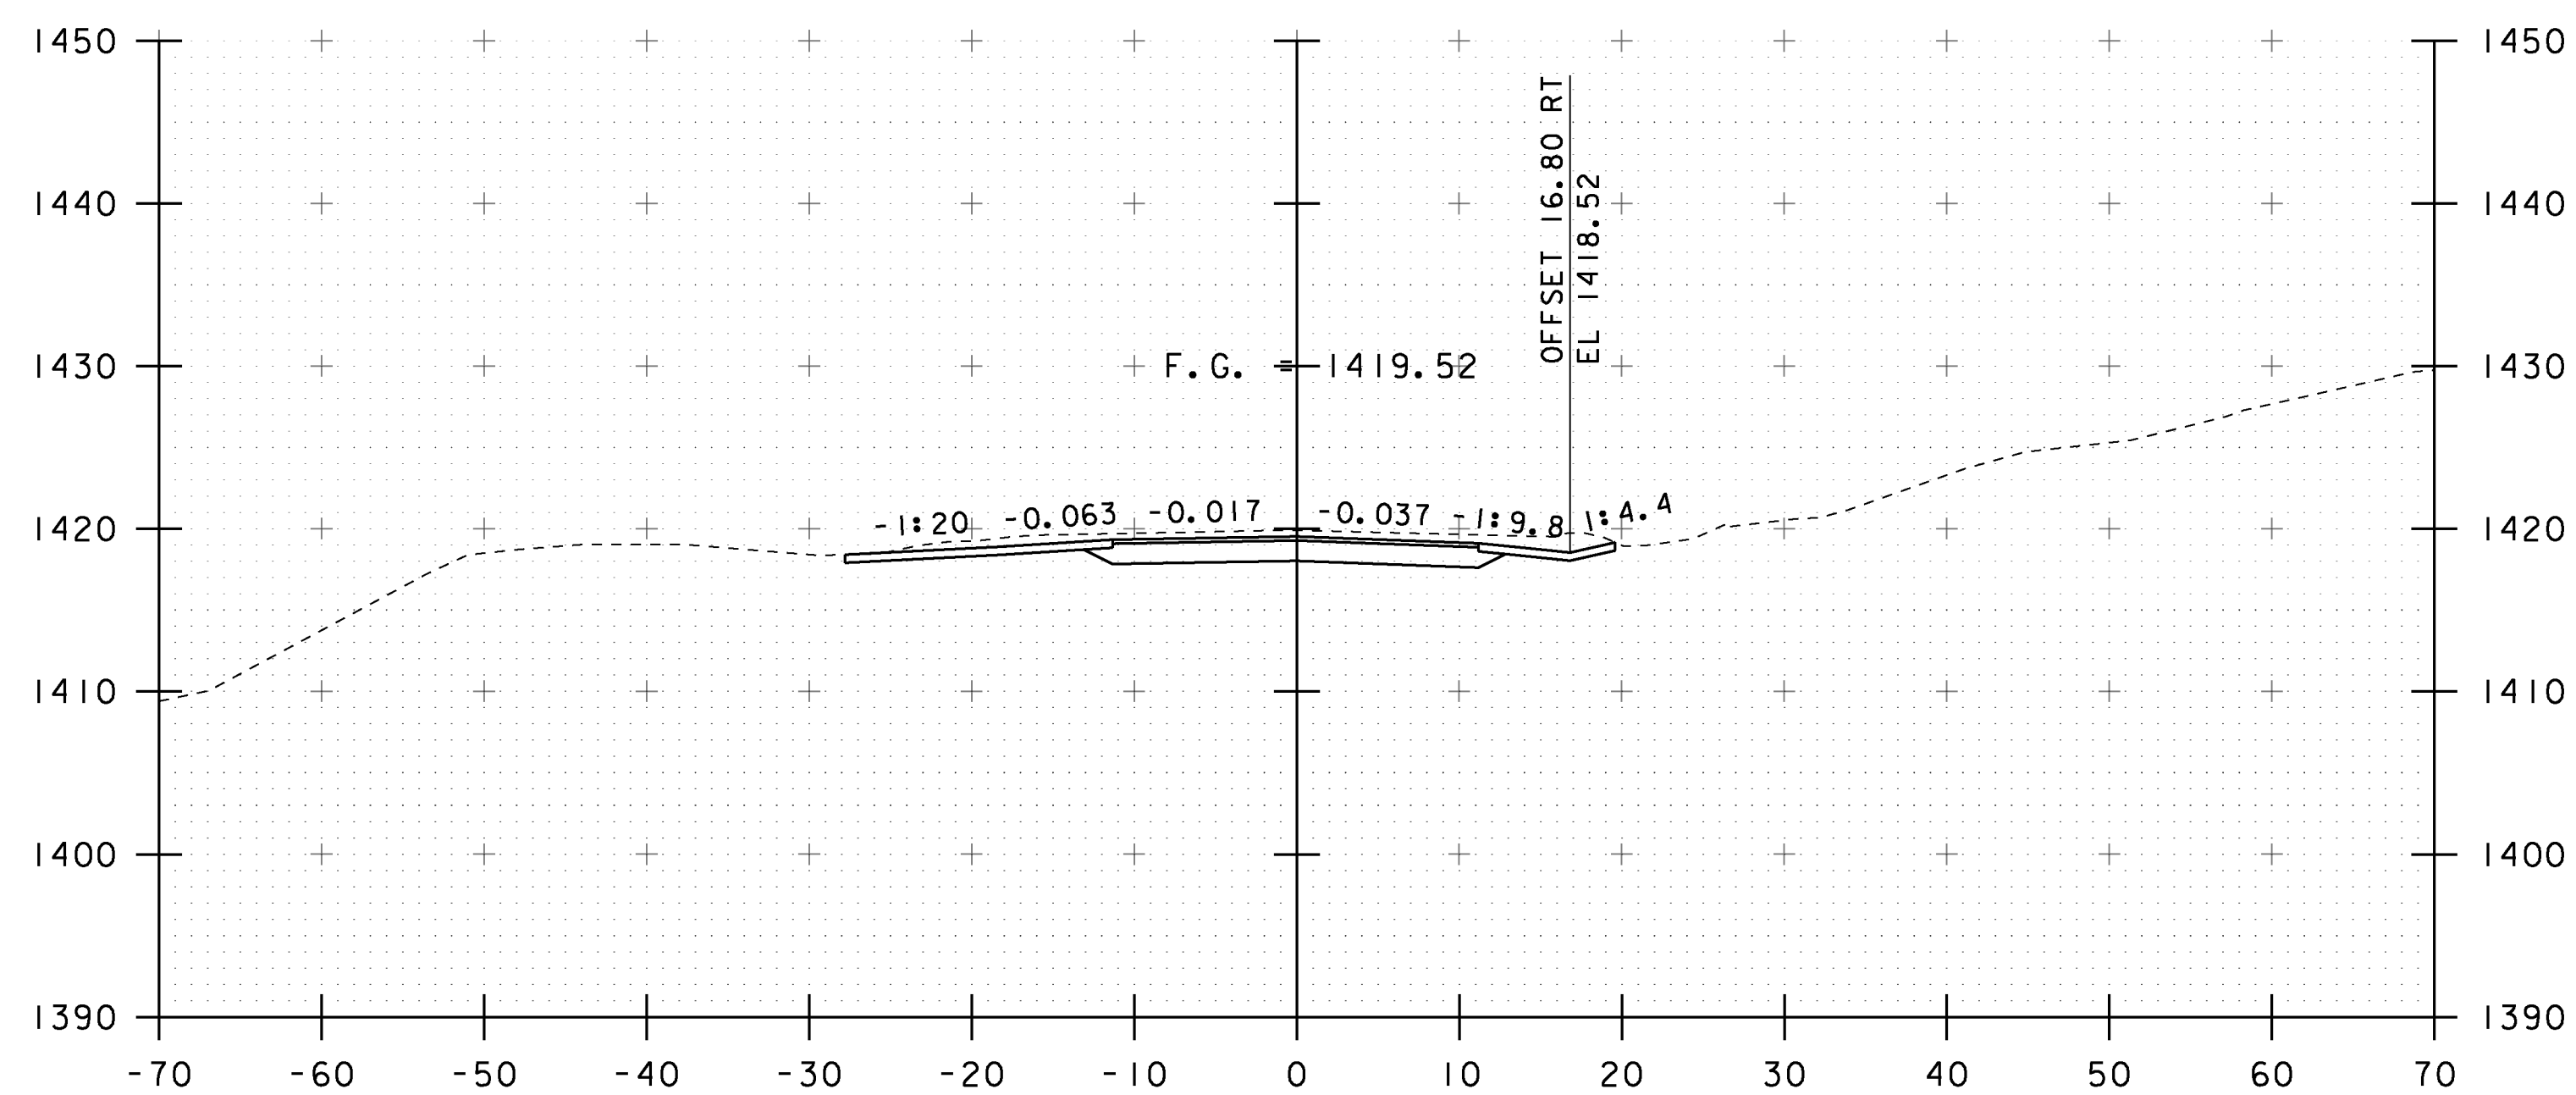

10+50

PROJECT NAME:	WARDSBORO
PROJECT NUMBER:	BRF 013-1(15)
FILE NAME:	s92b283xsl.dgn
PROJECT LEADER:	C. CARLSON
DESIGNED BY:	J. GRIFFIN
TOWN HIGHWAY 7 CROSS SECTIONS	
PLOT DATE:	15-JUL-2015
DRAWN BY:	J. GRIFFIN
CHECKED BY:	D. PETERSON
SHEET	39 OF 51

STA. 10+00 TO STA. 10+75