




STA 51+11.24 RT
 BEGIN UNCLASSIFIED CHANNEL EX,
 GEOTEXTILE UNDER STONE FILL,
 STONE FILL TYPE IV,
 GRUBBING MATERIAL.

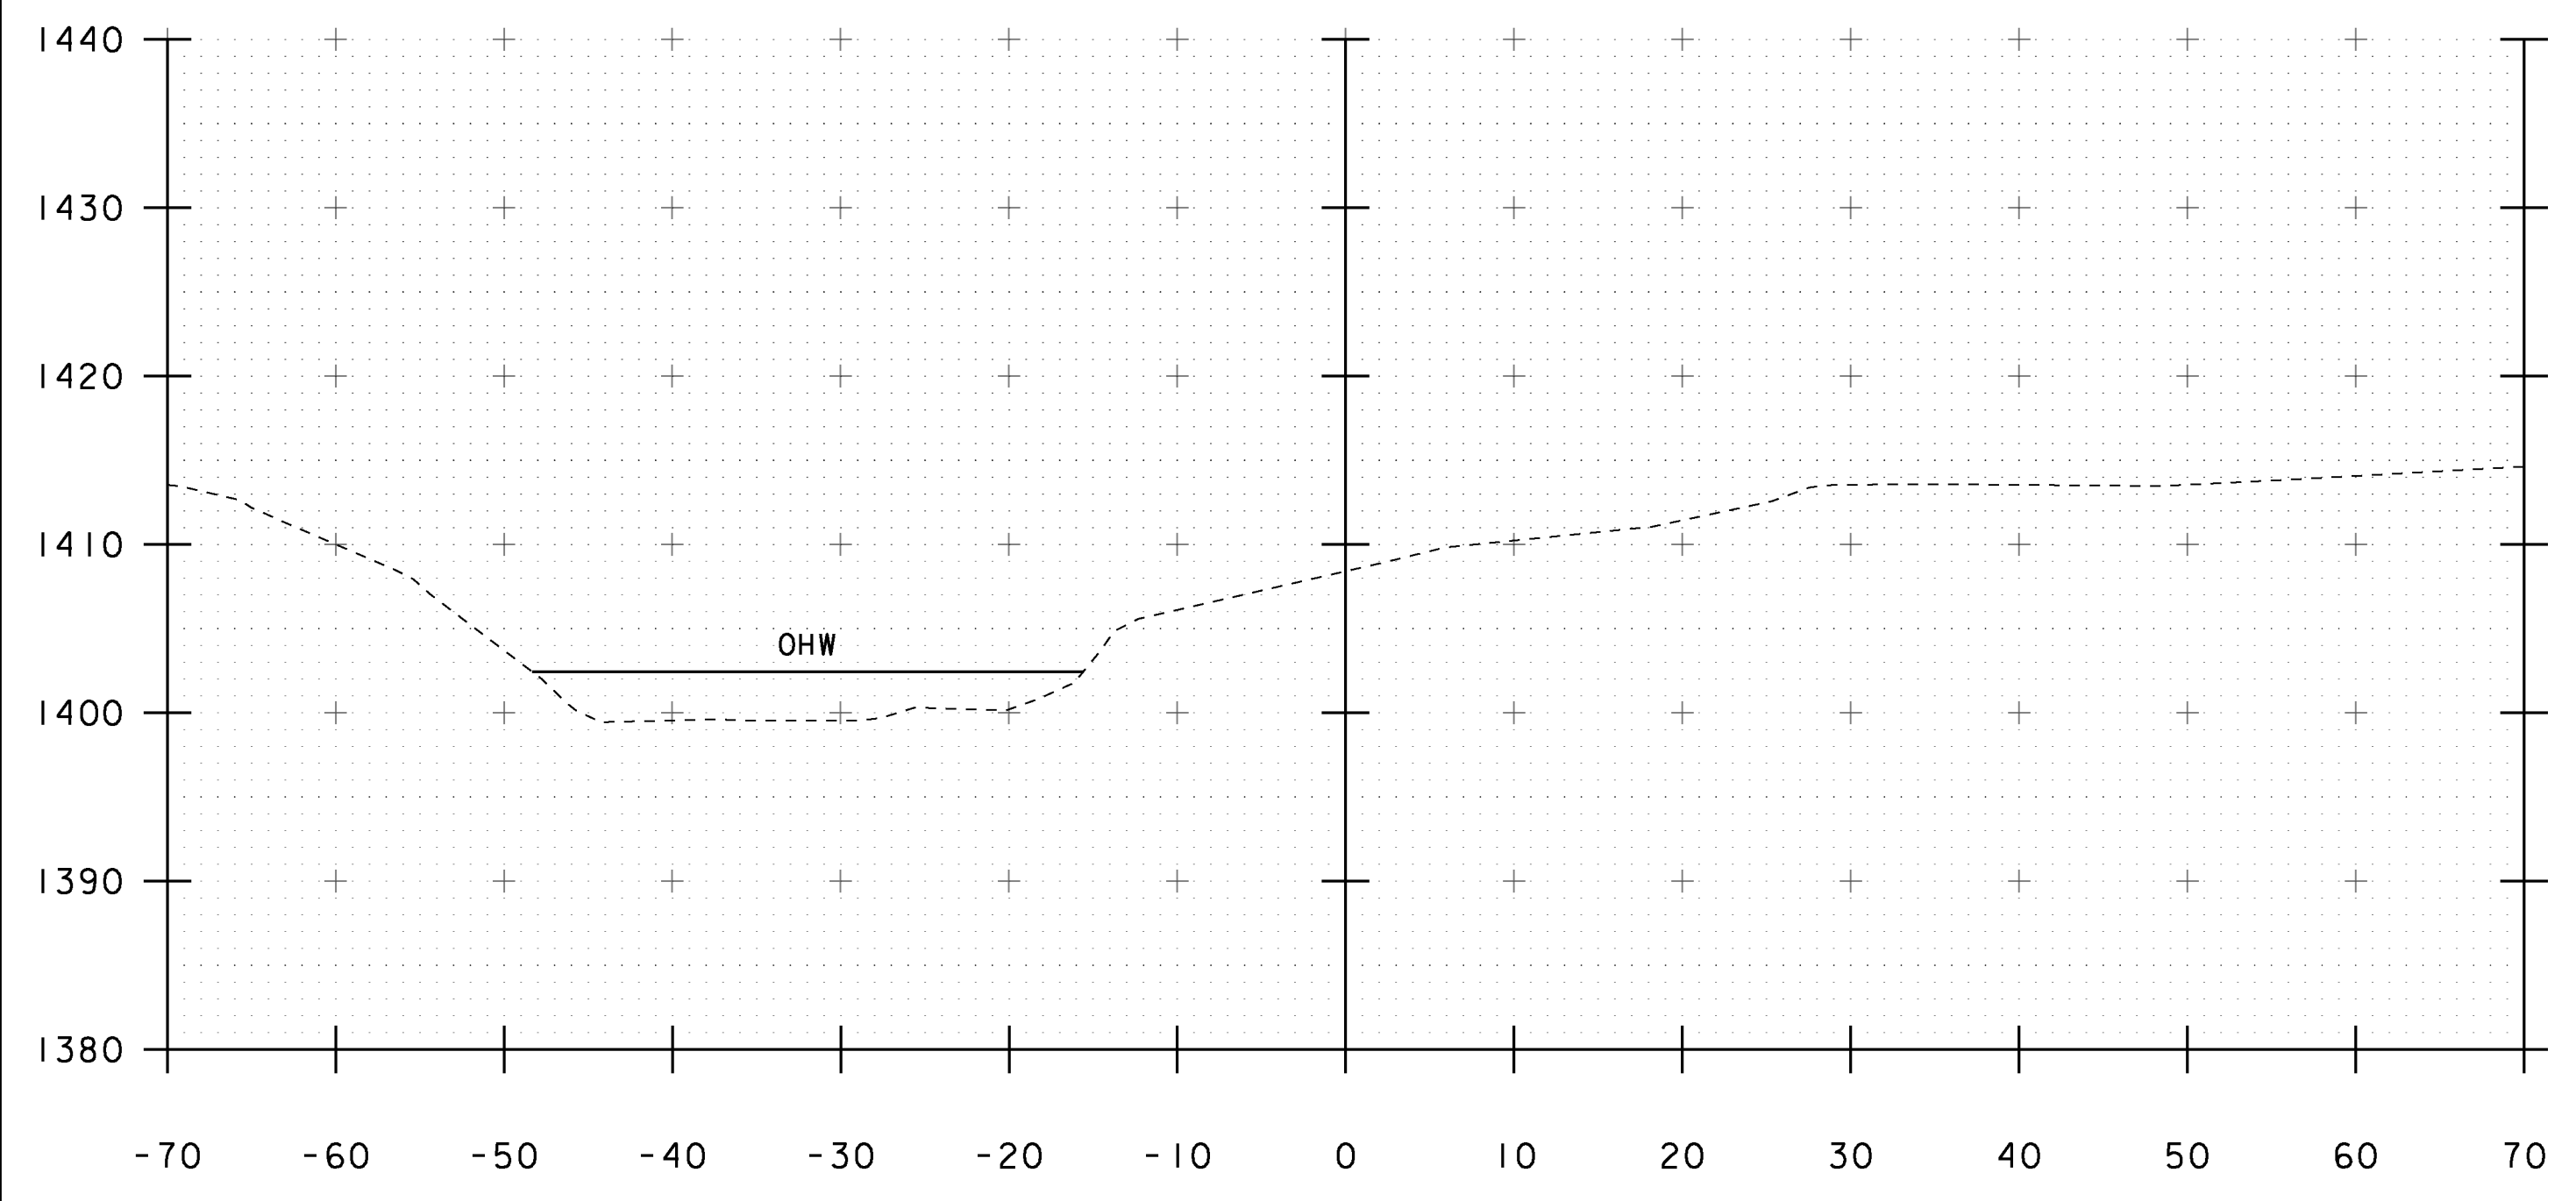


50+90

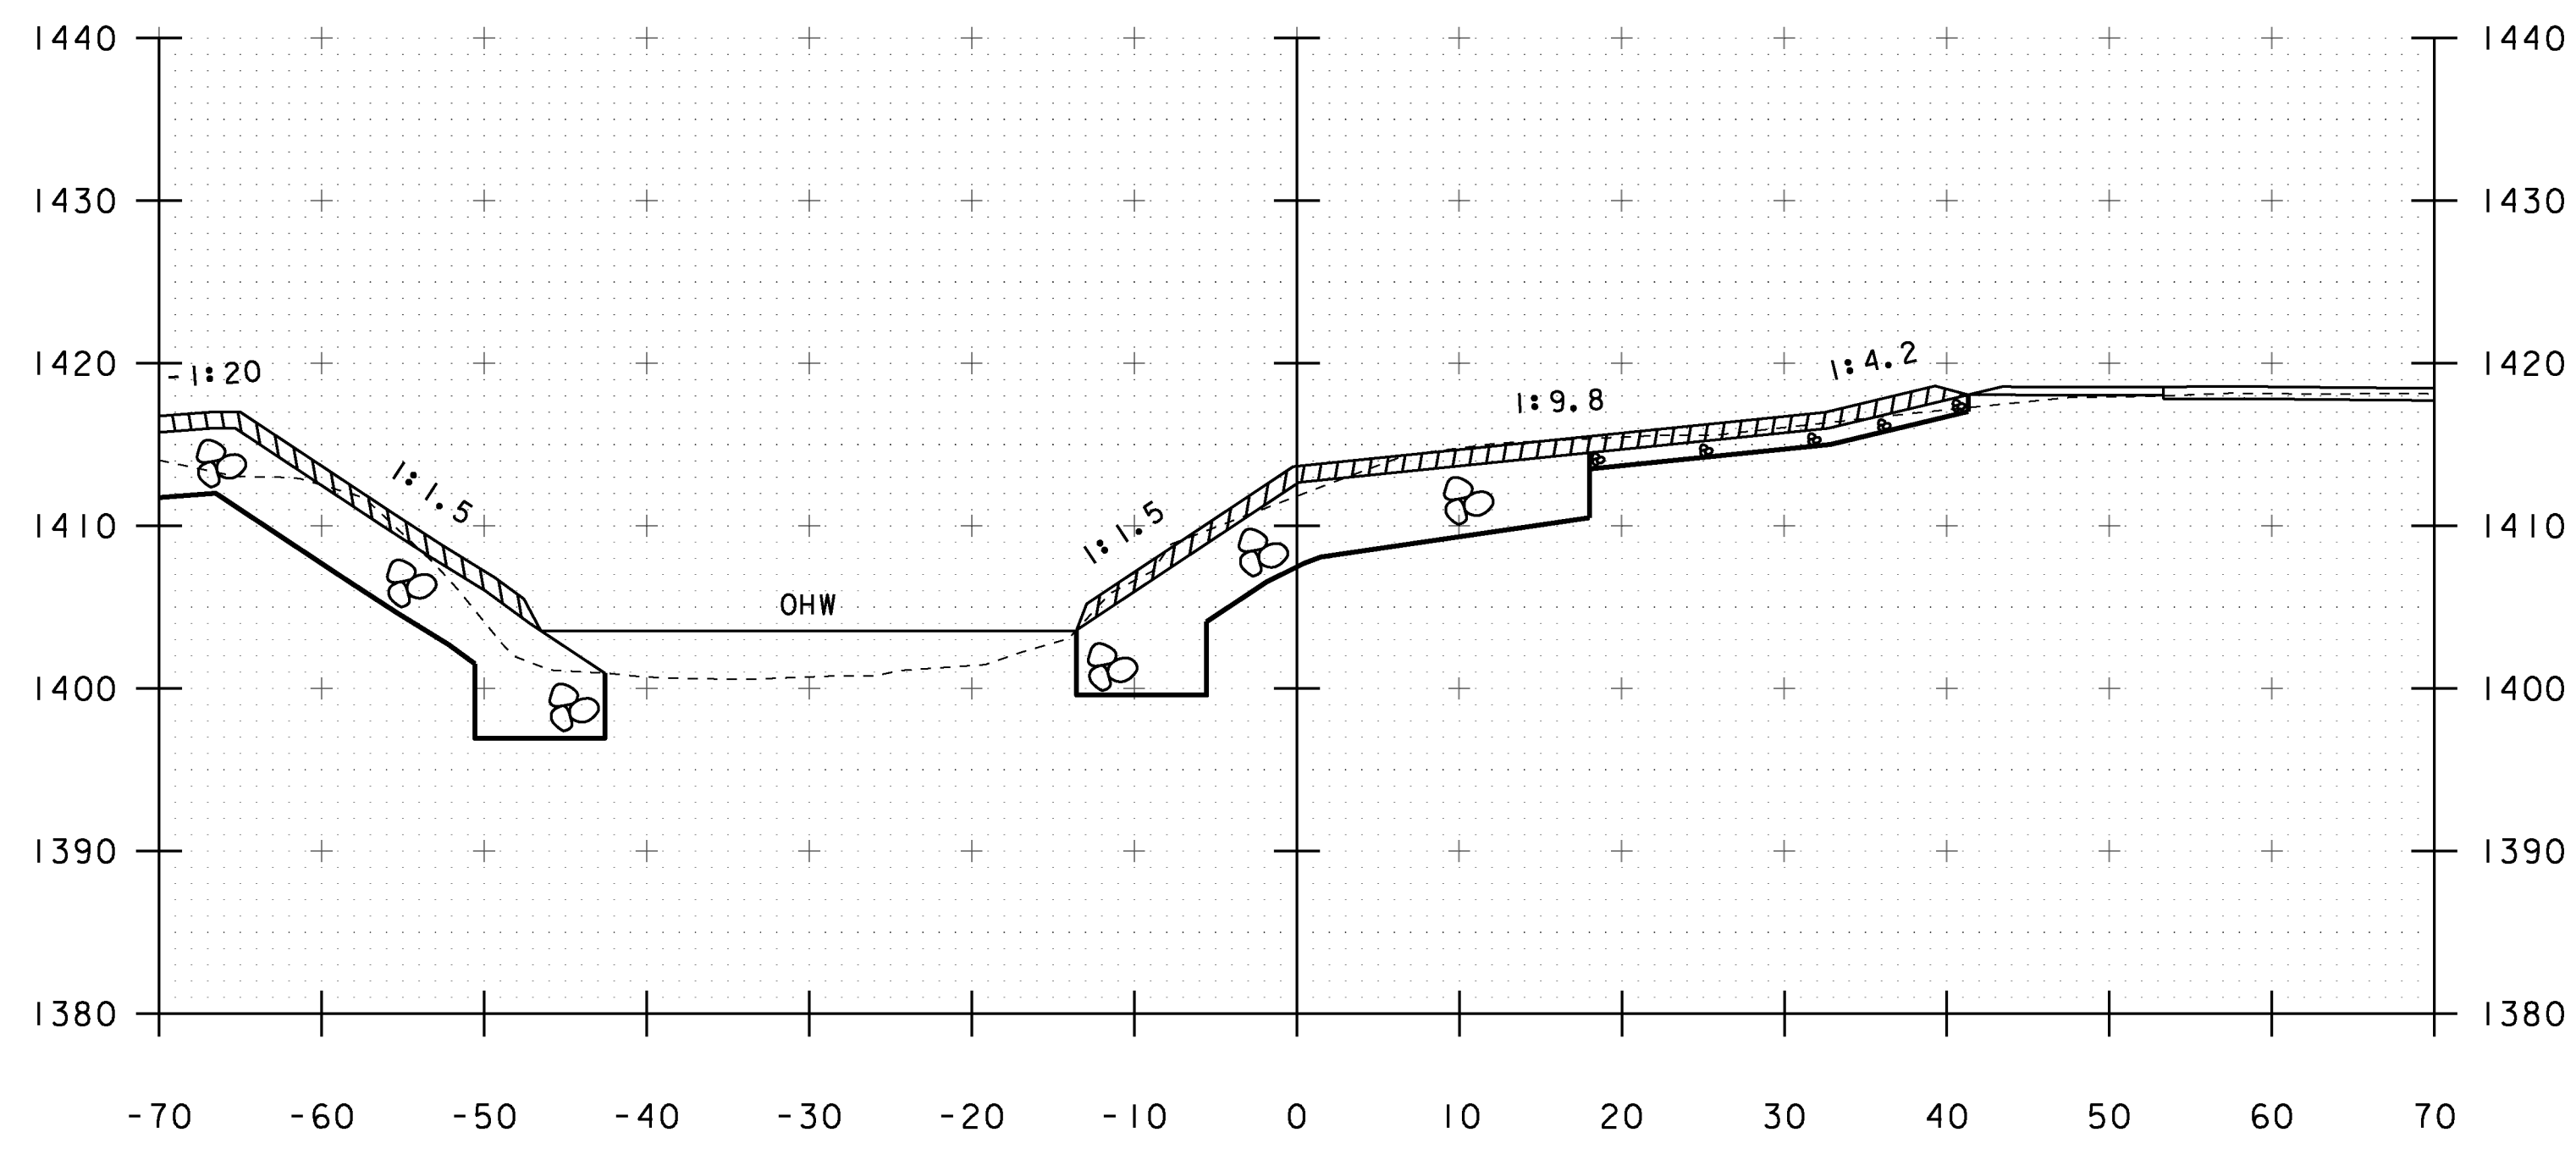

51+25

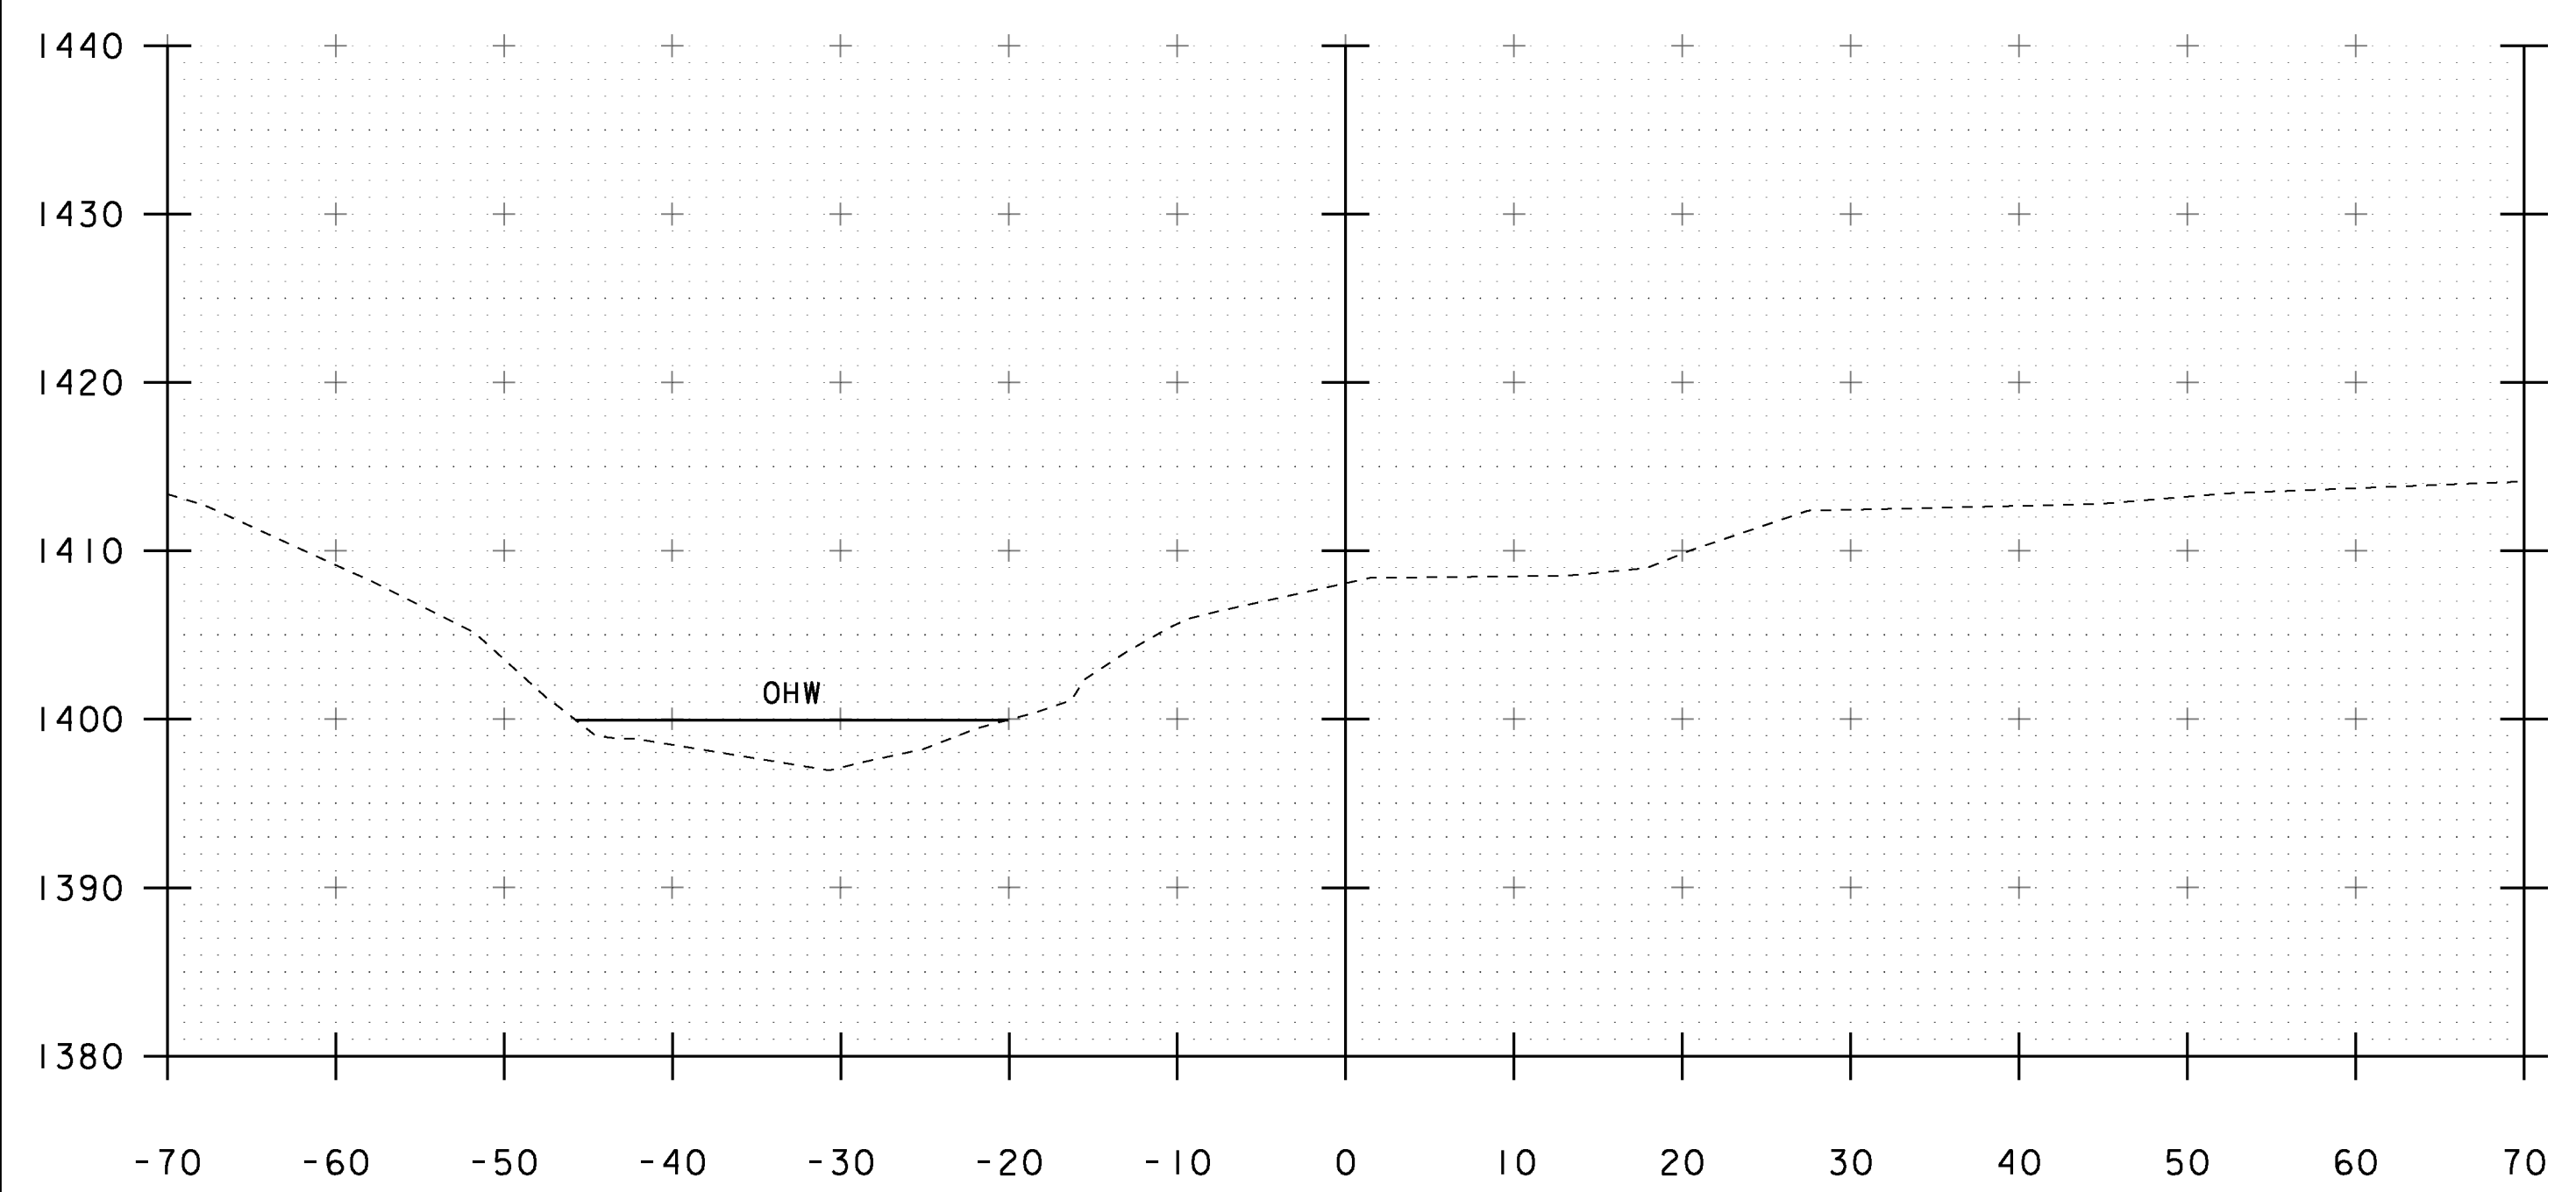

50+75

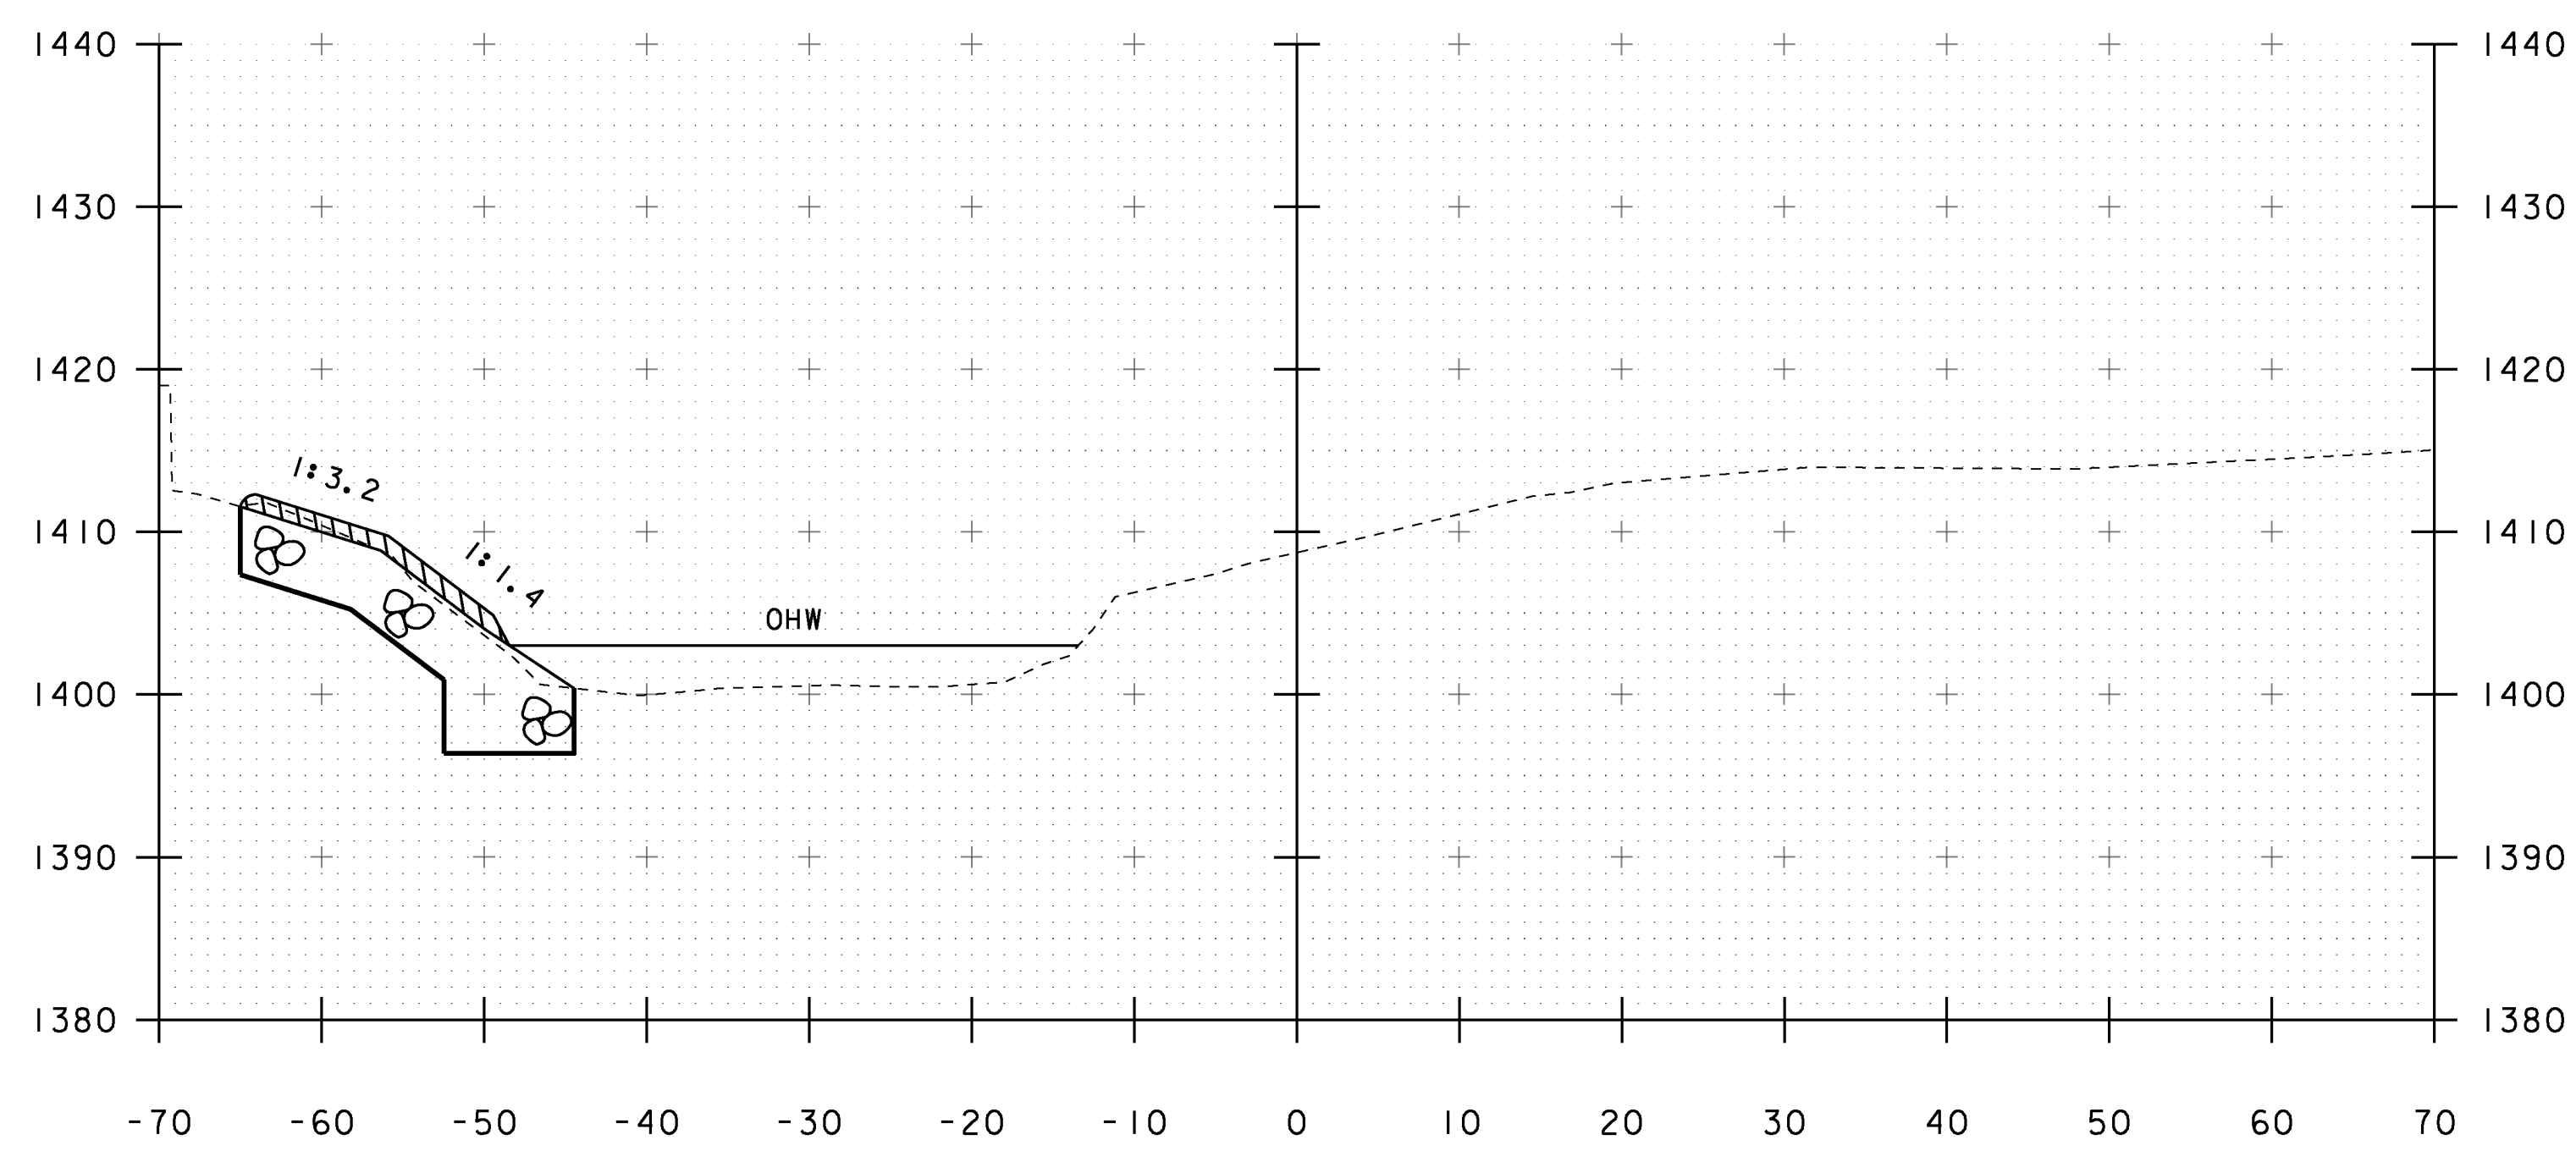

51+00

STA 50+90.83 LT
 BEGIN UNCLASSIFIED CHANNEL EX,
 GEOTEXTILE UNDER STONE FILL,
 STONE FILL TYPE IV,
 GRUBBING MATERIAL.

STA. 50+75 TO STA. 51+25

PROJECT NAME:	WARDSBORO	PLOT DATE:	15-JUL-2015
PROJECT NUMBER:	BRF 013-1(15)	DRAWN BY:	J. GRIFFIN
FILE NAME:	s92b283xsl.dgn	CHECKED BY:	D. PETERSON
PROJECT LEADER:	C. CARLSON	SHEET	40 OF 51
DESIGNED BY:	J. GRIFFIN	CHANNEL CROSS SECTIONS 1	