




51+40

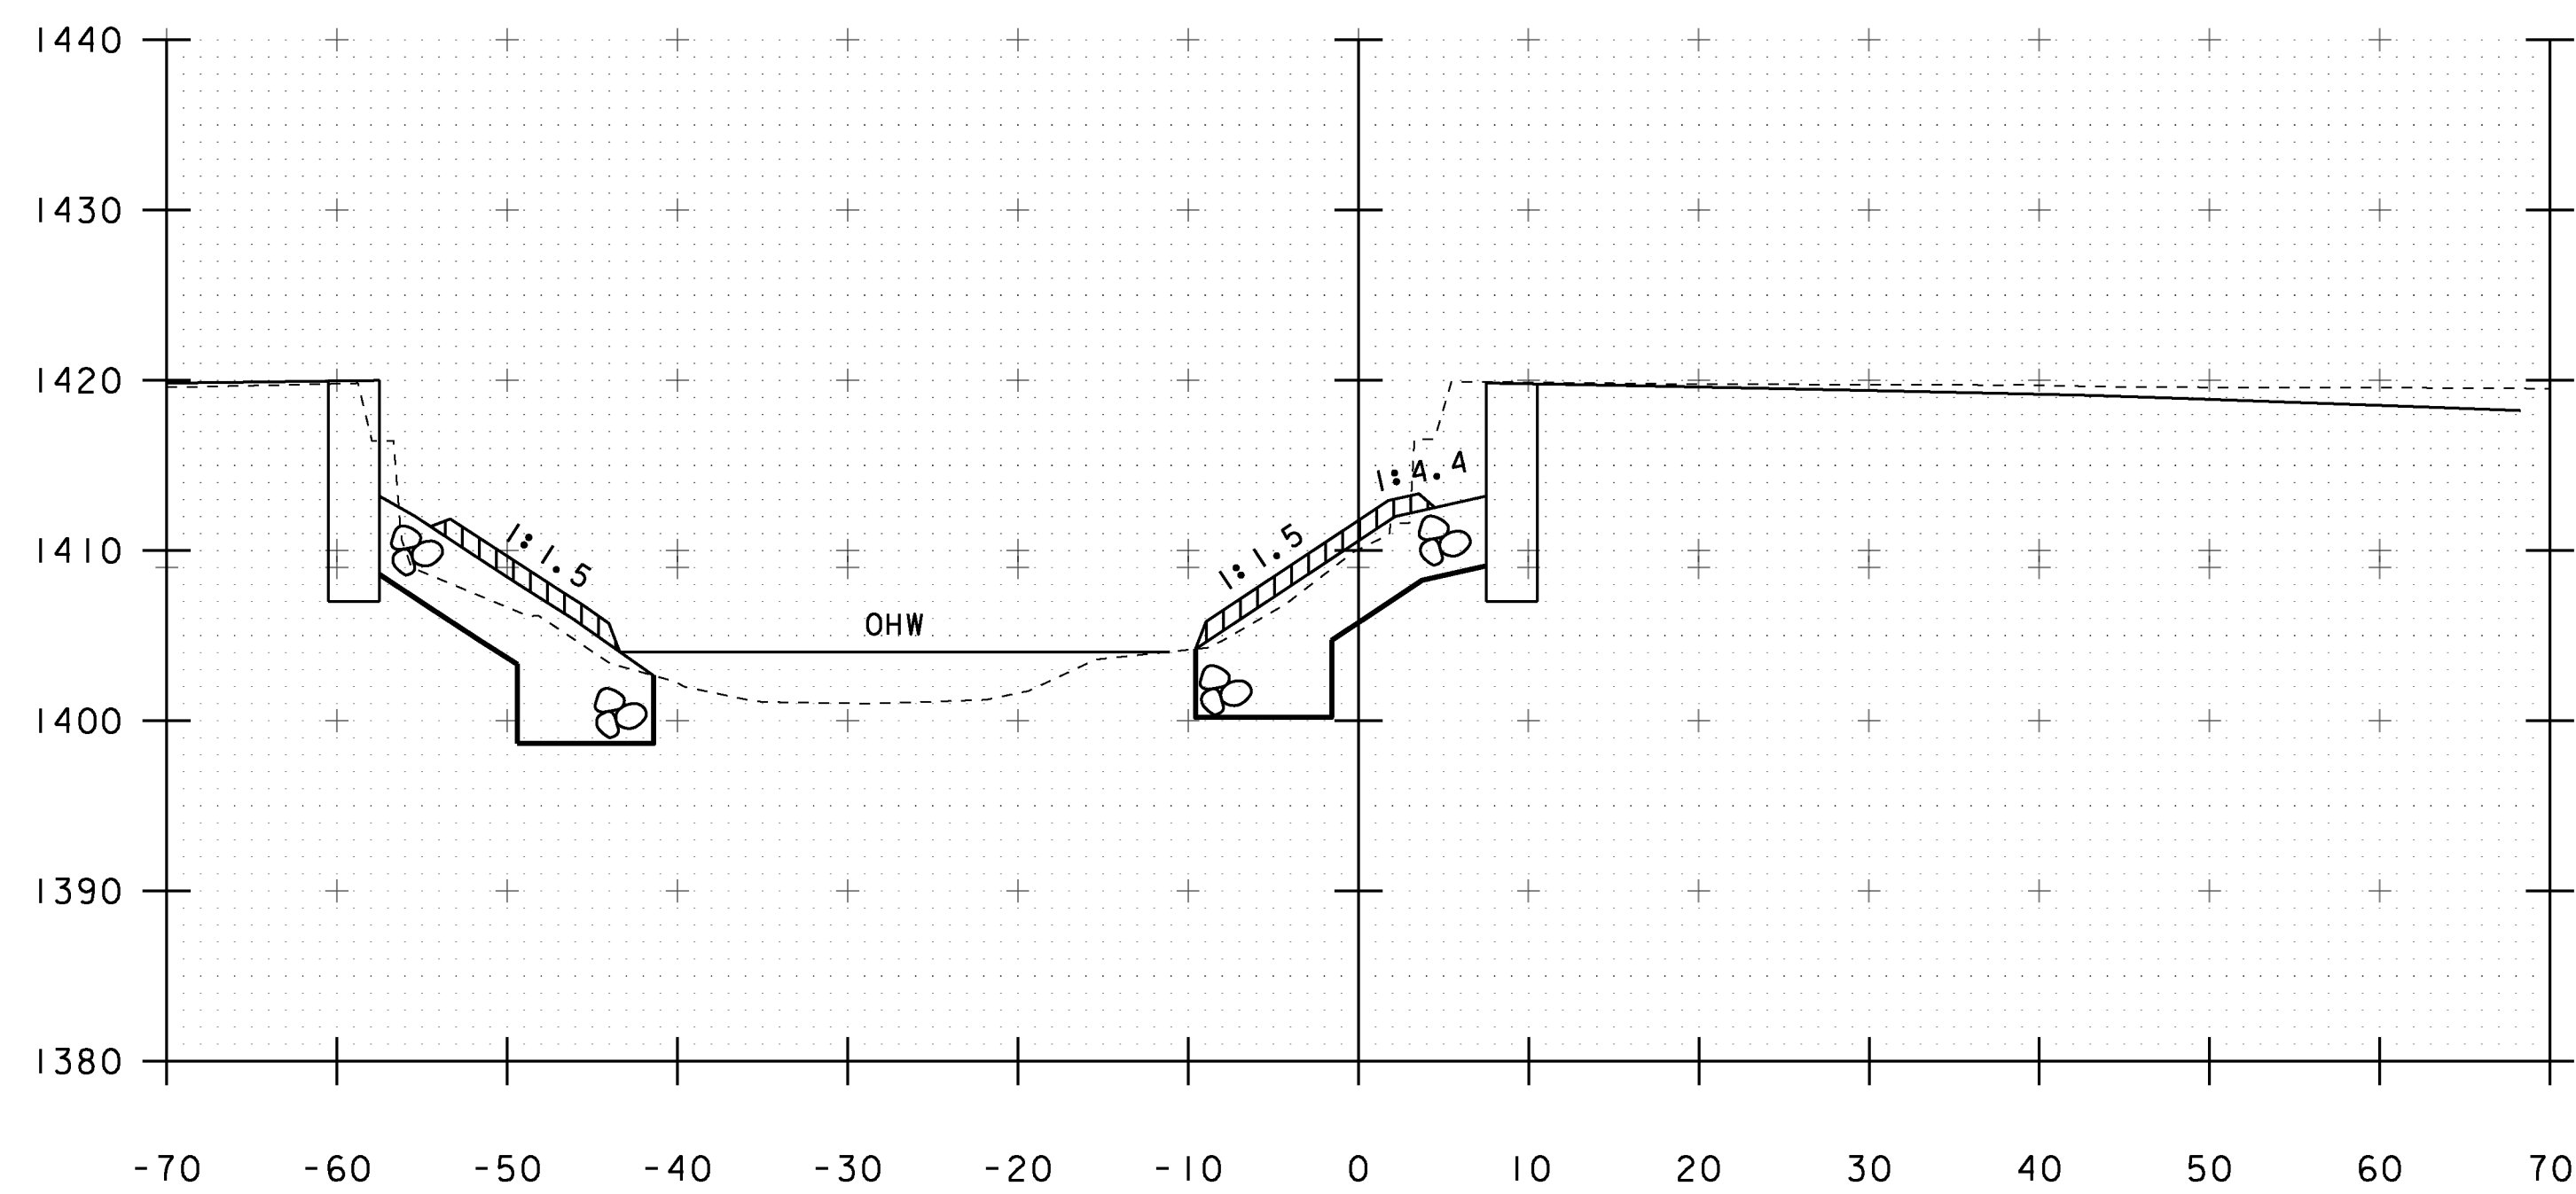

51+60

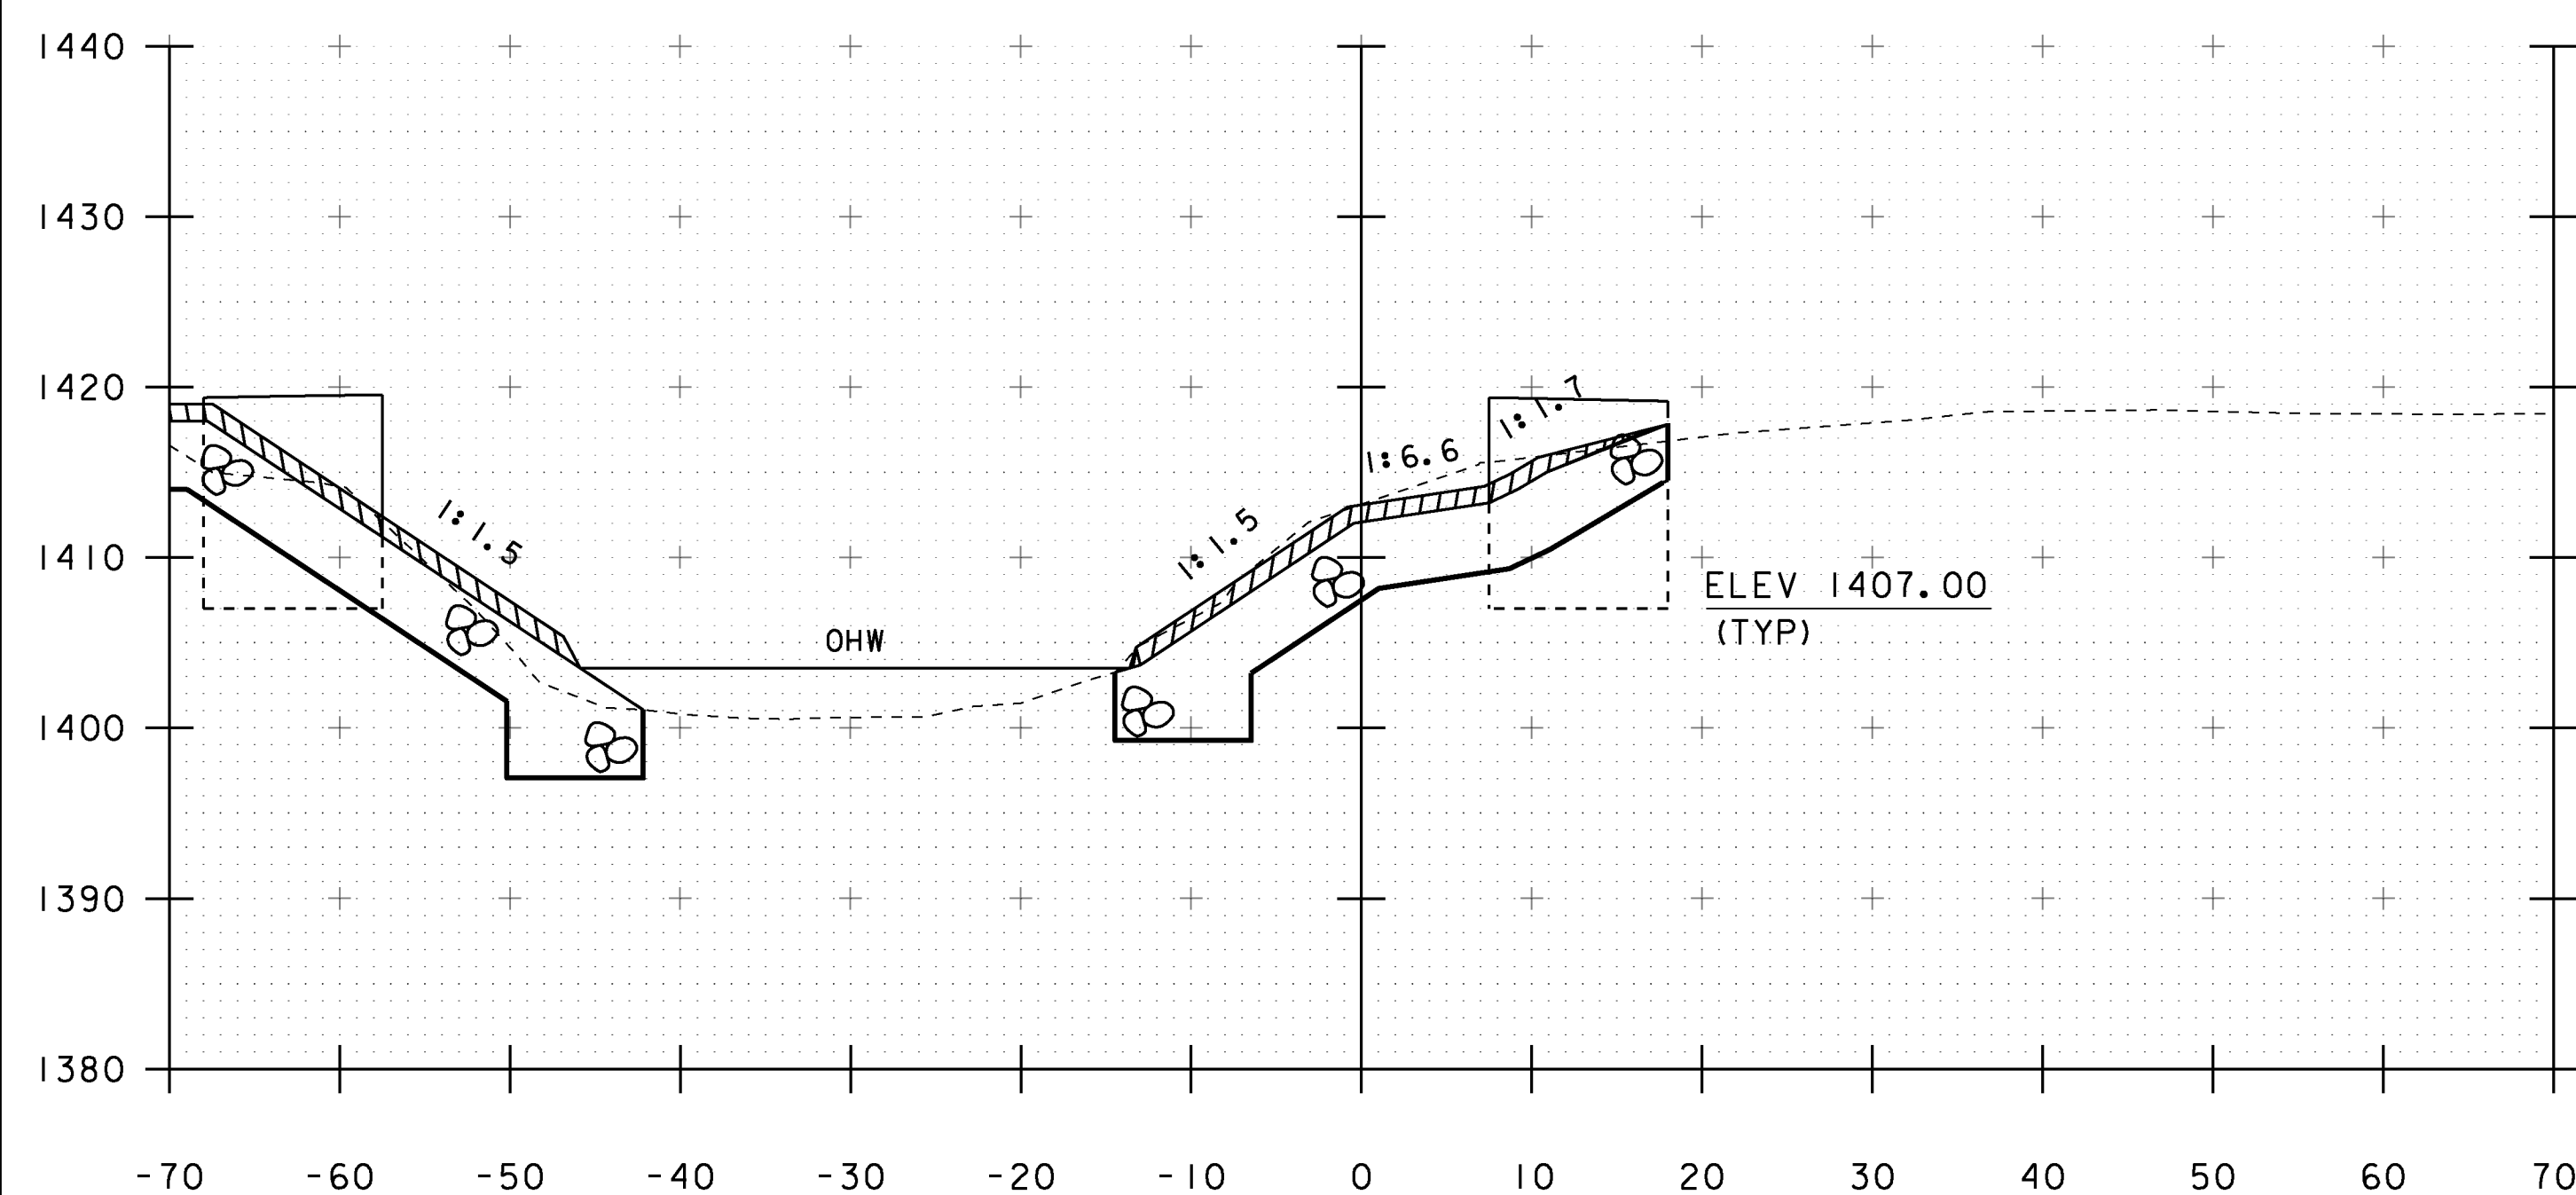

51+30

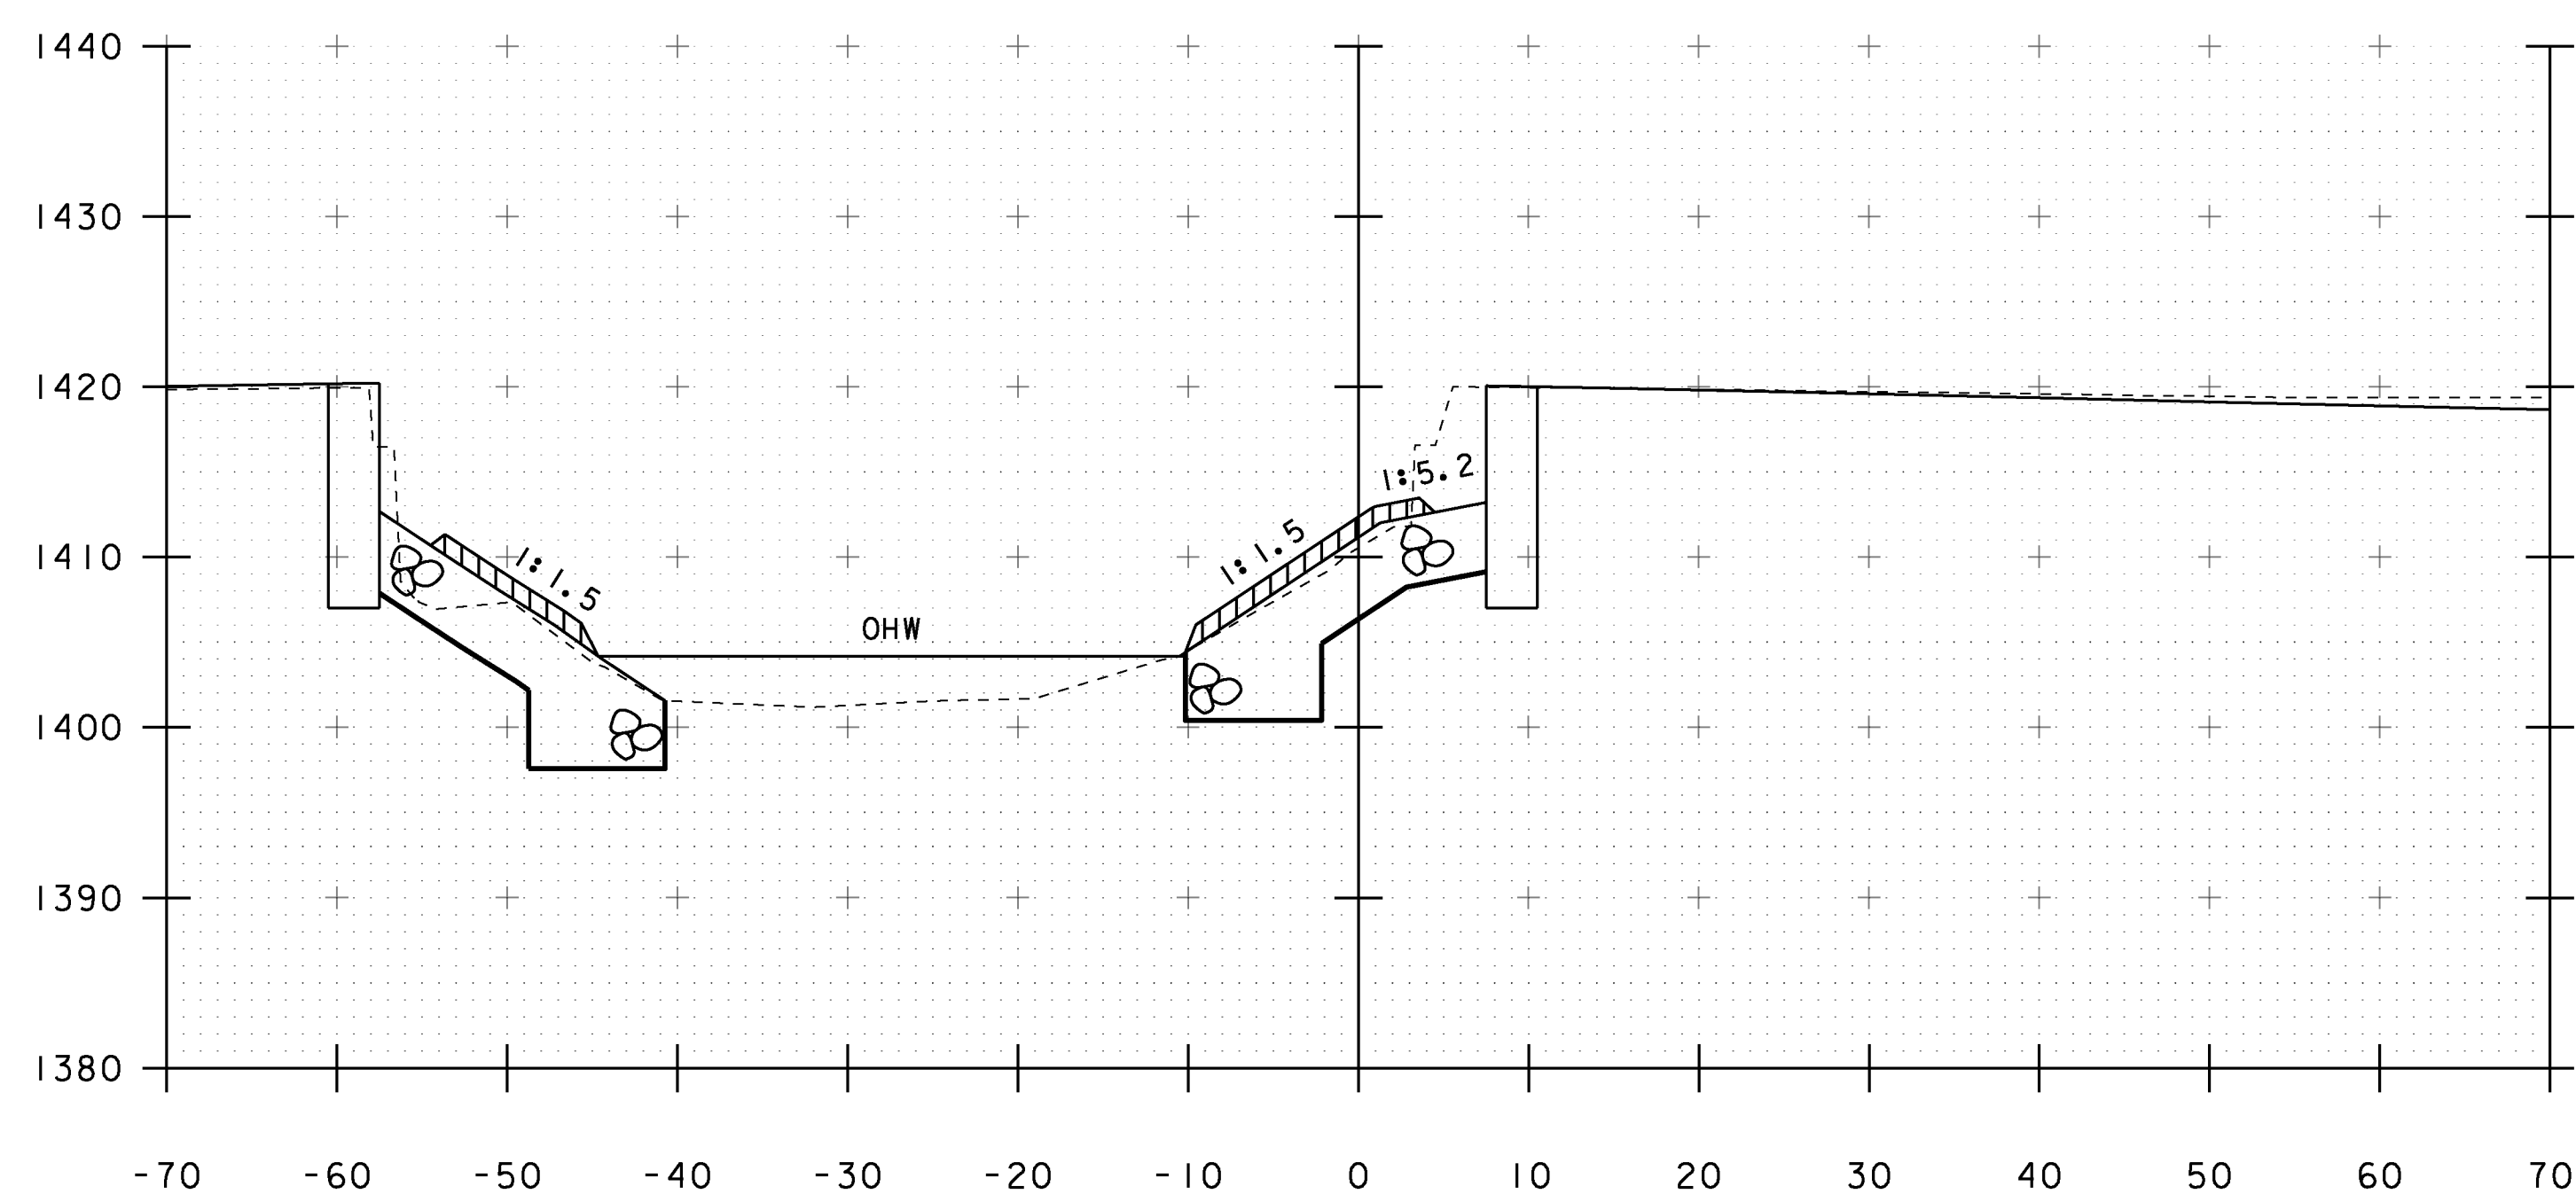

51+50

STA. 51+30 TO STA. 51+60

PROJECT NAME:	WARDSBORO
PROJECT NUMBER:	BRF 013-I(15)
FILE NAME:	s92b283xsl.dgn
PROJECT LEADER:	C. CARLSON
DESIGNED BY:	J. GRIFFIN
CHANNEL CROSS SECTIONS 2	
PLOT DATE:	15-JUL-2015
DRAWN BY:	J. GRIFFIN
CHECKED BY:	D. PETERSON
SHEET	41 OF 51