




51+75

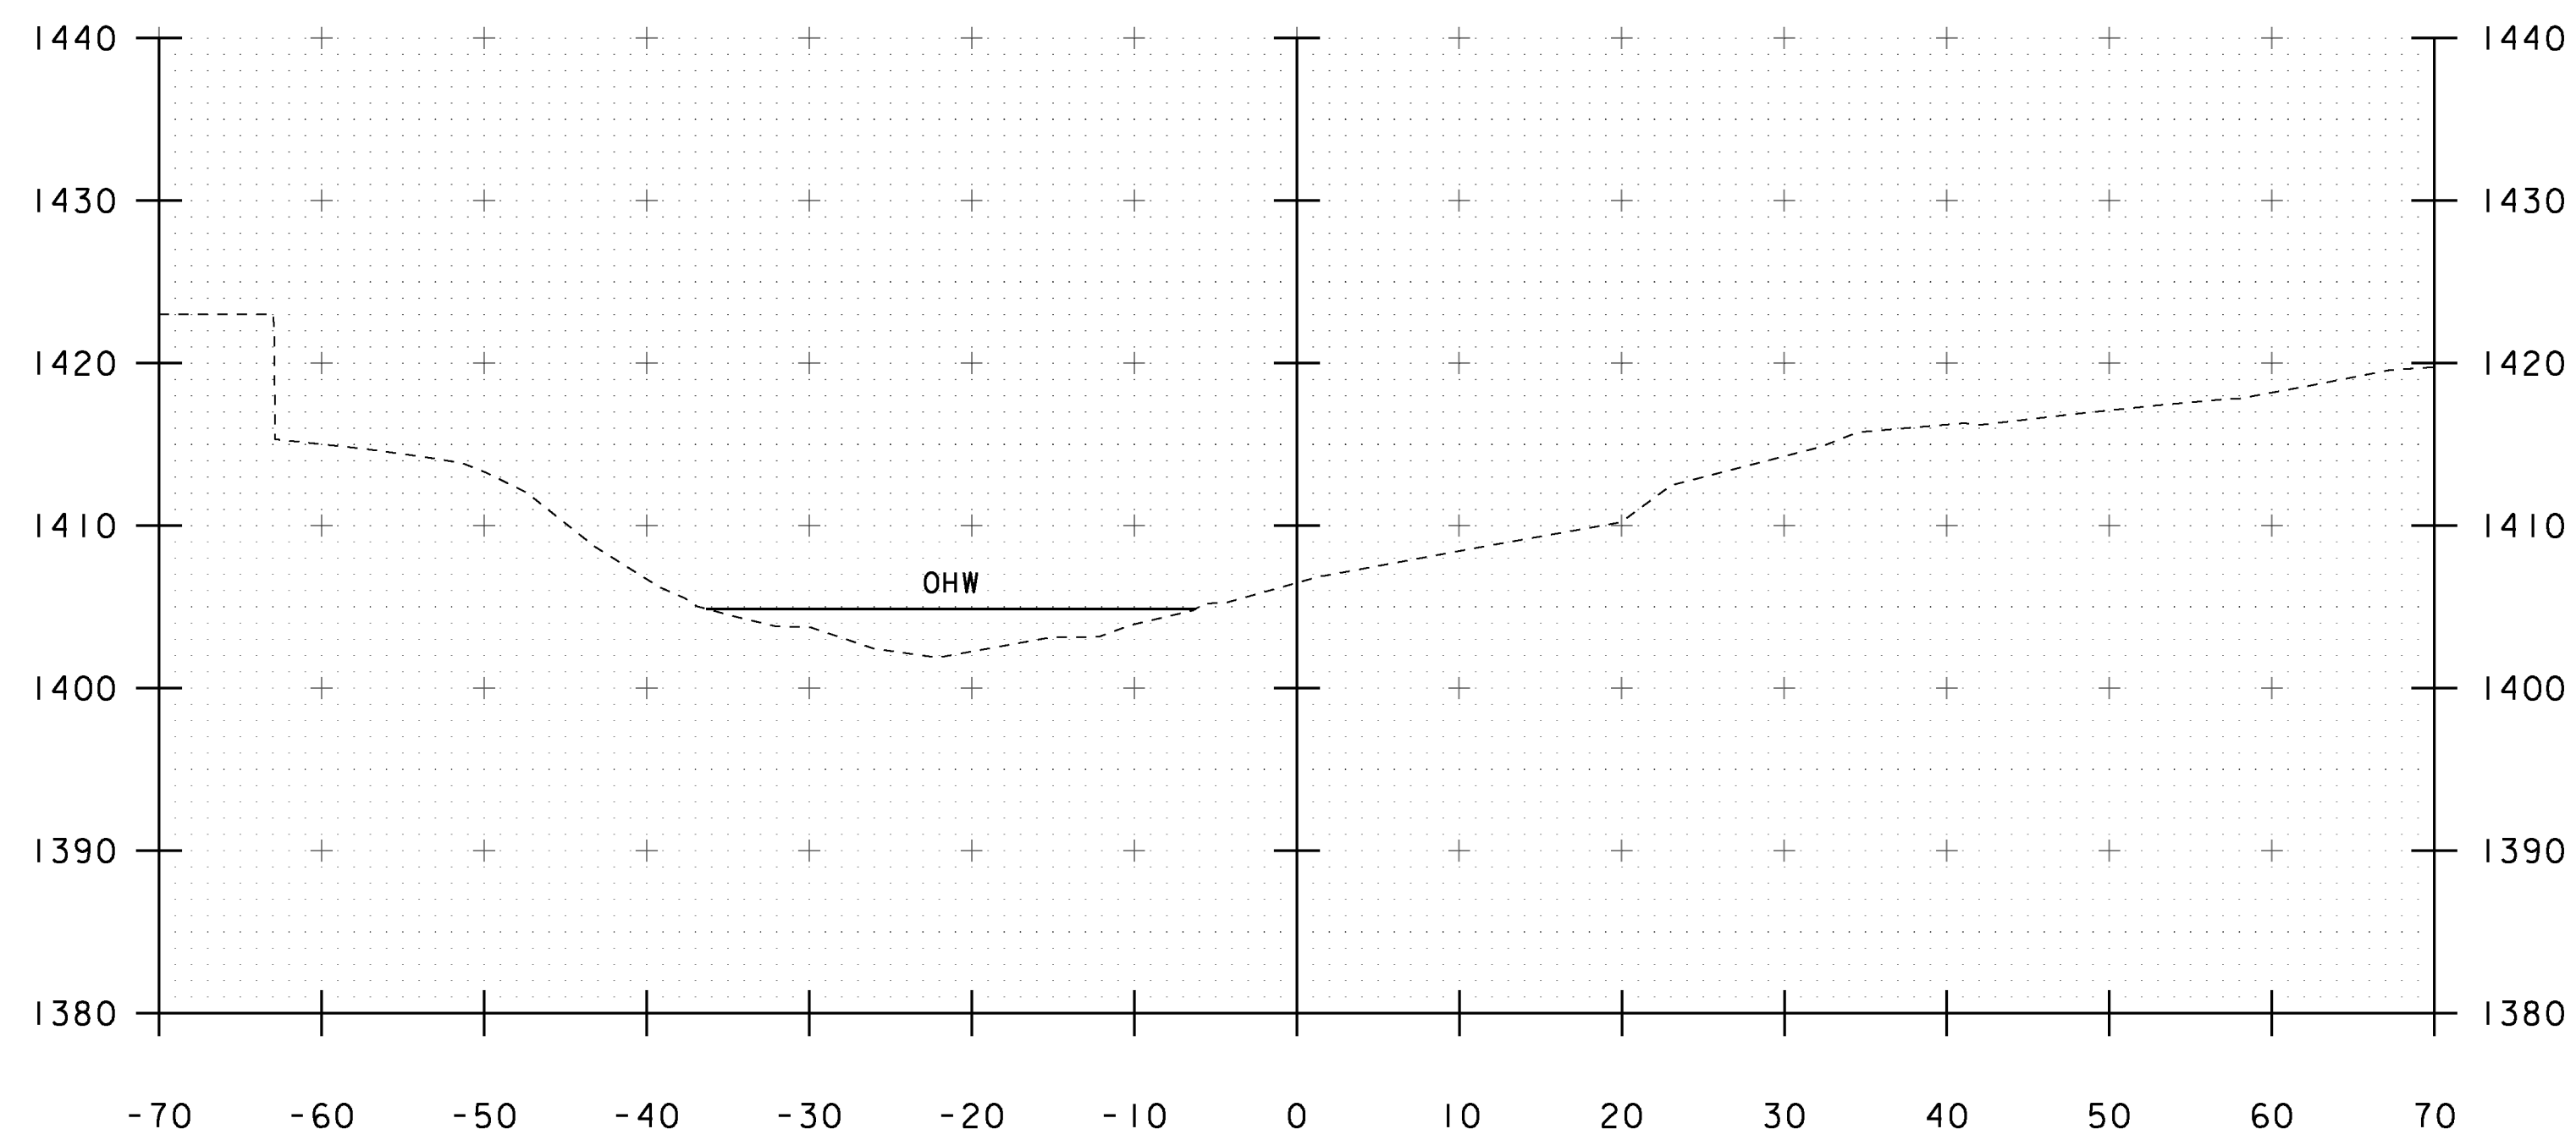

52+25

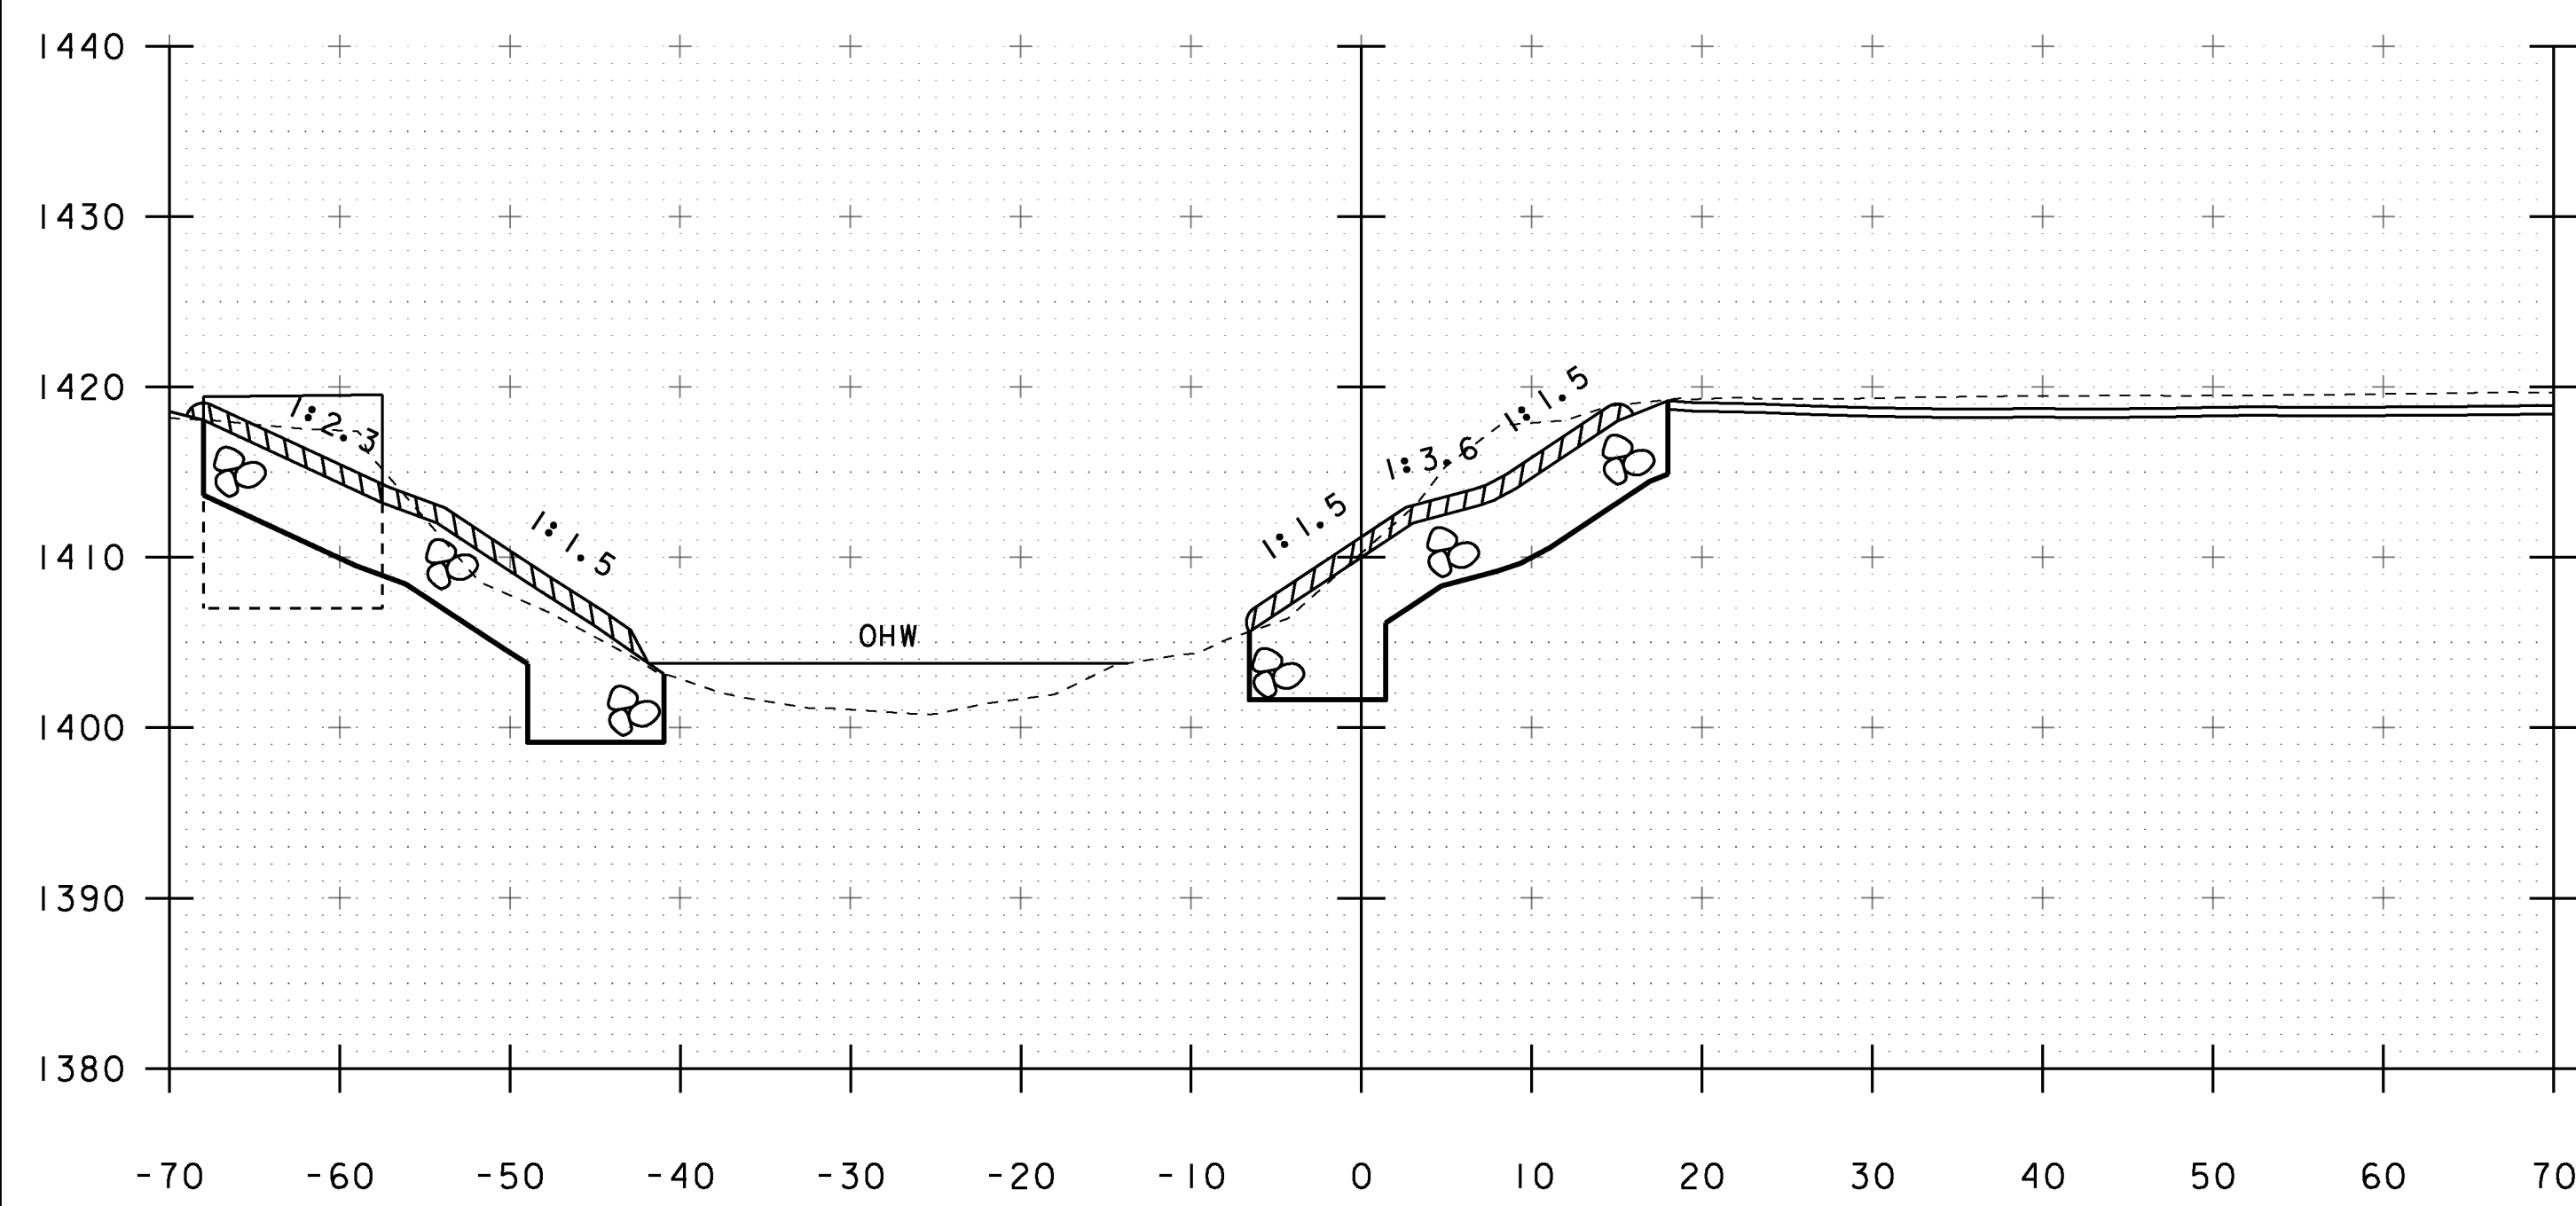

51+70

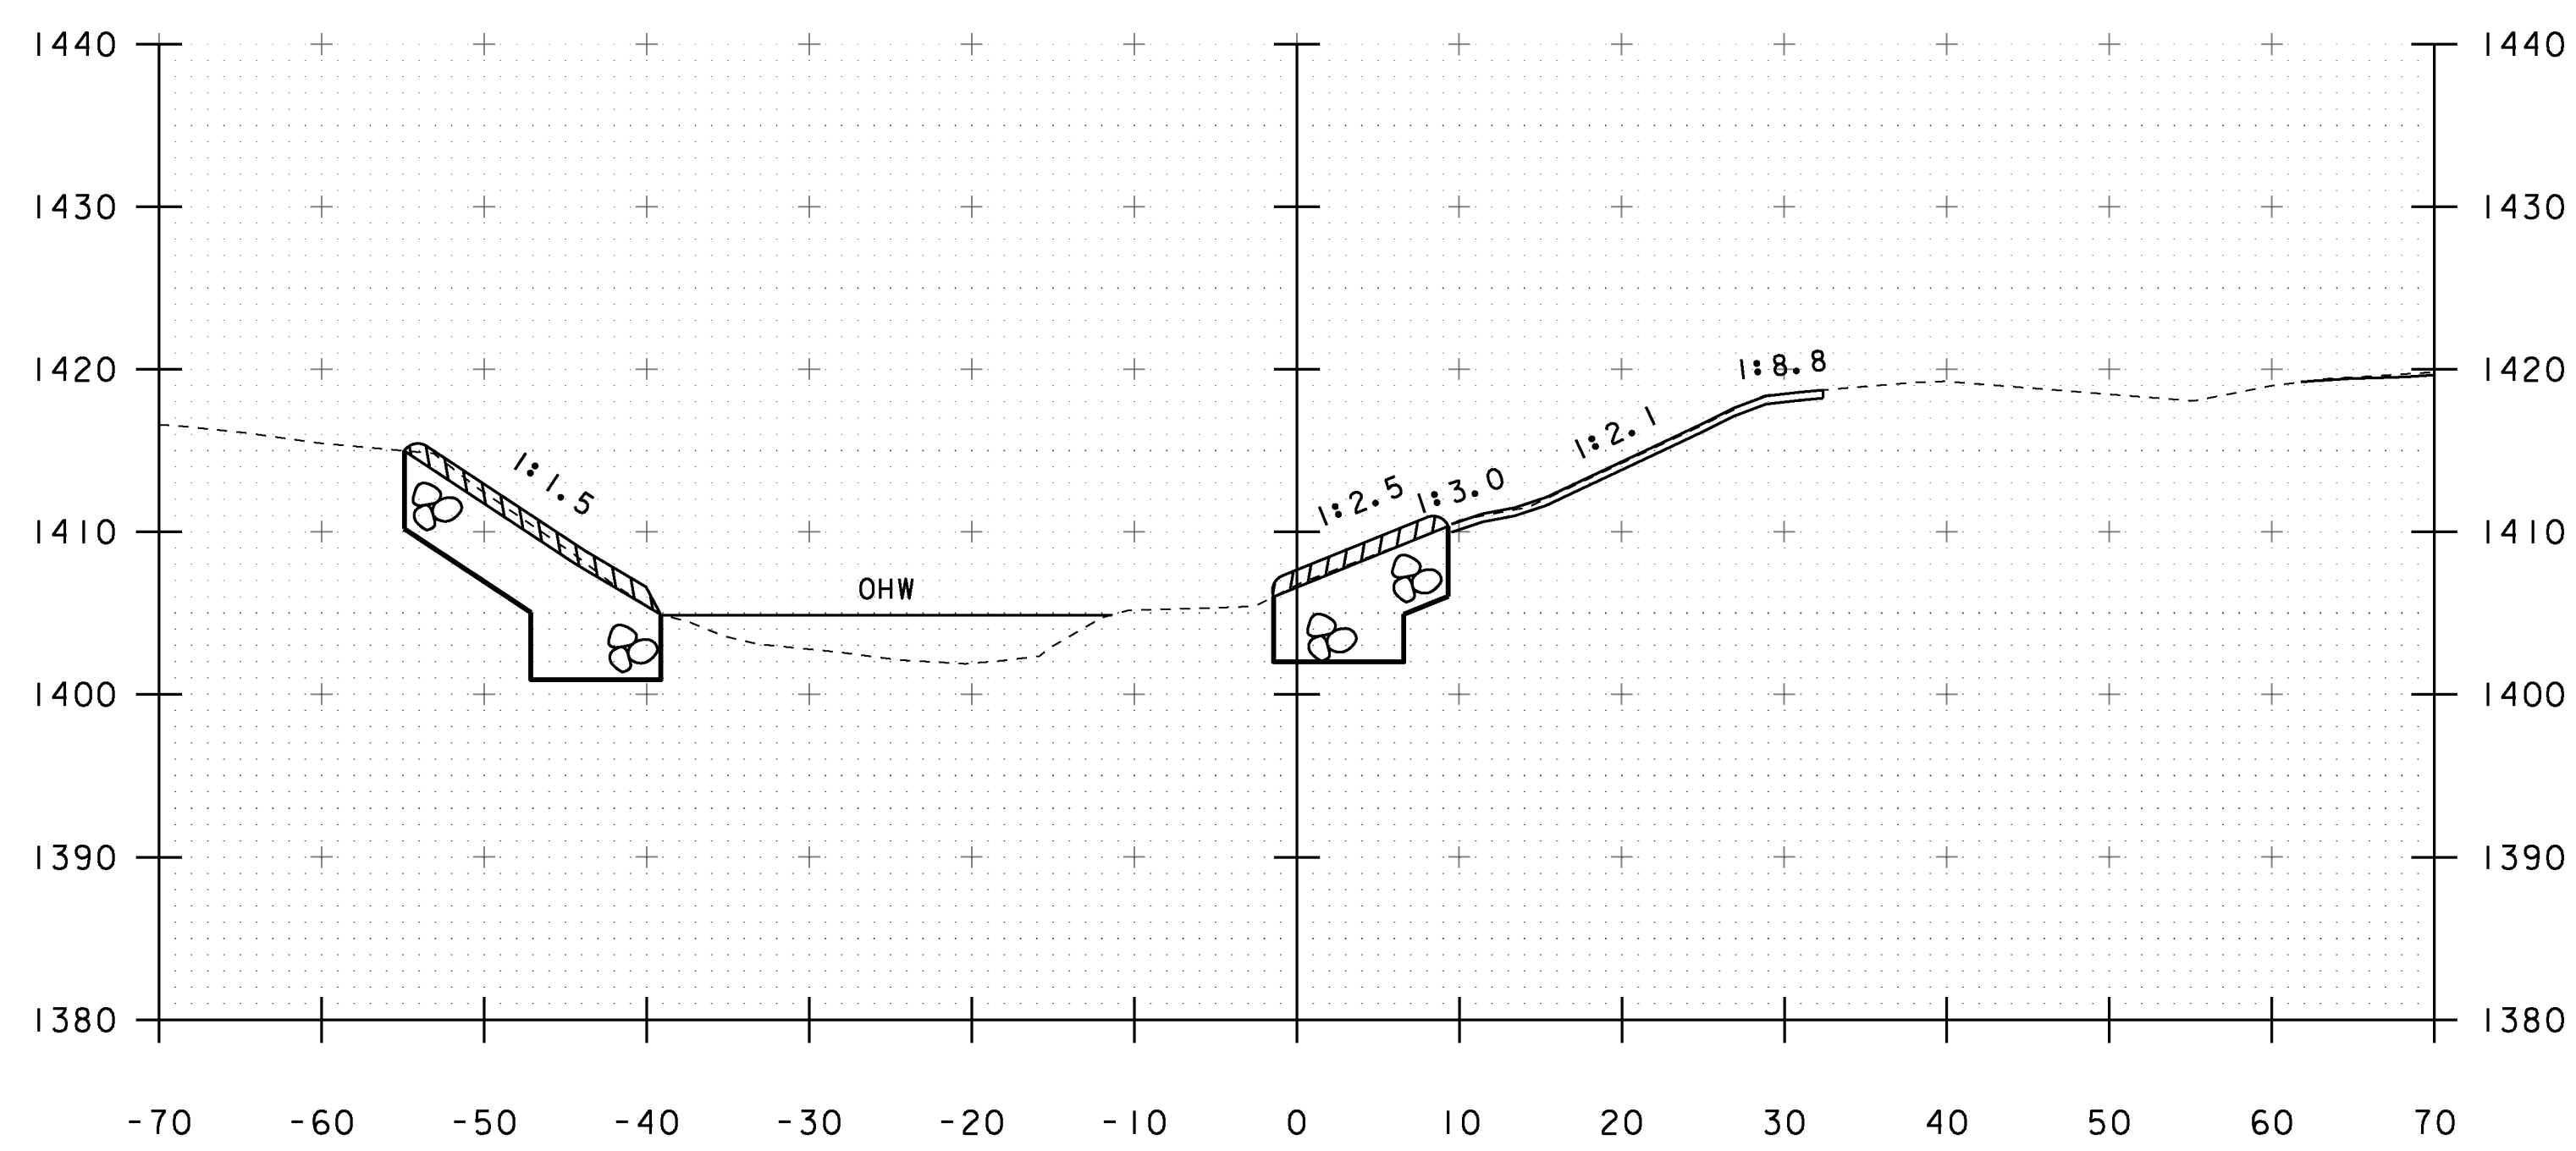

52+05

STA 52+05.00 LT-RT
 END UNCLASSIFIED CHANNEL EX,
 GEOTEXTILE UNDER STONE FILL,
 STONE FILL TYPE IV,
 GRUBBING MATERIAL,

STA. 51+70 TO STA. 52+25

PROJECT NAME:	WARDSBORO	PLOT DATE:	15-JUL-2015
PROJECT NUMBER:	BRF 013-I(15)	DRAWN BY:	J. GRIFFIN
FILE NAME:	s92b283xsl.dgn	CHECKED BY:	D. PETERSON
PROJECT LEADER:	C. CARLSON	SHEET	42 OF 51
DESIGNED BY:	J. GRIFFIN		
CHANNEL CROSS SECTIONS	3		