

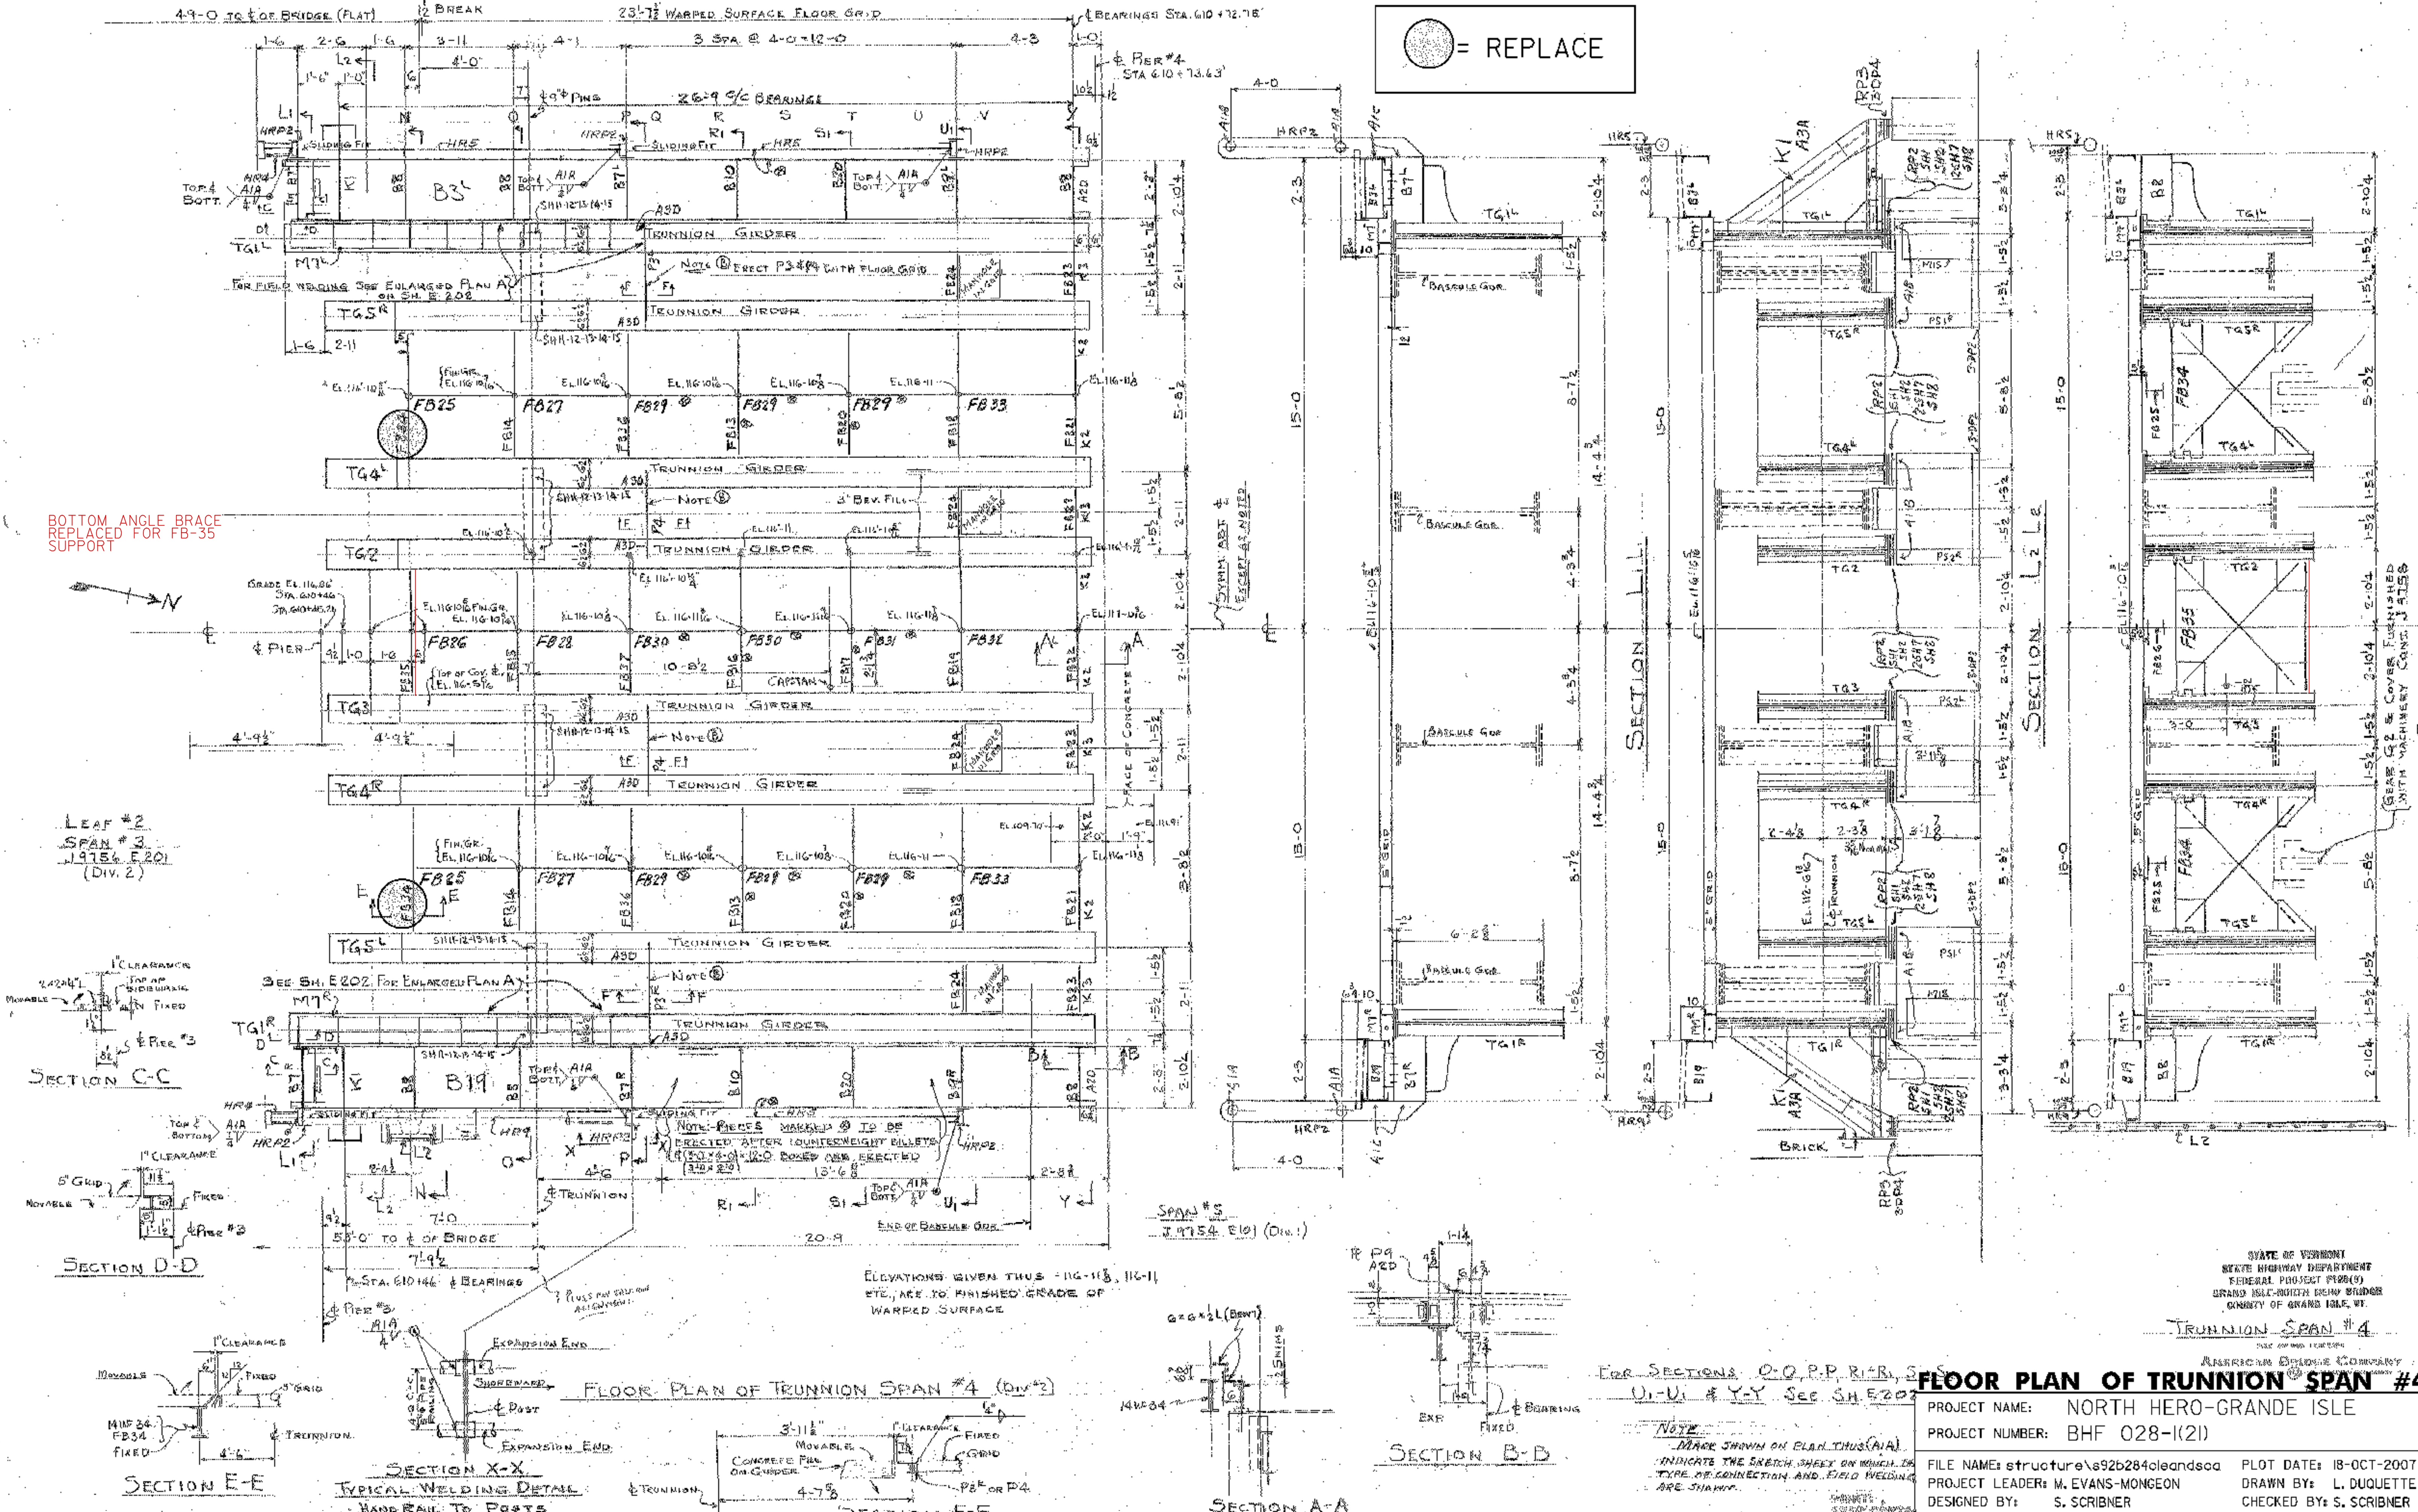
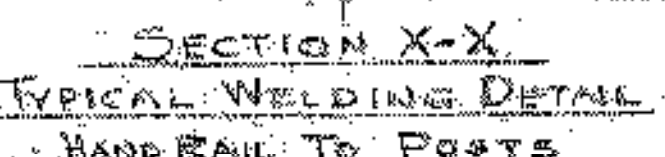
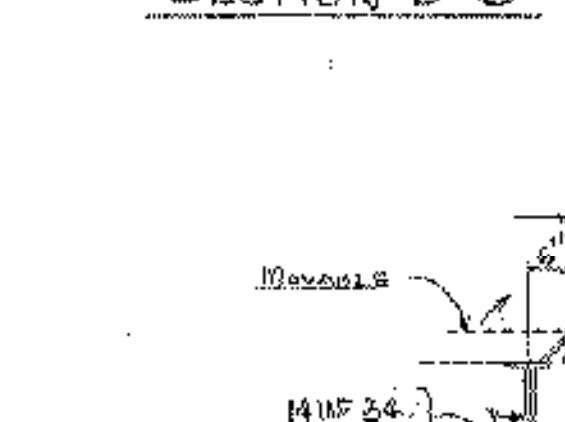


● = REPLACE

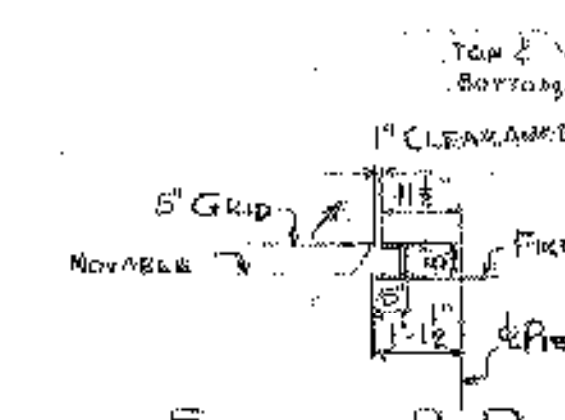


BOTTOM ANGLE BRACE REPLACED FOR FB-35 SUPPORT

LEAF #2
SPAN #3
1975 F 201
(Div. 2)

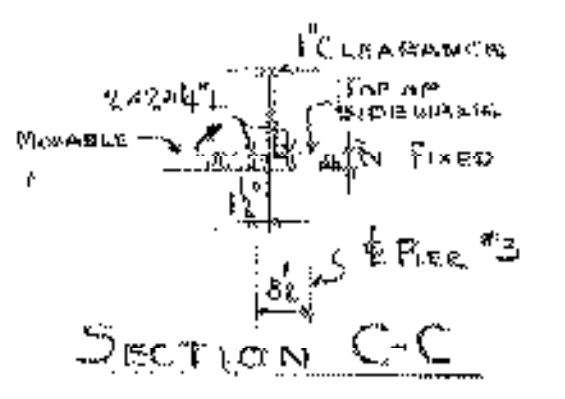

SPAN #5
1975 F 101 (Div. 1)

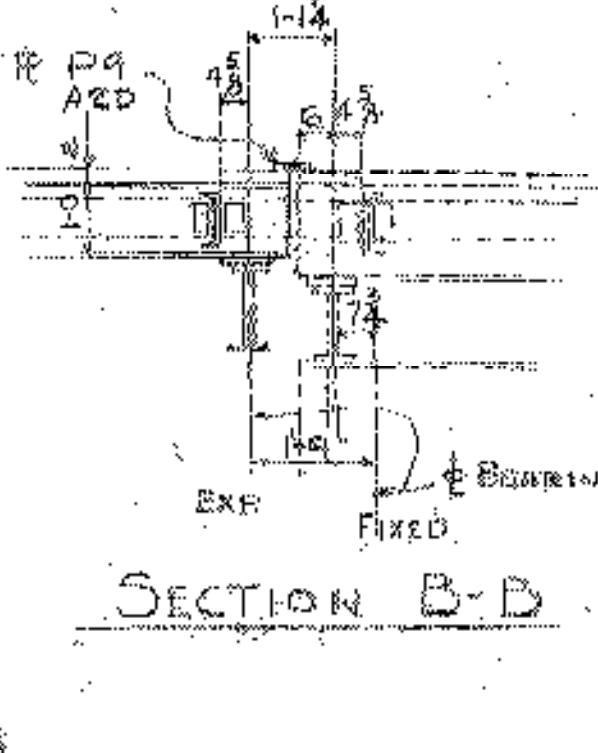

NOTE:
MARK SHOWN ON PLAN, THUS (A/A) INDICATE THE SHEET ON WHICH THE TYPE OF CONNECTION AND FIELD WELDING ARE SHOWN.

FLOOR PLAN OF TRUNNION SPAN #4

PROJECT NAME: NORTH HERO-GRADE ISLE
PROJECT NUMBER: BHF 028-(K21)
FILE NAME: structure\92b284cleandsoa
PLOT DATE: 18-OCT-2007
PROJECT LEADER: M. EVANS-MONGEON
DESIGNED BY: S. SCRIBNER
DRAWN BY: L. DUQUETTE
CHECKED BY: S. SCRIBNER
SHEET 17 OF 41

STATE OF VERMONT
HIGHWAY DEPARTMENT
FEDERAL PROJECT #200(3)
GRAND ISLE-NORTH HERO BRIDGE
COUNTY OF GRAND ISLE, VT.

TRUNNION SPAN #4
AMERICAN BRIDGE COMPANY