
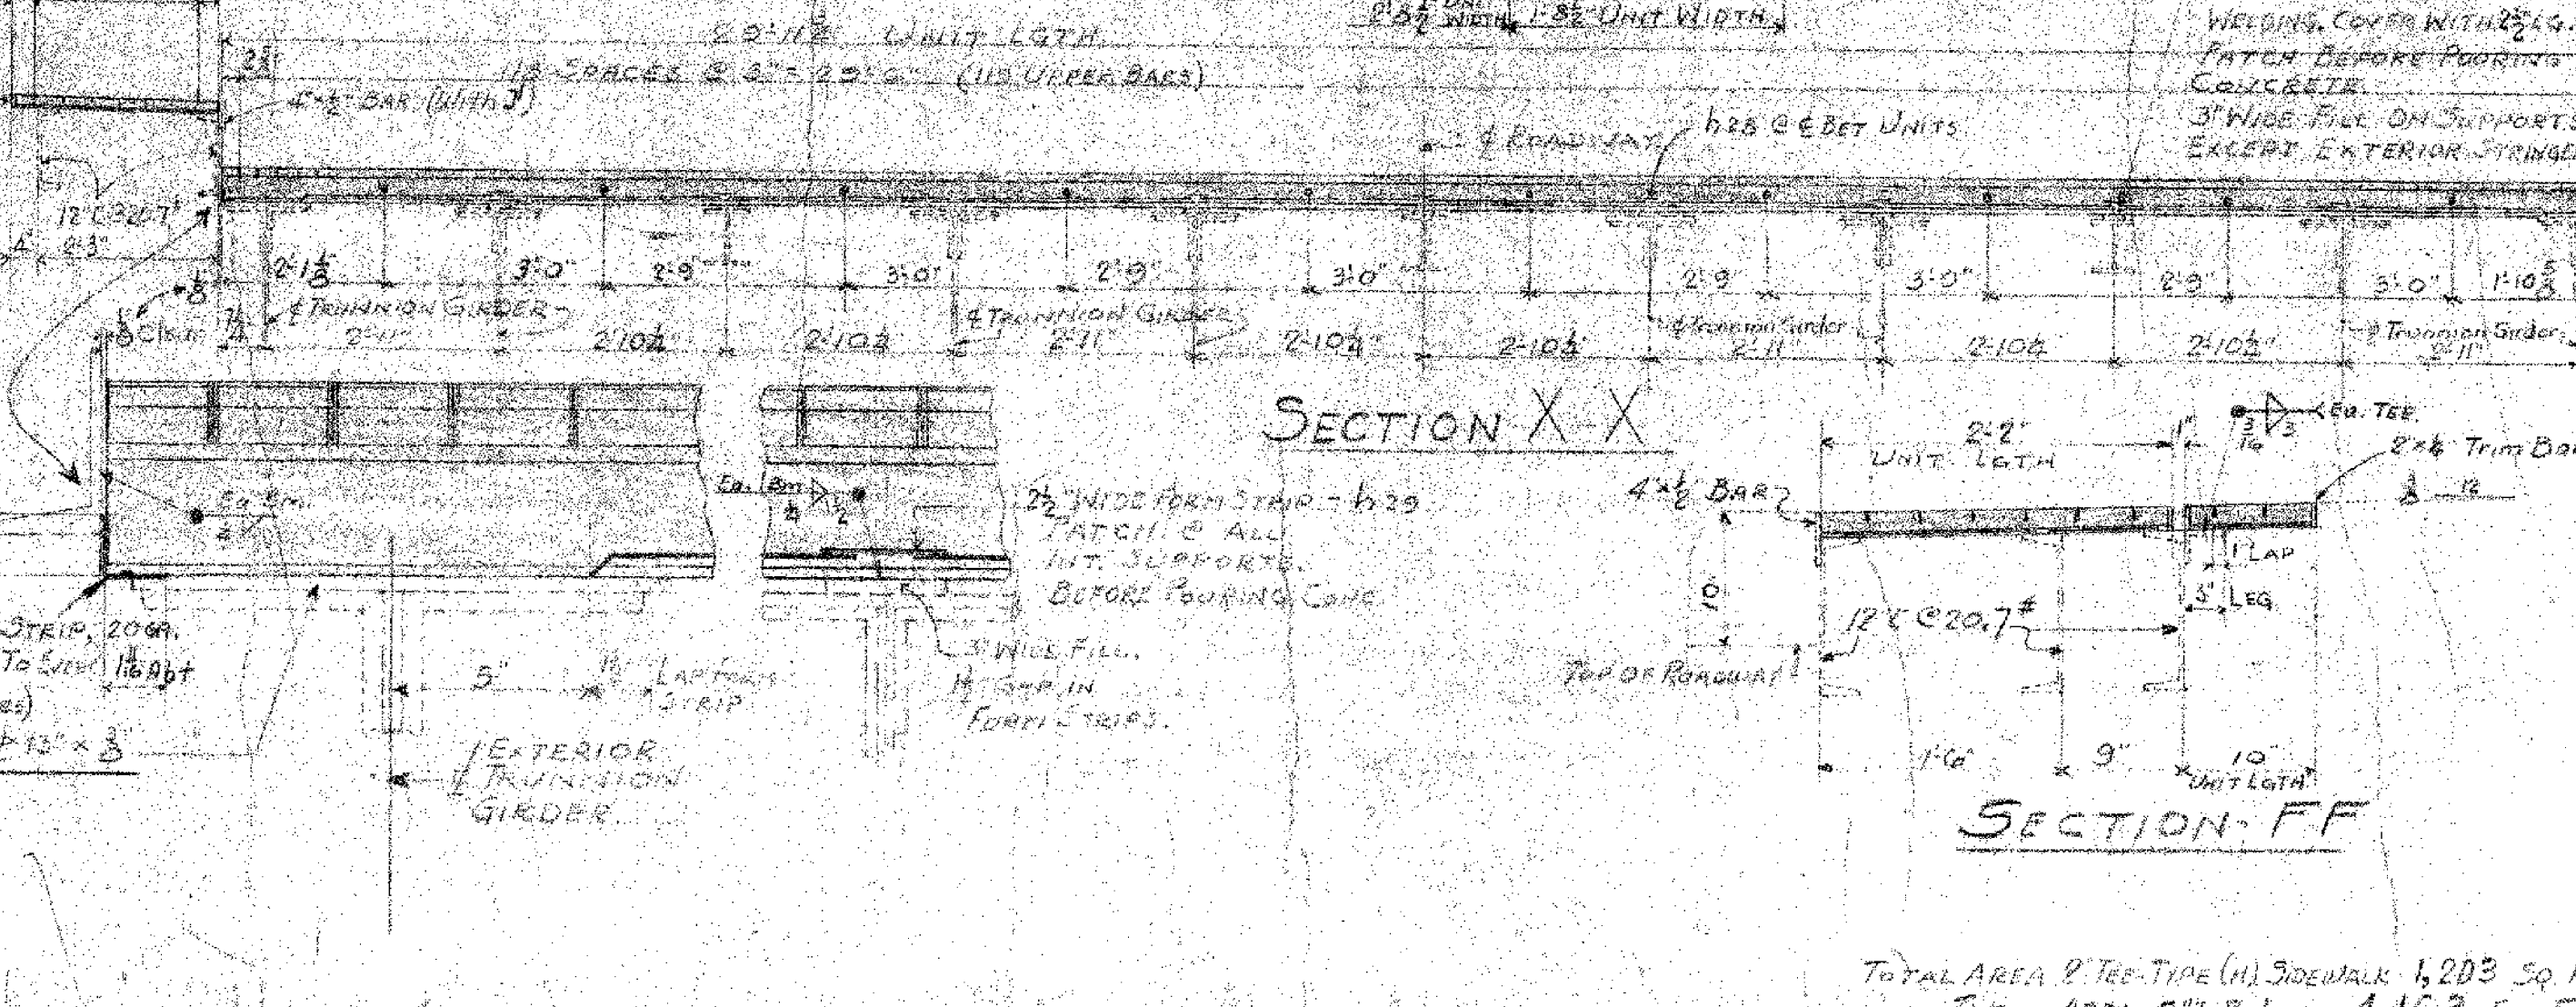
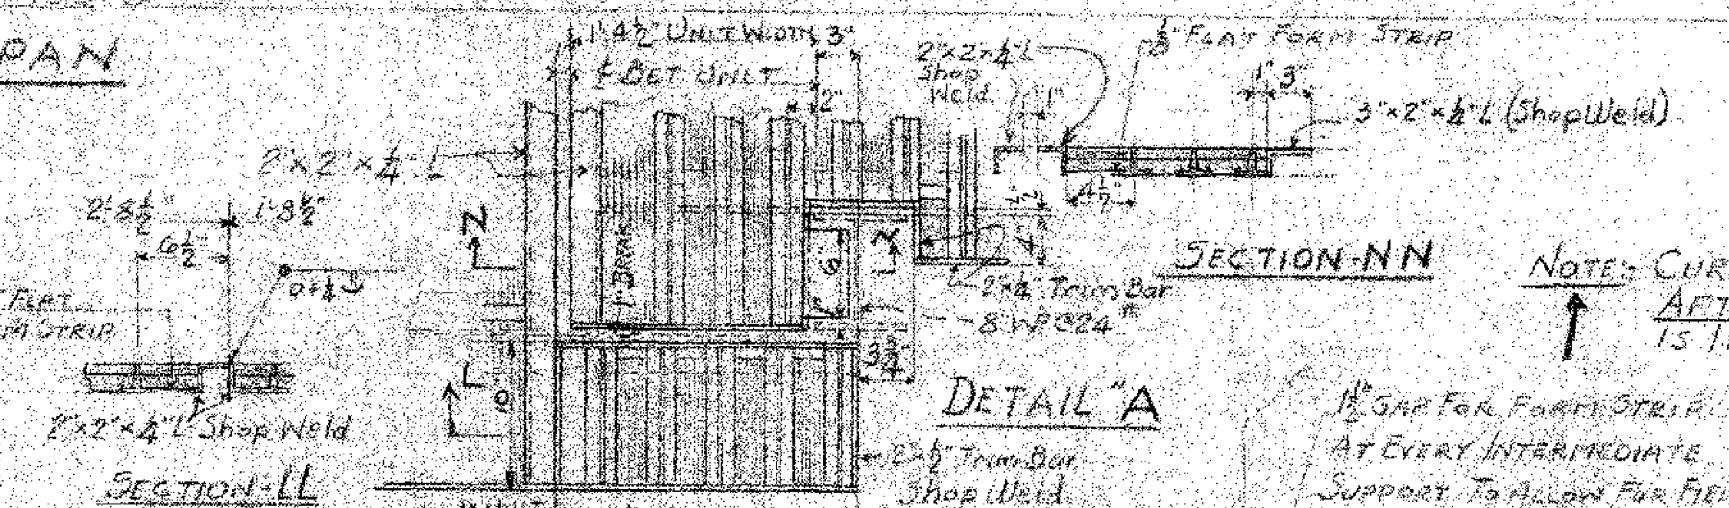


PLAN SOUTH SPAN

ERECTION NOTE:
 PLACE UNITS WITH MARKED END OF UNITS LOCATED AS SHOWN ON PLAN.
 DURING ERECTION OF UNITS, CARE MUST BE EXERCISED TO PLACE EACH UNIT IN ITS PROPER LOCATION, MEASURING IN ALL CASES FROM SOME FIXED POINT, AS OTHERWISE A CUMULATIVE ERROR IN SPACING WILL APPEAR, OUSING THE SPACE FOR THE FINAL UNITS TO BE MORE OR LESS THAN THE ACTUAL WIDTH OF UNITS.

GENERAL NOTES:
 INSPECTION: MILL
 I-BEAM-LOK UNITS TO BE FURNISHED FLAT; ANY CAMBERING REQUIRED TO CONFORM TO SUPPORTING STRUCTURAL STEEL IS TO BE DONE IN FIELD.
 MATERIAL SHOWN IN DOT & DASH LINES, NOT INCLUDED IN I-BEAM-LOK CONTRACT.
 SHOP PAINT: OPEN PORTION OF FLOORING TO HAVE ONE COAT OF DU PONT DULUX RED LEAD PRIMER FILLED PORTION TO HAVE ONE COAT OF DU PONT DULUX RED LEAD PRIMER ON UNDERSIDE OF UNITS & ON OUTSIDE FACE OF TRIM MATERIAL.
 FOR NOTES ABOUT FORM STRIPS, SEE SHOP DETAILS FOR FIELD WELDING 2" (H) TEE-TYPE SIDEWALK, SEE STD. ERECTION FOLDER FOR SHOP DETAILS OF 5" I-BEAM-LOK. SEE SHEETS # F-5376 THRU # F-5384 FOR TEE-TYPE SIDEWALK # F-5385 THRU # F-5389. BEAM PUNCH SH.T. # 15-25115-3504 FOR SHOP BAR PUNCH SH.T. # 15-25115-3504 USE ONLY.
 FOR ADDITIONAL PLANS & SECT. SEE R4893-9.

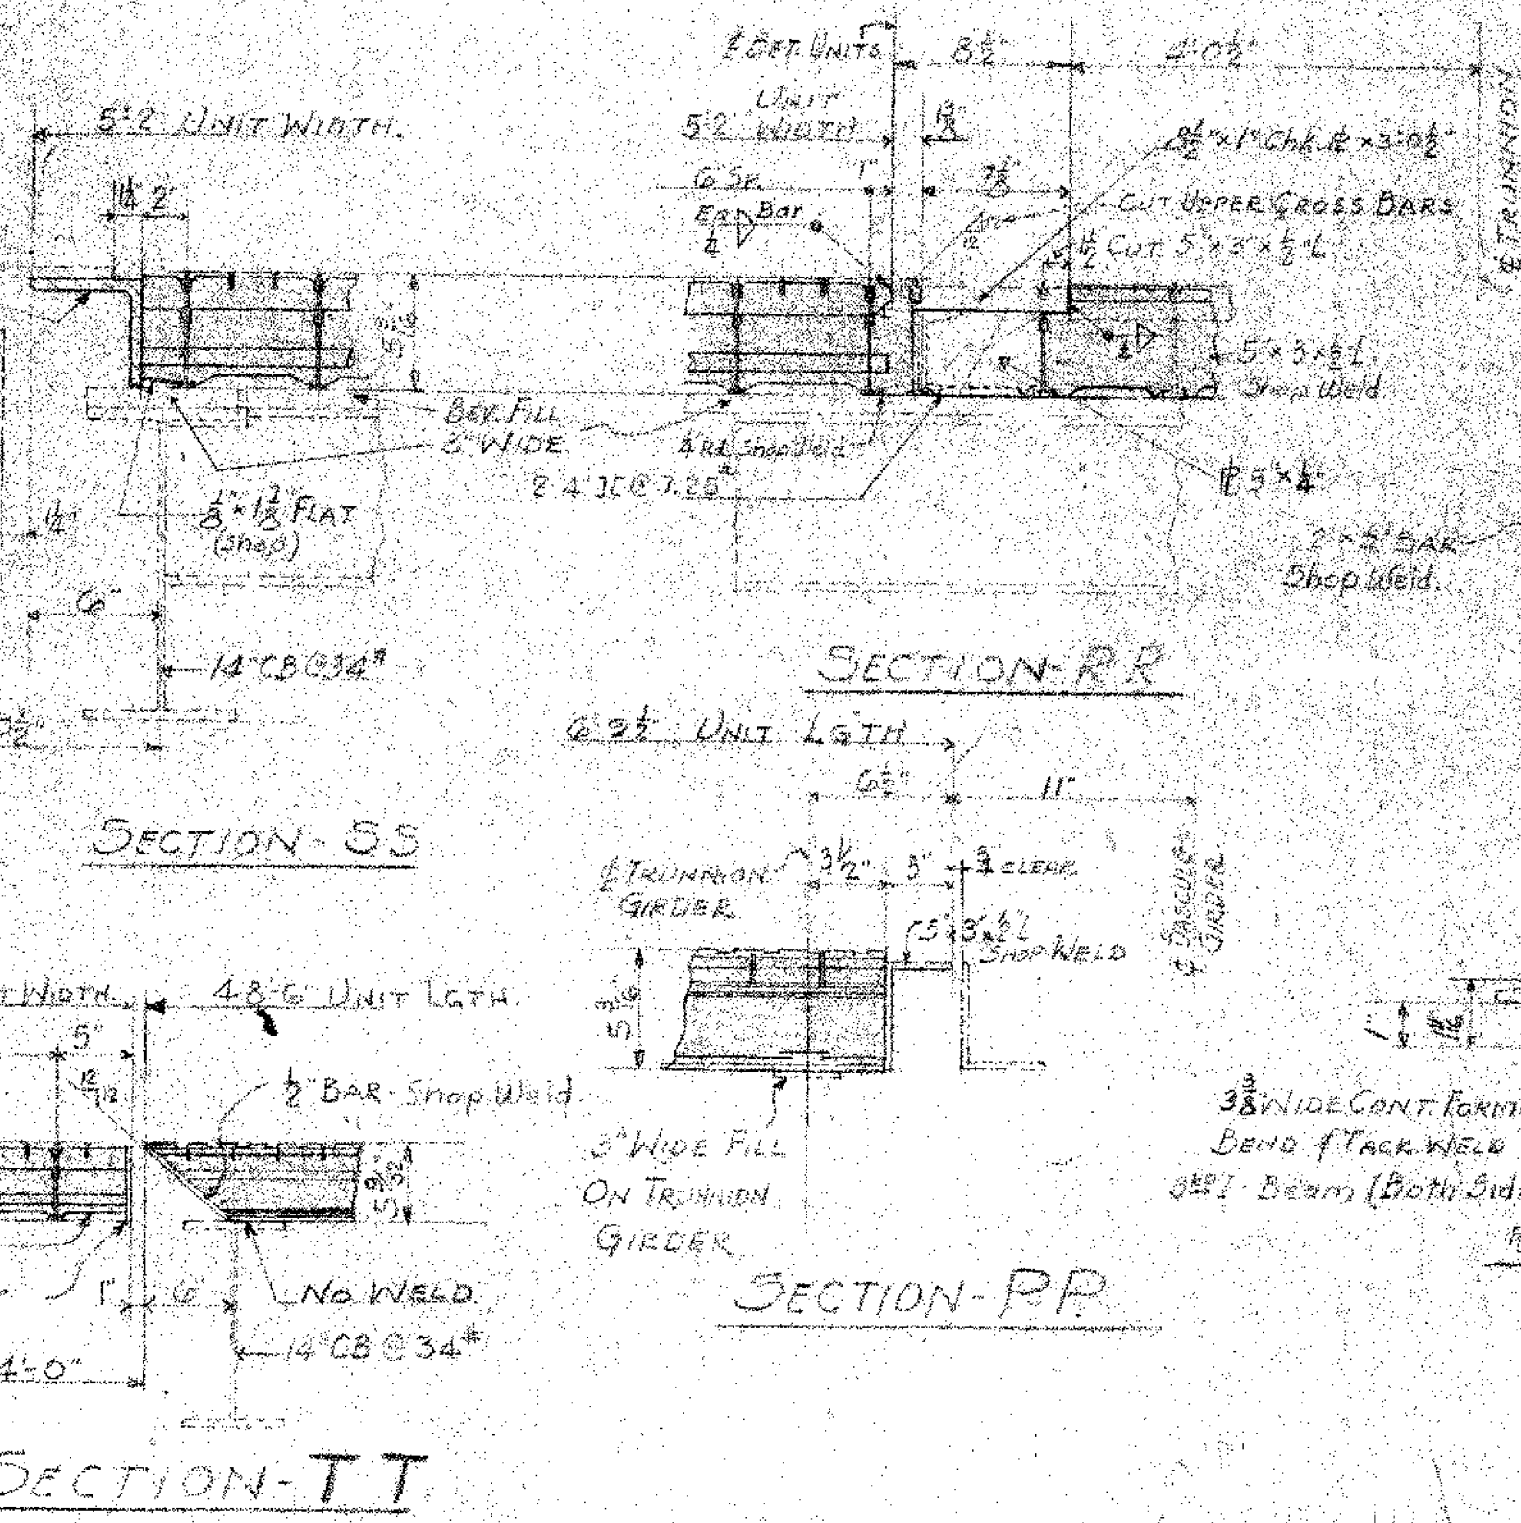

REFERENCE SHEET

PROJECT NAME: NORTH HERO-GRANDE ISLE
 PROJECT NUMBER: BHF 028-1(K2I)

FILE NAME: structure\s92b284cleandsca PLOT DATE: 18-OCT-2007
 PROJECT LEADER: M. EVANS-MONGEON DRAWN BY: L. DUQUETTE
 DESIGNED BY: S. SCRIBNER CHECKED BY: S. SCRIBNER
 SHEET 39 OF 41