


PLAN - NORTH SPAN

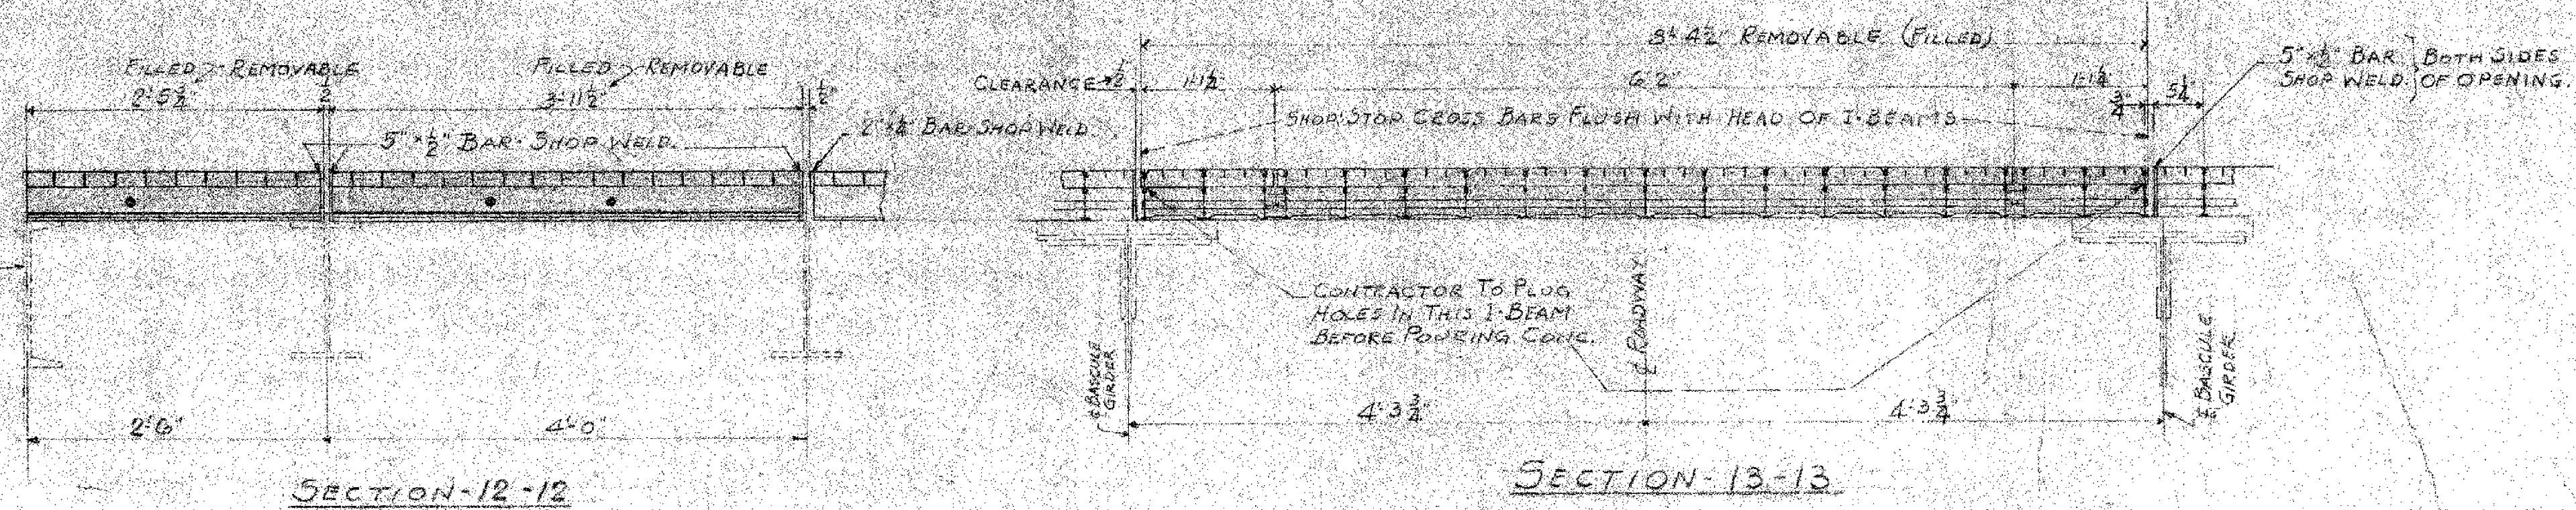

SECTION-12-12

SECTION-13-13

ERECTION NOTE:
 PLACE UNITS, WITH MARKED END OF UNITS, LOCATED AS SHOWN ON PLAN.
 DURING ERECTION OF UNITS, CARE MUST BE EXERCISED TO PLACE EACH UNIT IN ITS PROPER LOCATION, MEASURING IN ALL CASES FROM SOME FIXED POINT, AS OTHERWISE A CUMULATIVE ERROR IN SPACING WILL APPEAR, CAUSING THE SPACE FOR THE FINAL UNITS TO BE MORE OR LESS THAN THE ACTUAL WIDTH OF UNITS.

FOR GEN. NOTES & ADDITIONAL PLANS: F-4357
 FOR SECTIONS: SEE F-4357 & F-4359

5 1/2" BEAM-LOK OPEN (TR & PL TYPE) FLOORING PLAN
 2" TEE-TYPE SIDEWALK (A) PLAN
 DOUBLE LEAF BASCULE SPAN (NORTH)
 GRAND ISLE - NORTH HERO BRIDGE,
 COUNTY OF GRAND ISLE, VT.
 AMERICAN BRIDGE DIV. ORDER 79357 CONG.

REFERENCE SHEET

PROJECT NAME:	NORTH HERO-GRANDE ISLE
PROJECT NUMBER:	BHF 028-1(21)
FILE NAME:	structure\s92b284cleandscd
PROJECT LEADER:	M. EVANS-MONGEON
DESIGNED BY:	S. SCRIBNER
PLOT DATE:	18-OCT-2007
DRAWN BY:	L. DUQUETTE
CHECKED BY:	S. SCRIBNER
SHEET	40 OF 41