


REVISIONS		
REV	DESCRIPTION	DATE
0	INITIAL SUBMITTAL FOR REVIEW	10/24/2007

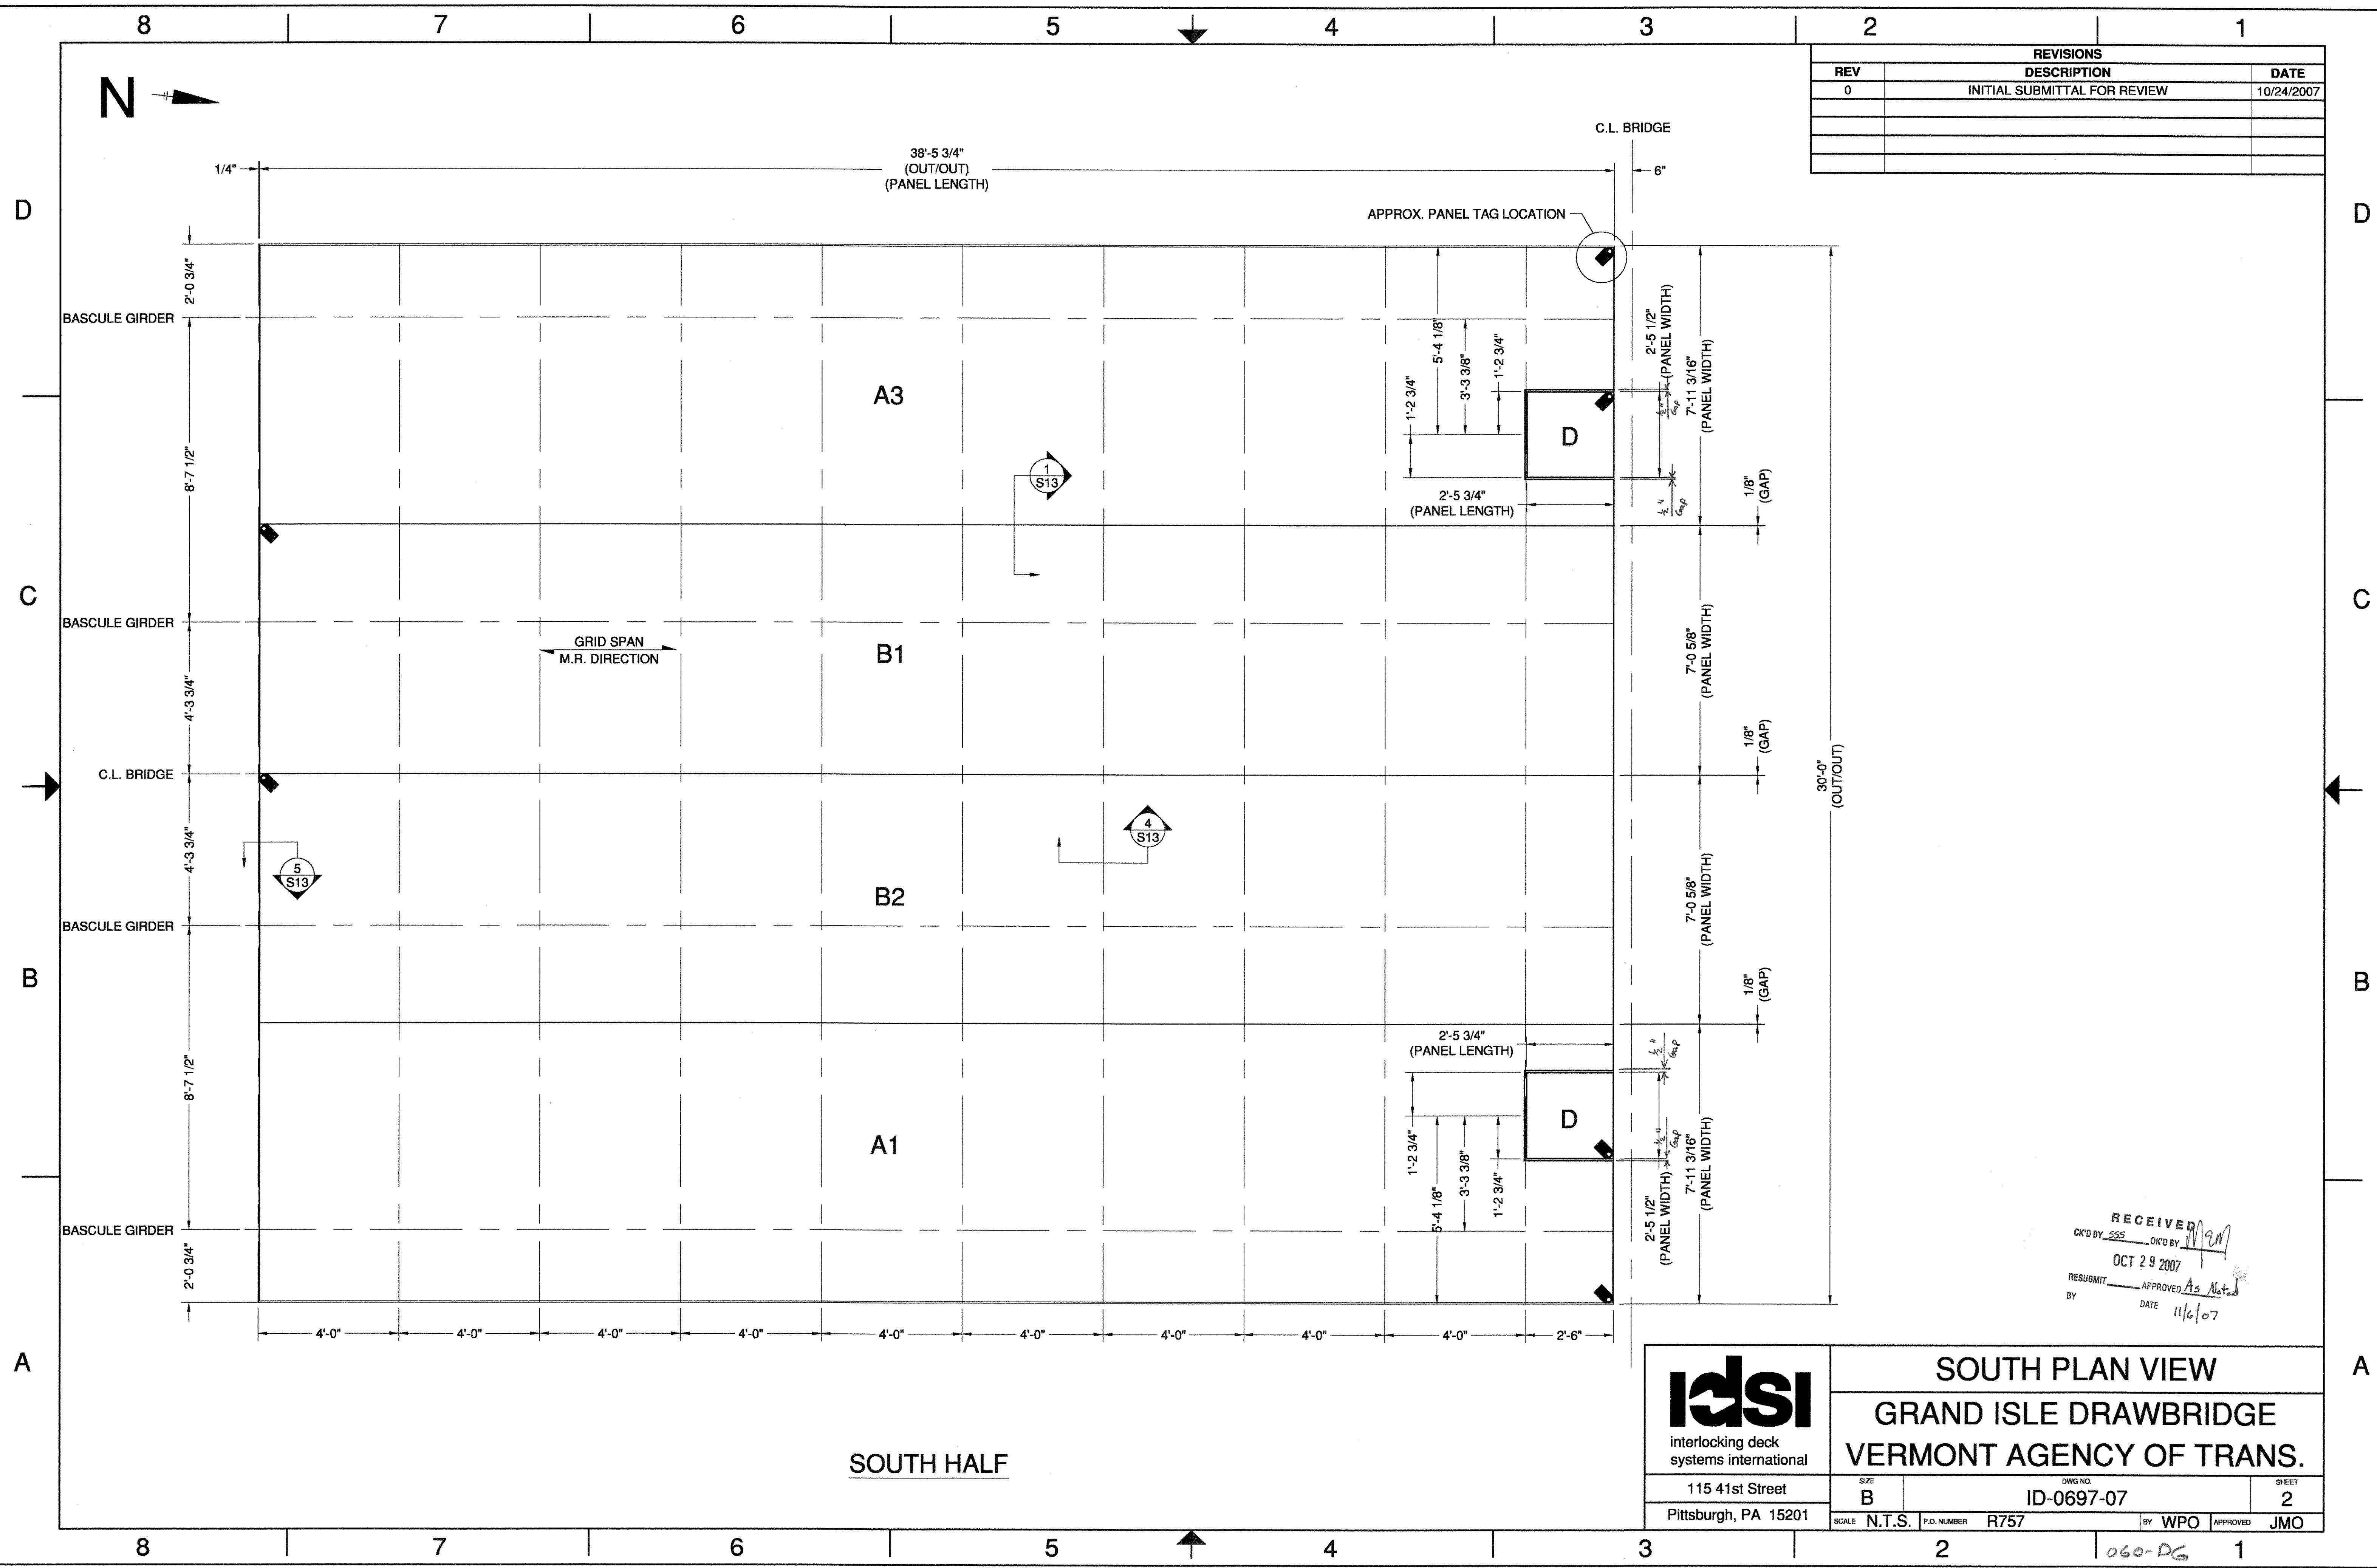

RECEIVED  
 OK'D BY *SSS* OK'D BY *MW*  
 OCT 29 2007  
 RESUBMIT APPROVED *As Noted*  
 BY DATE 11/6/07

 interlocking deck systems international 115 41st Street Pittsburgh, PA 15201	<b>SOUTH PLAN VIEW</b> <b>GRAND ISLE DRAWBRIDGE</b> <b>VERMONT AGENCY OF TRANS.</b>	
	SIZE <b>B</b>	DWG NO. <b>ID-0697-07</b>
SCALE N.T.S.	P.O. NUMBER R757	BY WPO APPROVED JMO

060-DG 1