

8 7 6 5 4 3 2 1


**BILL OF MATERIALS**

PANEL B (QUANTITIES ARE PER PANEL - MULTIPLY BY TOTAL NUMBER OF PANELS)


PART	DESCRIPTION	QUANTITY	LENGTH	WIDTH	THICKNESS	MATERIAL TYPE	TOLERANCE
P-B1	5 3/16" MAIN RAIL	12	38'-5 1/4"	-----	-----	ASTM A709 GR. 50	+/- 1/4"
P-B2	CROSS BAR	123	7'-0 5/8"	2"	1/4"	ASTM A709 GR. 50	+0/- 1/8"
P-B3	SUPPLEMENTAL BAR	11	38'-5 1/4"	1"	1/4"	ASTM A709 GR. 50	+/- 1/4"
P-B4	DIAGONAL BAR	22	38'-5 1/4"	1"	1/4"	ASTM A709 GR. 50	+0/- 1/4"
TBB-1	TRIM BAR	2	7'-0 5/8"	5"	1/4"	ASTM A709 GR. 50	+0/- 1/8"
BDP-1	BOLTDOWN PLATE	66	6 5/16"	3"	3/8"	ASTM A709 GR. 50	+/- 1/32"
BT-1	BOLT	60	2"	-----	3/4" Ø	ASTM A325 HDG	-----
BT-2	BOLT	6	2 1/2"	-----	3/4" Ø	ASTM A325 HDG	-----
FW	WASHER	60	-----	-----	3/4" Ø	ASTM F436 HDG	-----
TW	TAPERED WASHER	6	-----	-----	3/4" Ø	ASTM A563 HDG	-----
NT	NUT	66	-----	-----	3/4" Ø	ASTM A563 HDG	-----

- SHIPPED LOOSE
- SHIPPED LOOSE
REVISIONS		
REV	DESCRIPTION	DATE
0	INITIAL SUBMITTAL FOR REVIEW	10/24/2007

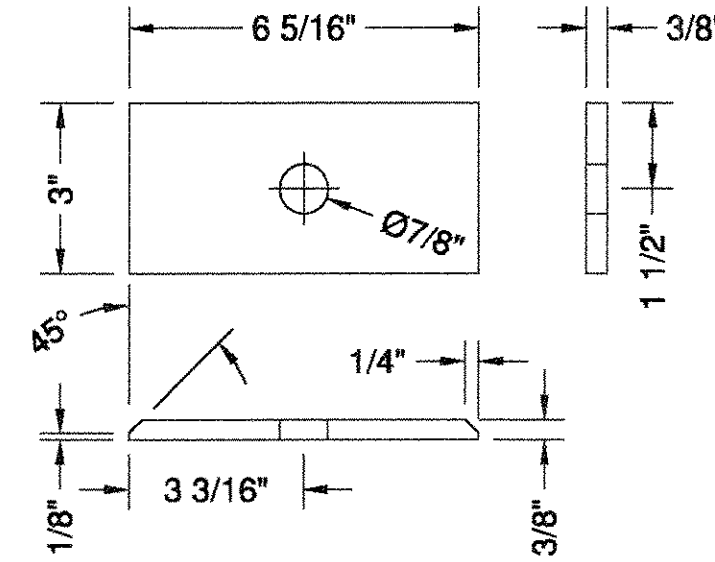


**BDP-1 DETAIL**

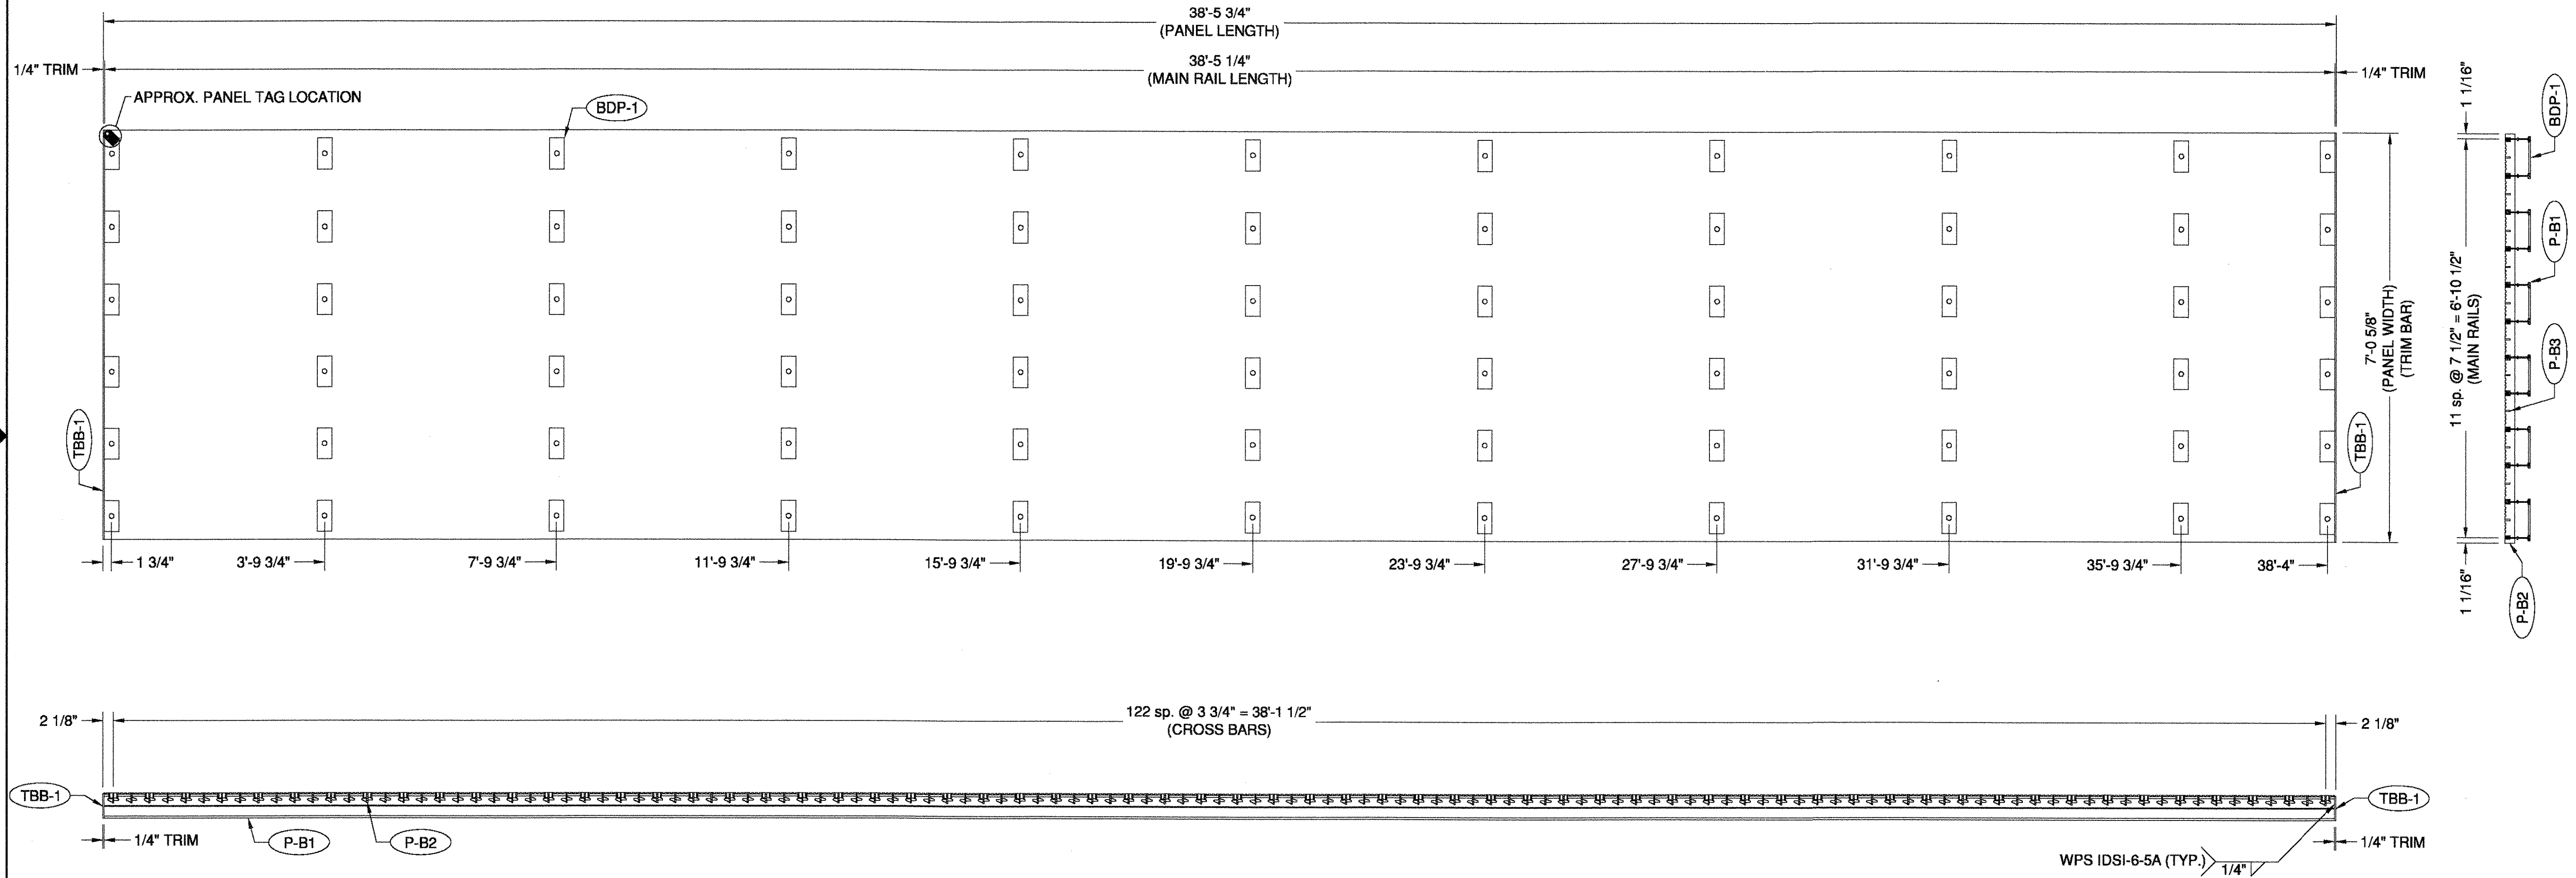

**PANEL B LAYOUT  
2 TOTAL - AS SHOWN**

RECEIVED  
 CTD BY: SSS OK'D BY: *MJM*  
 OCT 29 2007  
 RESUBMIT APPROVED *[Signature]*  
 BY: DATE 11/6/07

 interlocking deck systems international 115 41st Street Pittsburgh, PA 15201	<b>PANEL B LAYOUT</b> <b>GRAND ISLE DRAWBRIDGE</b> <b>VERMONT AGENCY OF TRANS.</b>		
	SIZE <b>B</b>	DWG NO. <b>ID-0697-07</b>	SHEET <b>6</b>
	SCALE: N.T.S.	P.O. NUMBER: R757	BY: WPO APPROVED: JMO

8 7 6 5 4 3 2 1 064-06 1