


NOTES

1. THE PAVEMENT WEARING COURSE SHALL BE TYPE III, ITEM 406.27. THE BINDER COURSE SHALL BE TYPE II, ITEM 406.27.
2. COLD PLANING TO BE COMPLETED ACCORDING TO THE DETAILS SHOWN ON THE PROJECT DETAIL SHEET.
3. THREE FEET OF BACKING IS REQUIRED BEHIND THE FACE OF GUARD RAIL WITH 6' POSTS. IF THIS CAN NOT BE OBTAINED THEN 8' POSTS SHALL BE USED.
4. EMULSIFIED ASPHALT SHALL BE APPLIED ON ALL EXISTING SURFACES, ALL COLD PLANED SURFACES, AND BETWEEN ALL COURSES OF PAVEMENT AT THE RATE OF 0.015 GAL/SY OR AS DIRECTED BY THE RESIDENT ENGINEER.
5. BITUMINOUS CONCRETE PAVEMENT TOLERANCE = ±1/4". (TOTAL PAVEMENT THICKNESS)

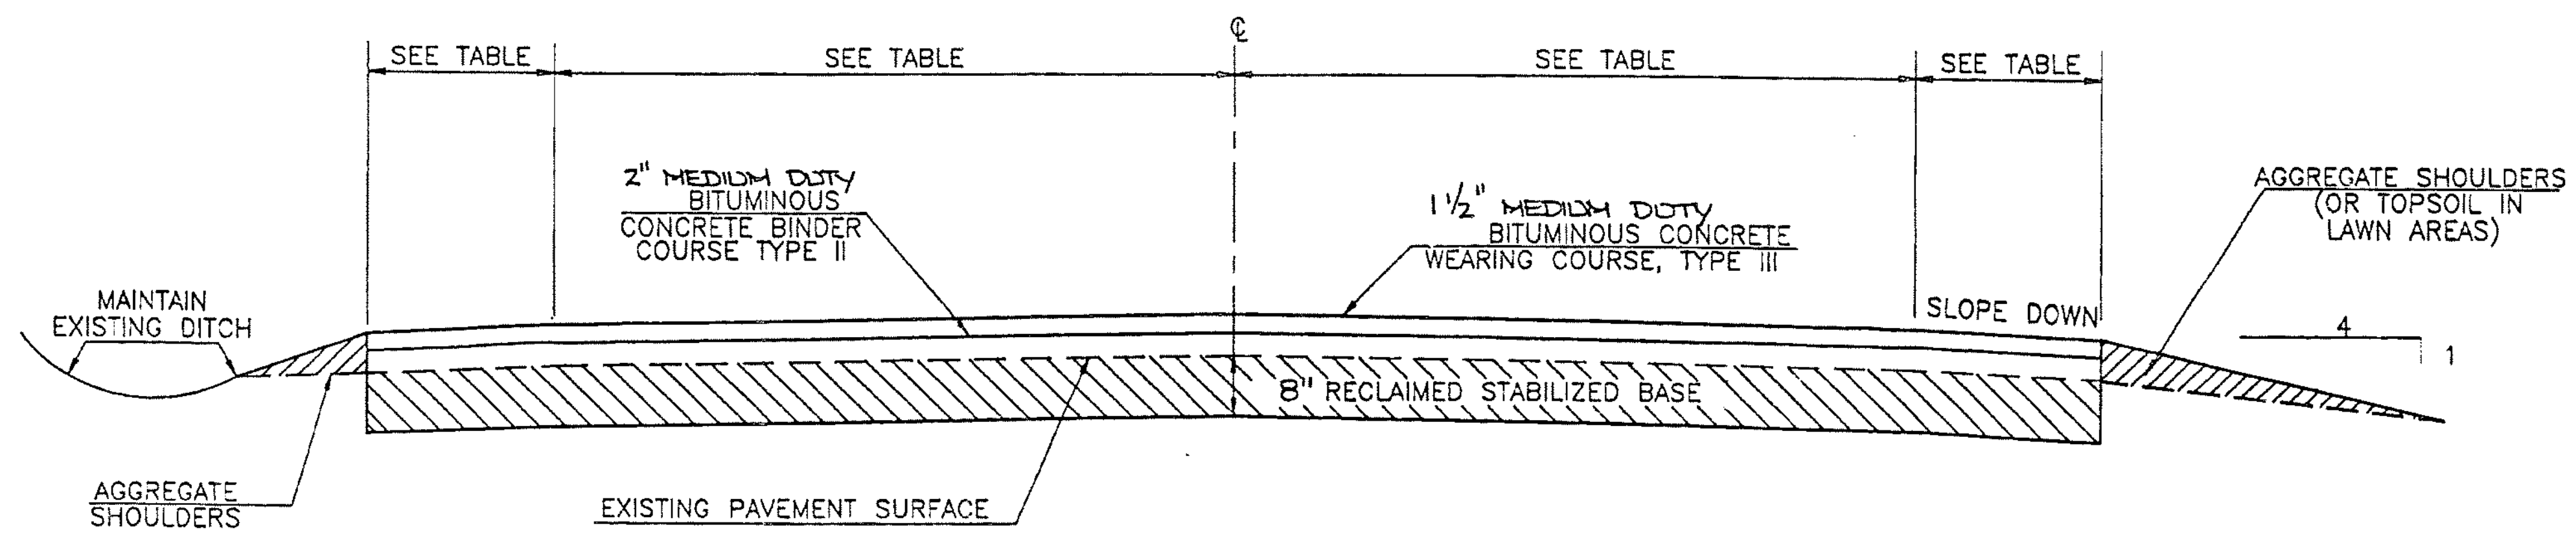

RECLAIMED TYPICAL SECTION

NOT TO SCALE

URBAN AREA - SEED MIXTURE

% WT.	LBS./ACRE	NAME	PUR%	GERM%
42.5	34.0	CREEPING RED FESCUE	98	85
10.0	8.0	PERENNIAL RYEGRASS	95	90
42.5	34.0	KENTUCKY BLUEGRASS	85	85
5.0	4.0	ANNUAL RYEGRASS	95	85
100.0	80.0			

SEED MIXTURE:
SHALL NOT HAVE A WEED CONTENT EXCEEDING 0.40% BY WEIGHT AND SHALL BE FREE OF ALL NOXIOUS SEED.

SEED:
TO BE APPLIED PER SEEDING FORMULAS OR AS DIRECTED BY THE ENGINEER.

FERTILIZER:
FORMULA 10-20-10, TO BE USED WITH SEED, APPLIED AT THE RATE OF 500 LBS./ACRE. (HYDRO-SEEDERS MAY USE 15-15-15 FORMULA)

AGRICULTURAL LIMESTONE:
TO BE APPLIED AT THE RATE OF 2 TONS/ACRE, OR AS DIRECTED BY THE ENGINEER.

HAY MULCH:
TO BE PLACED ON EARTH SLOPES AT THE RATE OF 2 TONS/ACRE, OR AS DIRECTED BY THE ENGINEER.

TOPSOIL:
TO BE USED AS INDICATED ON THE PLANS, OR AS DIRECTED BY THE ENGINEER.

MARKER POSTS:
TO BE PLACED AS INDICATED OR AS DIRECTED BY THE ENGINEER.

PROJECT PAVING LIMITS

TOWN	BEGIN MILE MARKER	END MILE MARKER	LANE TYPICAL	WEARING DEPTH	BINDER DEPTH	NOTES
SHEFFIELD	1.800	7.727	2'-11"-11'-2"	1-1/2"	2"	
GLOVER	0.000	1.559	2'-11"-11'-2"	1-1/2"	2"	
NOTE: SHEFFIELD	2.308	2.312	-	-	-	BRIDGE NO. 16 - DO NOT PAVE
SHEFFIELD	2.947	2.953	6'-11"-11'-6"	1-1/4"	-	BRIDGE NO. 17 - COLD PLANE AND PAVE 1-1/4"

<h3>PROJECT TYPICAL SHEET</h3>	SURVEYED BY	N/A	DATE	N/A
	DRAWN BY	WBL	DATE	03/93
	SQUAD LEADER			
	DESIGN FILE NO.			
	IPARM FILE		DATE PLOTTED	
	PROJ. NAME	SHEFFIELD-GLOVER		
PROJ. NO.	STP 9419(1)S			
HTA FILE:	SHTYPXS	SHEET	02 OF	SHEETS