

DURABLE 4" YELLOW LINE

MM 1.800 TO MM 2.000 (SOLID LT. & RT.)
 MM 2.000 TO MM 2.077 (SOLID LT. & DASHED RT.)
 MM 2.077 TO MM 2.160 (DASHED)
 MM 2.160 TO MM 2.310 (DASHED LT. & SOLID RT.)
 MM 2.310 TO MM 2.330 (SOLID LT. & RT.)
 MM 2.330 TO MM 2.440 (SOLID LT. & DASHED RT.)
 MM 2.440 TO MM 2.470 (DASHED)
 MM 2.470 TO MM 2.610 (DASHED LT. & SOLID RT.)
 MM 2.610 TO MM 3.678 (SOLID LT. & RT.)
 (WITH CENTERLINE BREAKS FOR TOWN HIGHWAYS)

DURABLE 4" WHITE LINE

MM 1.800 TO MM 3.678 (SOLID LT. & RT.)
 (WITH EDGE LINE BREAKS FOR TOWN HIGHWAYS)

TEMPORARY 4" YELLOW LINE

MM 1.800 TO MM 2.000 (SOLID LT. & RT.)
 MM 2.000 TO MM 2.077 (SOLID LT. & DASHED RT.)
 MM 2.077 TO MM 2.160 (DASHED)
 MM 2.160 TO MM 2.310 (DASHED LT. & SOLID RT.)
 MM 2.310 TO MM 2.330 (SOLID LT. & RT.)
 MM 2.330 TO MM 2.440 (SOLID LT. & DASHED RT.)
 MM 2.440 TO MM 2.470 (DASHED)
 MM 2.470 TO MM 2.610 (DASHED LT. & SOLID RT.)
 MM 2.610 TO MM 3.678 (SOLID LT. & RT.)
 (WITH CENTERLINE BREAKS FOR TOWN HIGHWAYS)

TEMPORARY 4" WHITE LINE

MM 1.800 TO MM 3.678 (SOLID LT. & RT.)
 (WITH EDGE LINE BREAKS FOR TOWN HIGHWAYS)

DURABLE CROSSWALK WITH DIAGONAL LINES

MM 1.672, 26 LF

DURABLE LETTER OR SYMBOL


MM 1.613, RT. "SCHOOL"
 MM 1.738, LT. "SCHOOL"

INSTALL 37.5 LF OF STEEL BEAM GUARDRAIL WITH STEEL POSTS, (16'R AROUND TH 44) - BUTT TO EXISTING WOOD BRIDGE RAIL (FACE OF NEW RAIL SHALL BE SET FLUSH TO FACE OF EXISTING RAIL) - SEE DETAIL ON SHEET 11.

REMOVE EXISTING 2 CABLE GUARDRAIL, INSTALL A 16'R END TERMINAL AT MM 3.227, 425 LF OF NEW STEEL BEAM GUARDRAIL WITH STEEL POSTS AND A BCT AT MM 3.312 (@ EXIST. DRIVE)

REMOVE EXISTING 2 CABLE GUARDRAIL AND INSTALL A 16'R END TERMINAL AT MM 3.328, 575 LF OF NEW STEEL BEAM GUARDRAIL WITH STEEL POSTS AND A BCT AT MM 3.442

REMOVE EXISTING BEAM GUARDRAIL AND INSTALL 25 LF OF HEAVY DUTY STEEL BEAM GUARDRAIL BEGINNING AT MM 2.942 (APPROACH SCHEDULE 1), 37.5 LF OF NEW BRIDGE RAIL, H.D. STEEL BEAM FASCIA MOUNTED (MOD. 1), 25 LF OF HEAVY DUTY STEEL BEAM GUARDRAIL (APPROACH SCHEDULE 1) AND A BCT AT MM 2.963.

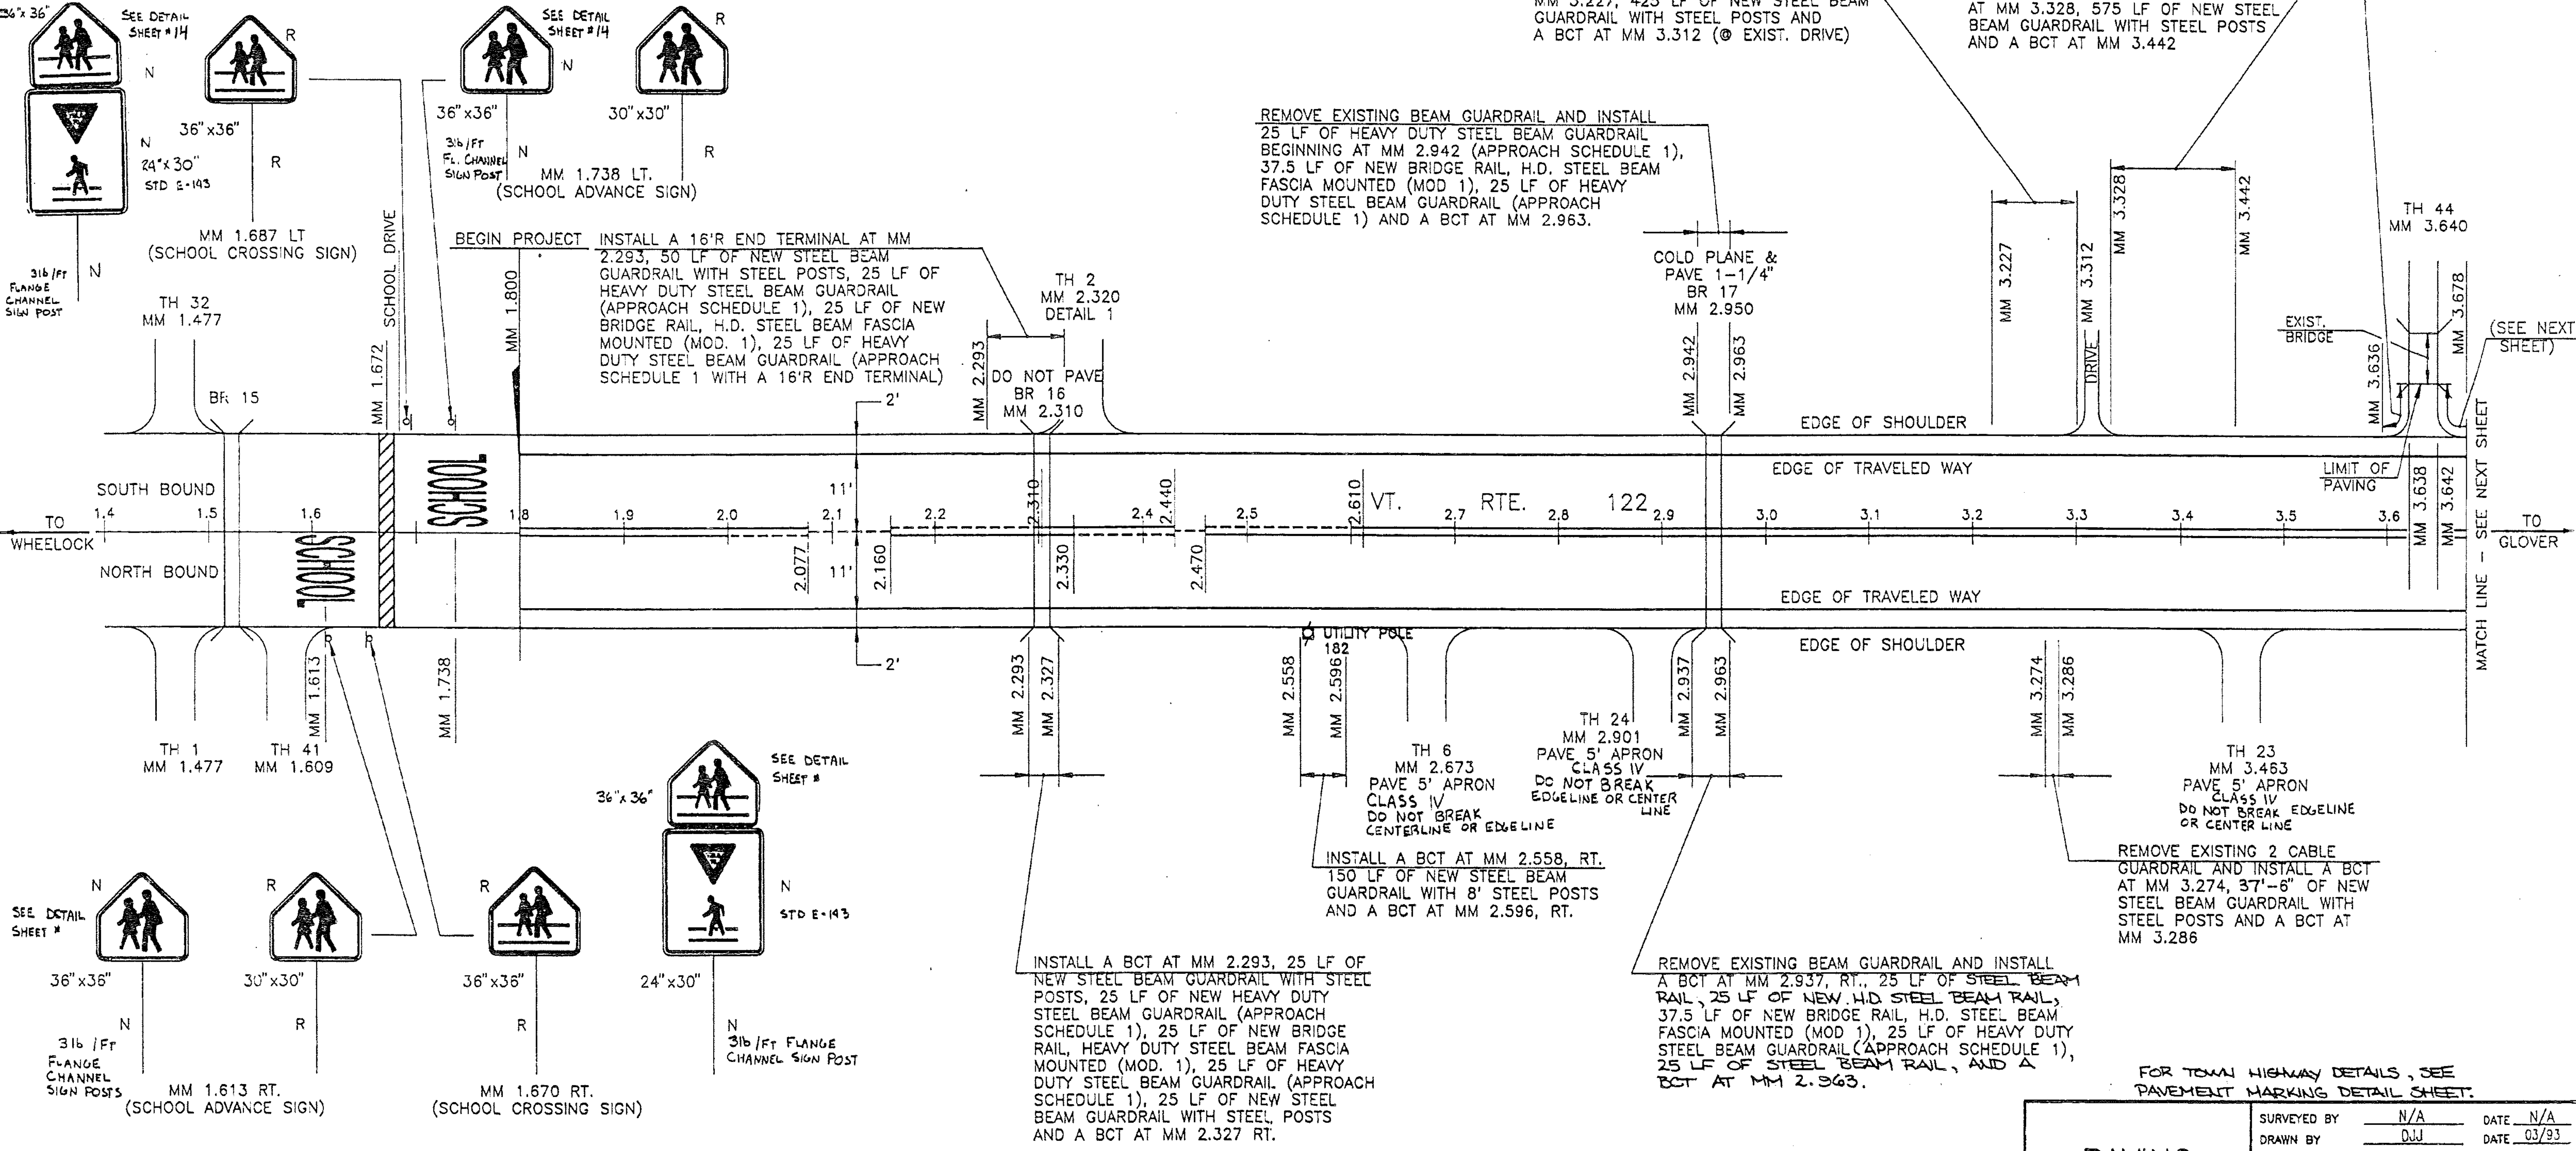

<h3>PAVING PROJECT LAYOUT</h3>	SURVEYED BY	N/A	DATE	N/A
	DRAWN BY	DJJ	DATE	03/93
	SQUAD LEADER			
	DESIGN FILE NO.			
IPARM FILE		DATE PLOTTED		
PROJ. NAME	SHEFFIELD-GLOVER			
PROJ. NO.	STP 9419(1)S			
SHEET	08	OF		SHEETS
SHEET 12 OF 44				

DATUM	
VERTICAL	N/A
HORIZONTAL	N/A