

DURABLE 4" YELLOW LINE

MM 3.678 TO MM 5.310 (SOLID LT & RT)
MM 5.310 TO MM 5.394 (SOLID LT & DASHED RT)
(WITH CENTERLINE BREAKS FOR TOWN HIGHWAYS)

TEMPORARY 4" YELLOW LINE


MM 3.678 TO MM 5.310 (SOLID LT & RT)
MM 5.310 TO MM 5.394 (SOLID LT & DASHED RT)
(WITH CENTERLINE BREAKS FOR TOWN HIGHWAYS)

DURABLE 4" WHITE LINE

MM 3.678 TO MM 5.394 (SOLID LT & RT)
(WITH EDGE LINE BREAKS FOR TOWN HIGHWAYS)

TEMPORARY 4" WHITE LINE

MM 3.678 TO MM 5.394 (SOLID LT & RT)
(WITH EDGE LINE BREAKS FOR TOWN HIGHWAYS)

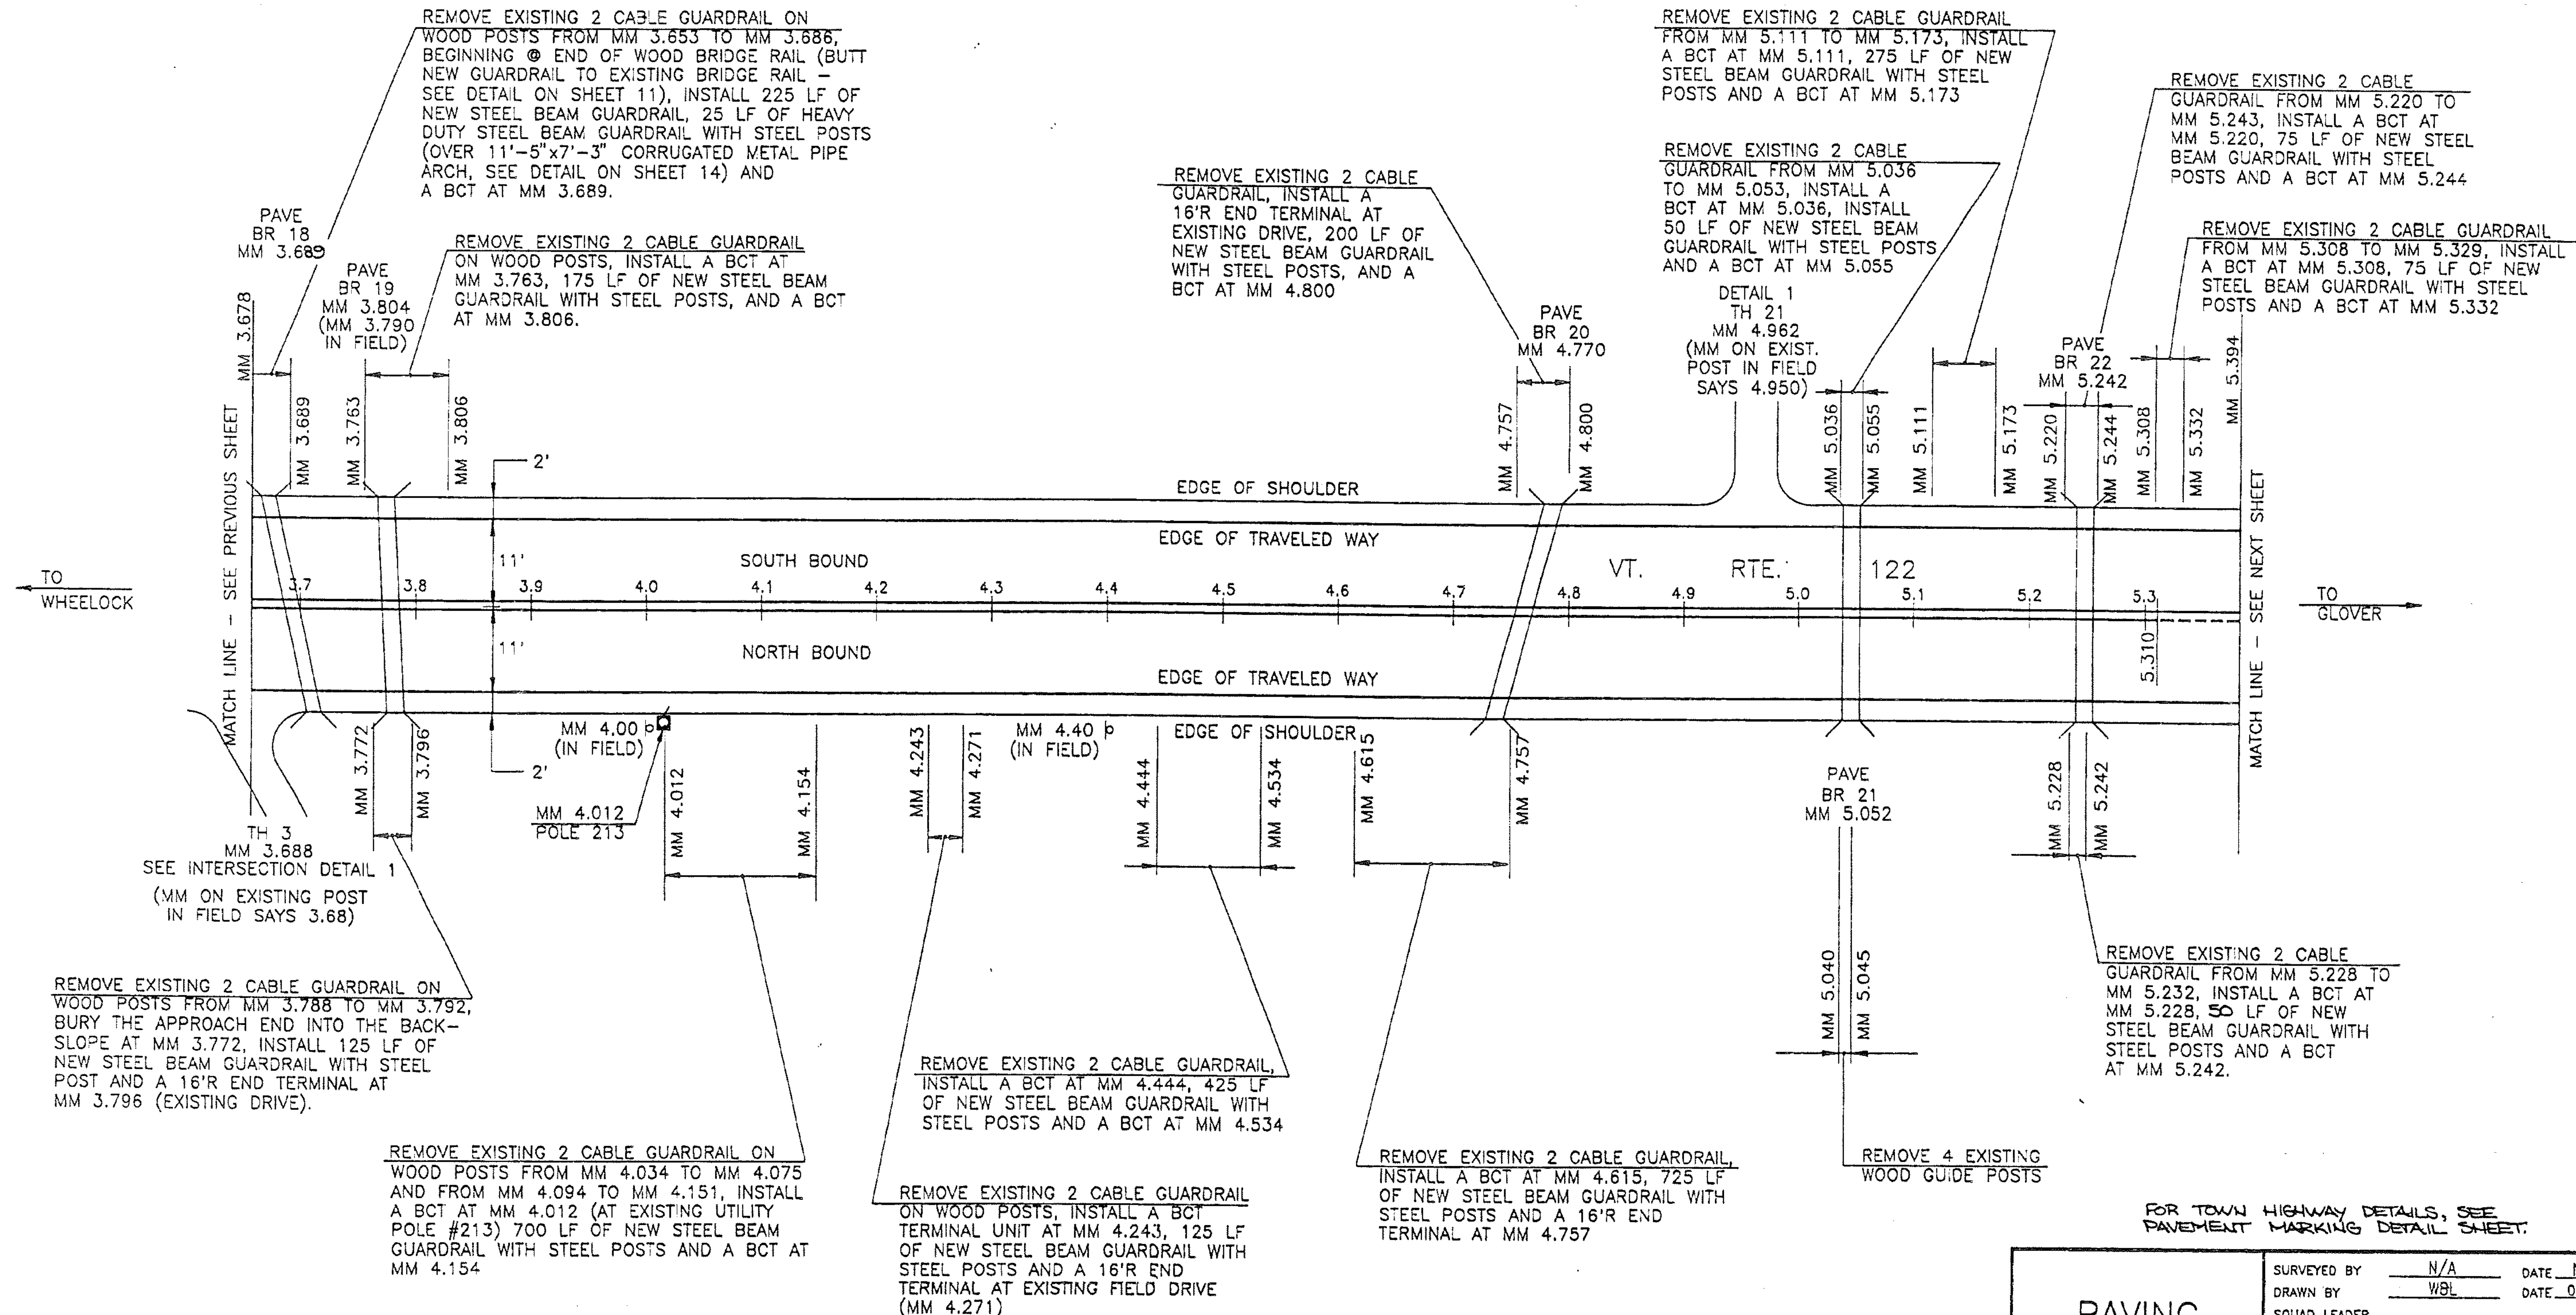

FOR TOWN HIGHWAY DETAILS, SEE PAVEMENT MARKING DETAIL SHEET.

DATUM	N/A
VERTICAL	N/A
HORIZONTAL	N/A

PAVING PROJECT LAYOUT		SURVEYED BY	N/A	DATE	N/A
		DRAWN BY	WBL	DATE	03/93
		SQUAD LEADER			
		DESIGN FILE NO.			
		IPARM		DATE	
		FILE		PLOTTED	
		PROJ. NAME	SHEFFIELD-GLOVER		
		PROJ. NO.	STP 9419(1)S		
HTA FILE: SHFPMK2		SHEET	07	OF	SHEETS