

DURABLE 4" YELLOW LINE

MM 6.532 TO MM 7.600 (SOLID LT. & RT.)
 MM 7.600 TO MM 7.727 (SOLID LT. & DASHED RT.)
 MM 0.000 TO MM 0.105 (GLOVER) (DASHED)
 MM 0.105 TO MM 0.220 (DASHED LT. & SOLID RT.)
 MM 0.220 TO MM 1.559 (SOLID LT. & RT.)
 (WITH CENTERLINE BREAKS FOR TOWN HIGHWAYS)

TEMPORARY 4" YELLOW LINE

MM 6.532 TO MM 7.600 (SOLID LT. & RT.)
 MM 7.600 TO MM 7.727 (SOLID LT. & DASHED RT.)
 MM 0.000 TO MM 0.105 (GLOVER) (DASHED)
 MM 0.105 TO MM 0.220 (DASHED LT. & SOLID RT.)
 MM 0.220 TO MM 1.559 (SOLID LT. & RT.)
 (WITH CENTERLINE BREAKS FOR TOWN HIGHWAYS)

DURABLE LETTER OR SYMBOL

MM 1.407 (GLOVER), VT. RTE. 122 RT: "STOP AHEAD"
 CENTER ON CORRESPONDING EXISTING SIGN AS PER
 STANDARD E-120.


DURABLE 4" WHITE LINE

MM 6.532 TO MM 1.559 (SOLID LT. & RT.)
 (WITH EDGELINE BREAKS FOR TOWN HIGHWAYS)

TEMPORARY 4" WHITE LINE

MM 6.532 TO MM 1.559 (SOLID LT. & RT.)
 (WITH EDGELINE BREAKS FOR TOWN HIGHWAYS)

INTERSECTION DETAIL 2
 MM 1.540 TO MM 1.559

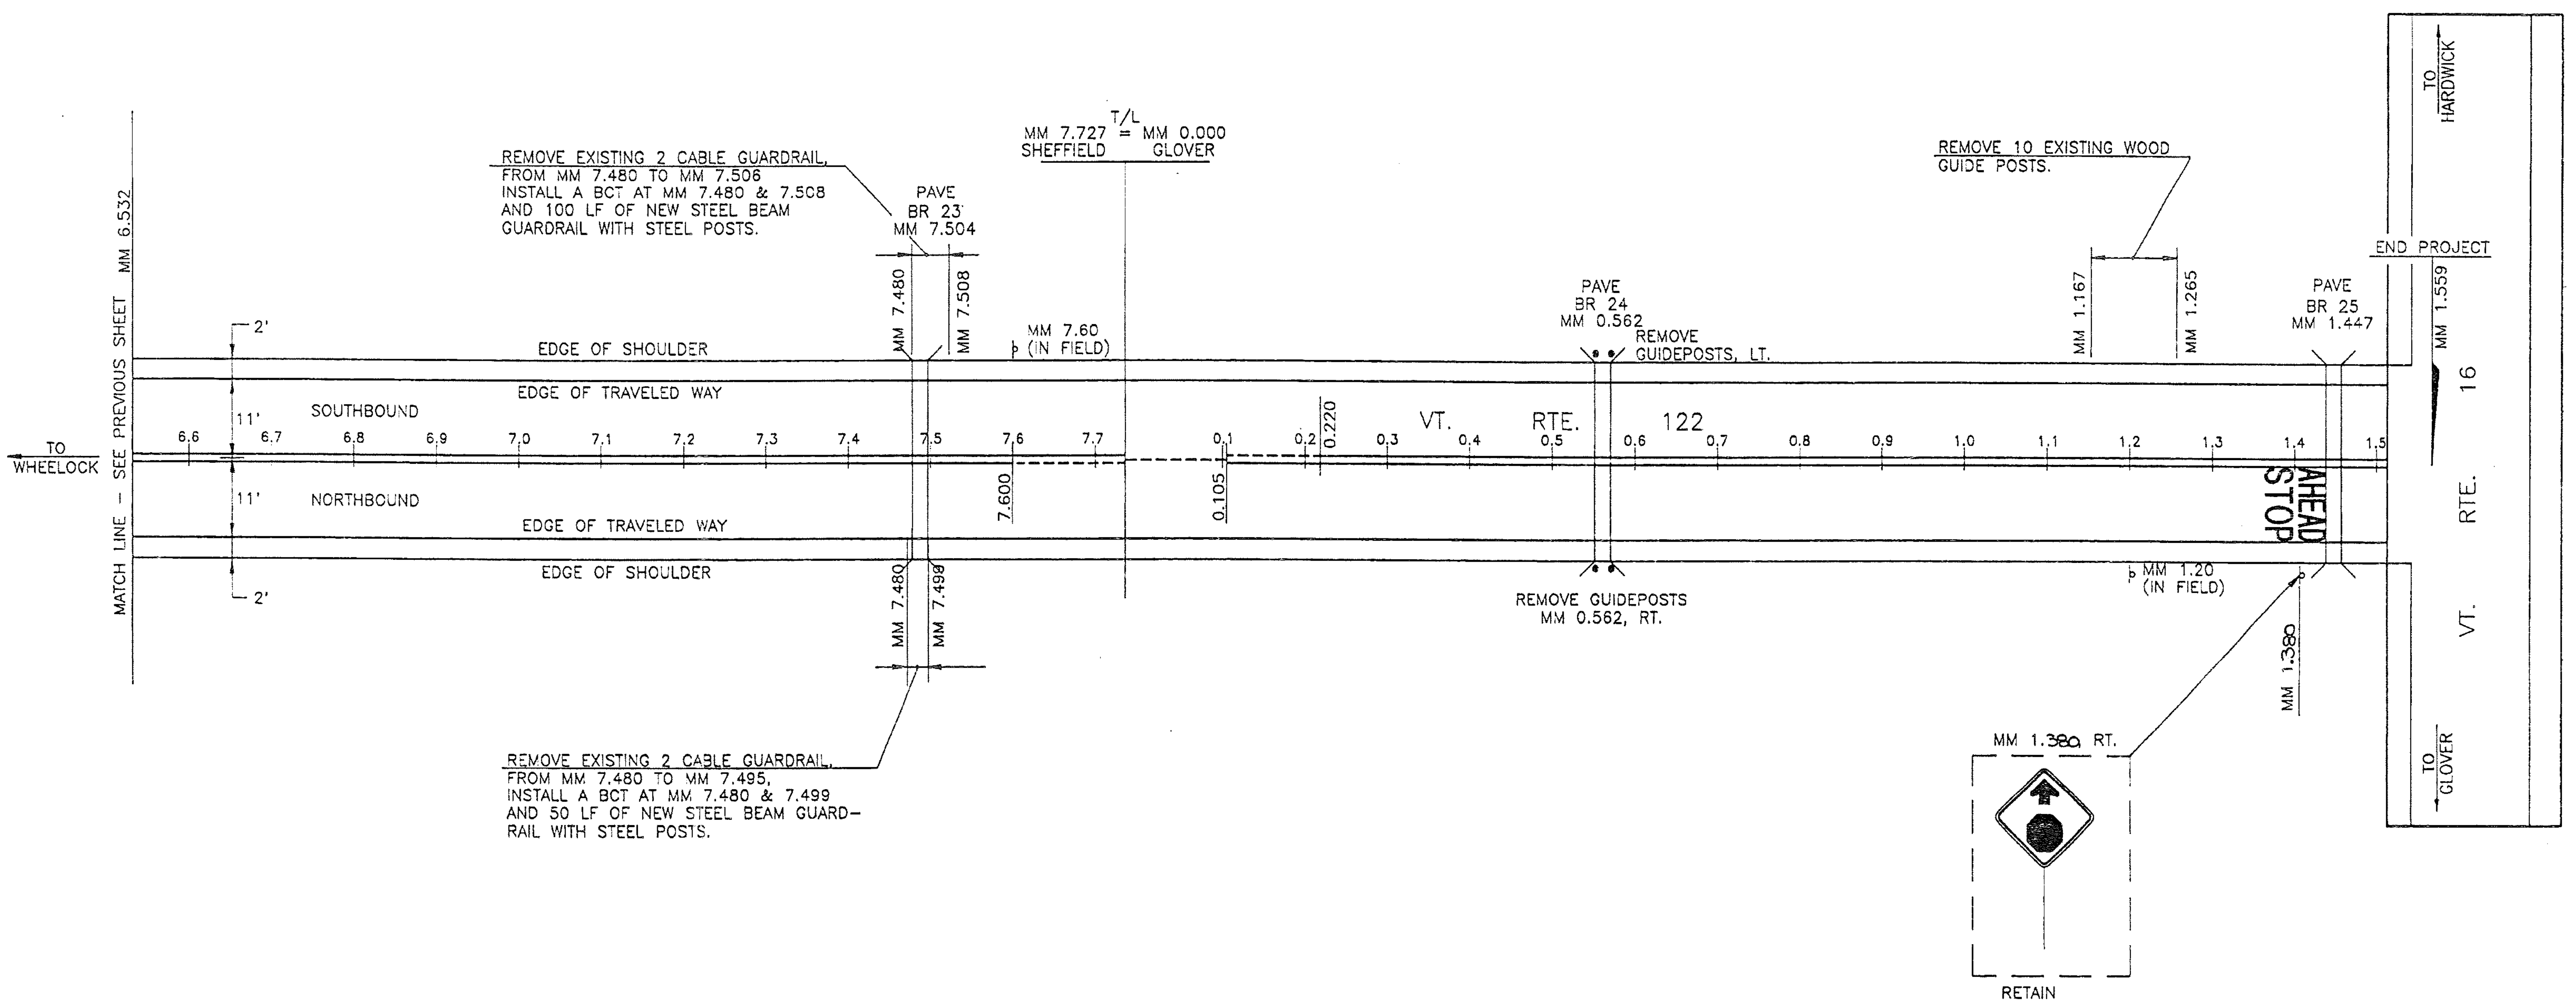

DATUM	N/A
VERTICAL	N/A
HORIZONTAL	N/A

<h3>PAVING PROJECT LAYOUT</h3>	SURVEYED BY	N/A	DATE	N/A
	DRAWN BY	WBL	DATE	03/93
	SQUAD LEADER			
	DESIGN FILE NO.			
	IPARM FILE		DATE PLOTTED	
	PROJ. NAME	SHEFFIELD-GLOVER		
PROJ. NO.	STP 94T9(1)S			
HTA FILE:	SHFPMK4	SHEET	09 OF	SHEETS