



INTERSECTION DETAIL 1
MM 3.655 TO MM 3.697
SCALE: 1" = 20'

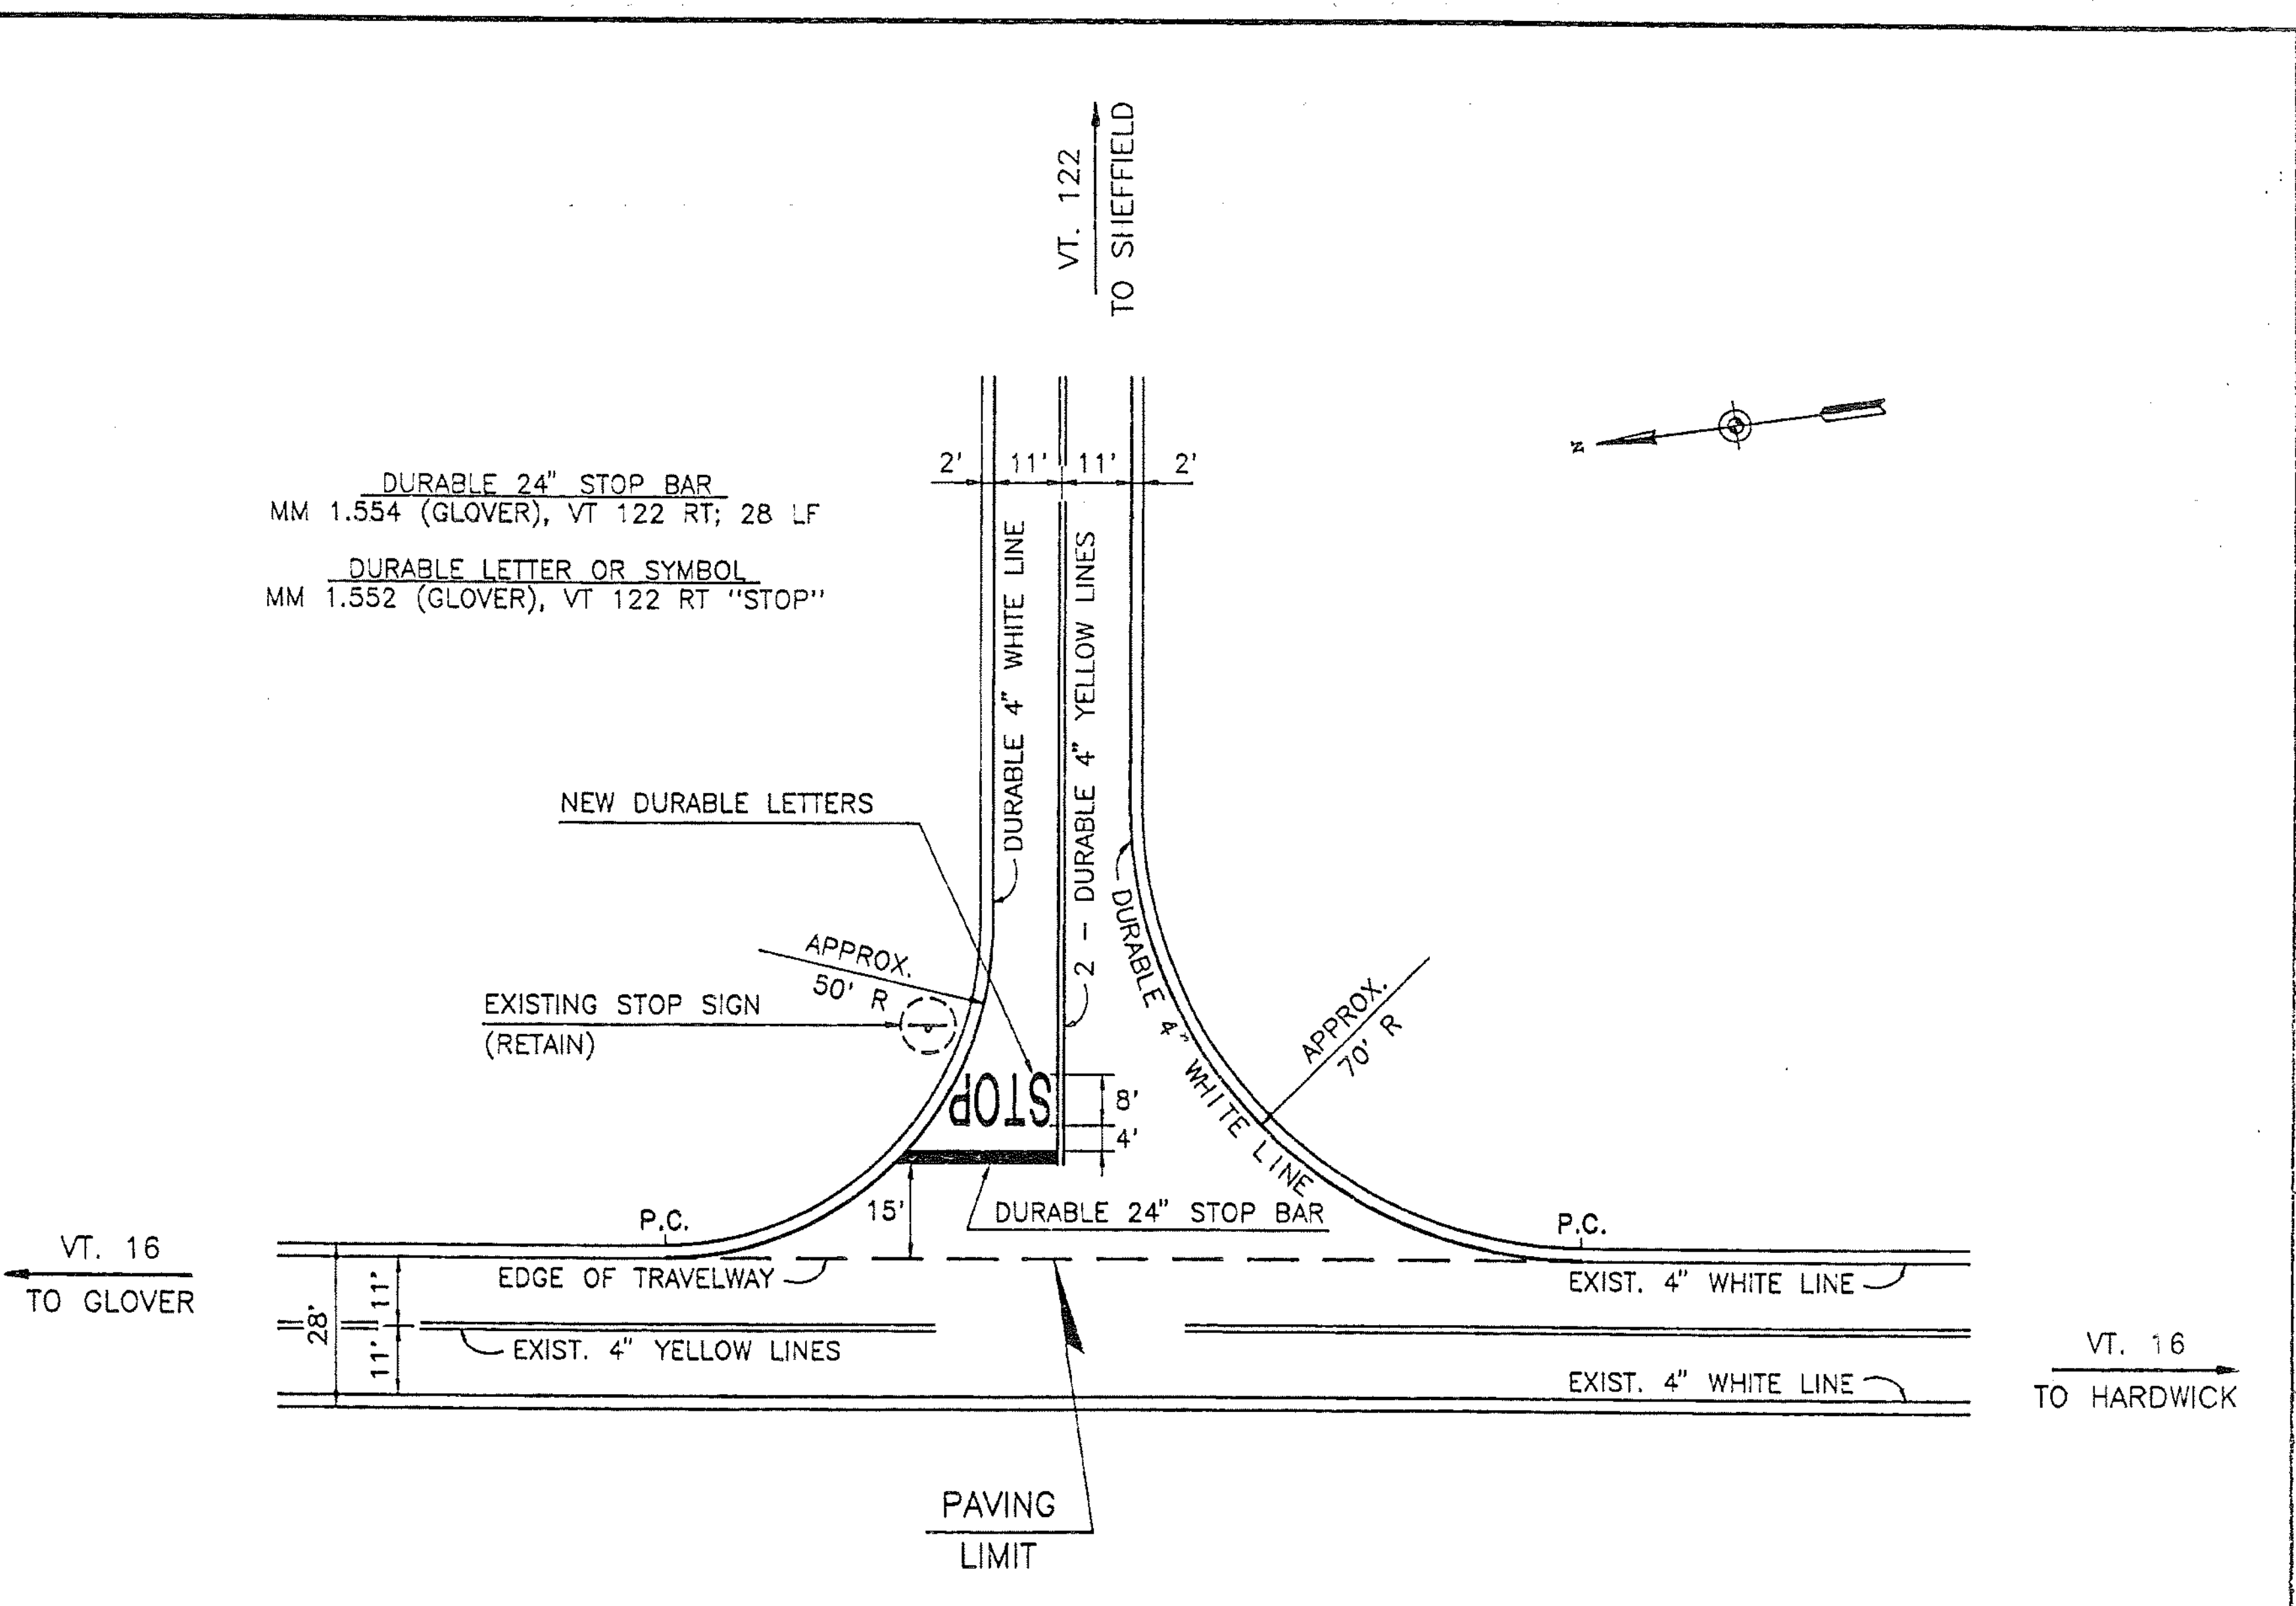

INTERSECTION DETAIL 2
MM 1.540 TO MM 1.559
SCALE: 1" = 20'

LEGEND:
N = NEW
R = REMOVE
RET = RETAIN
S = SALVAGE

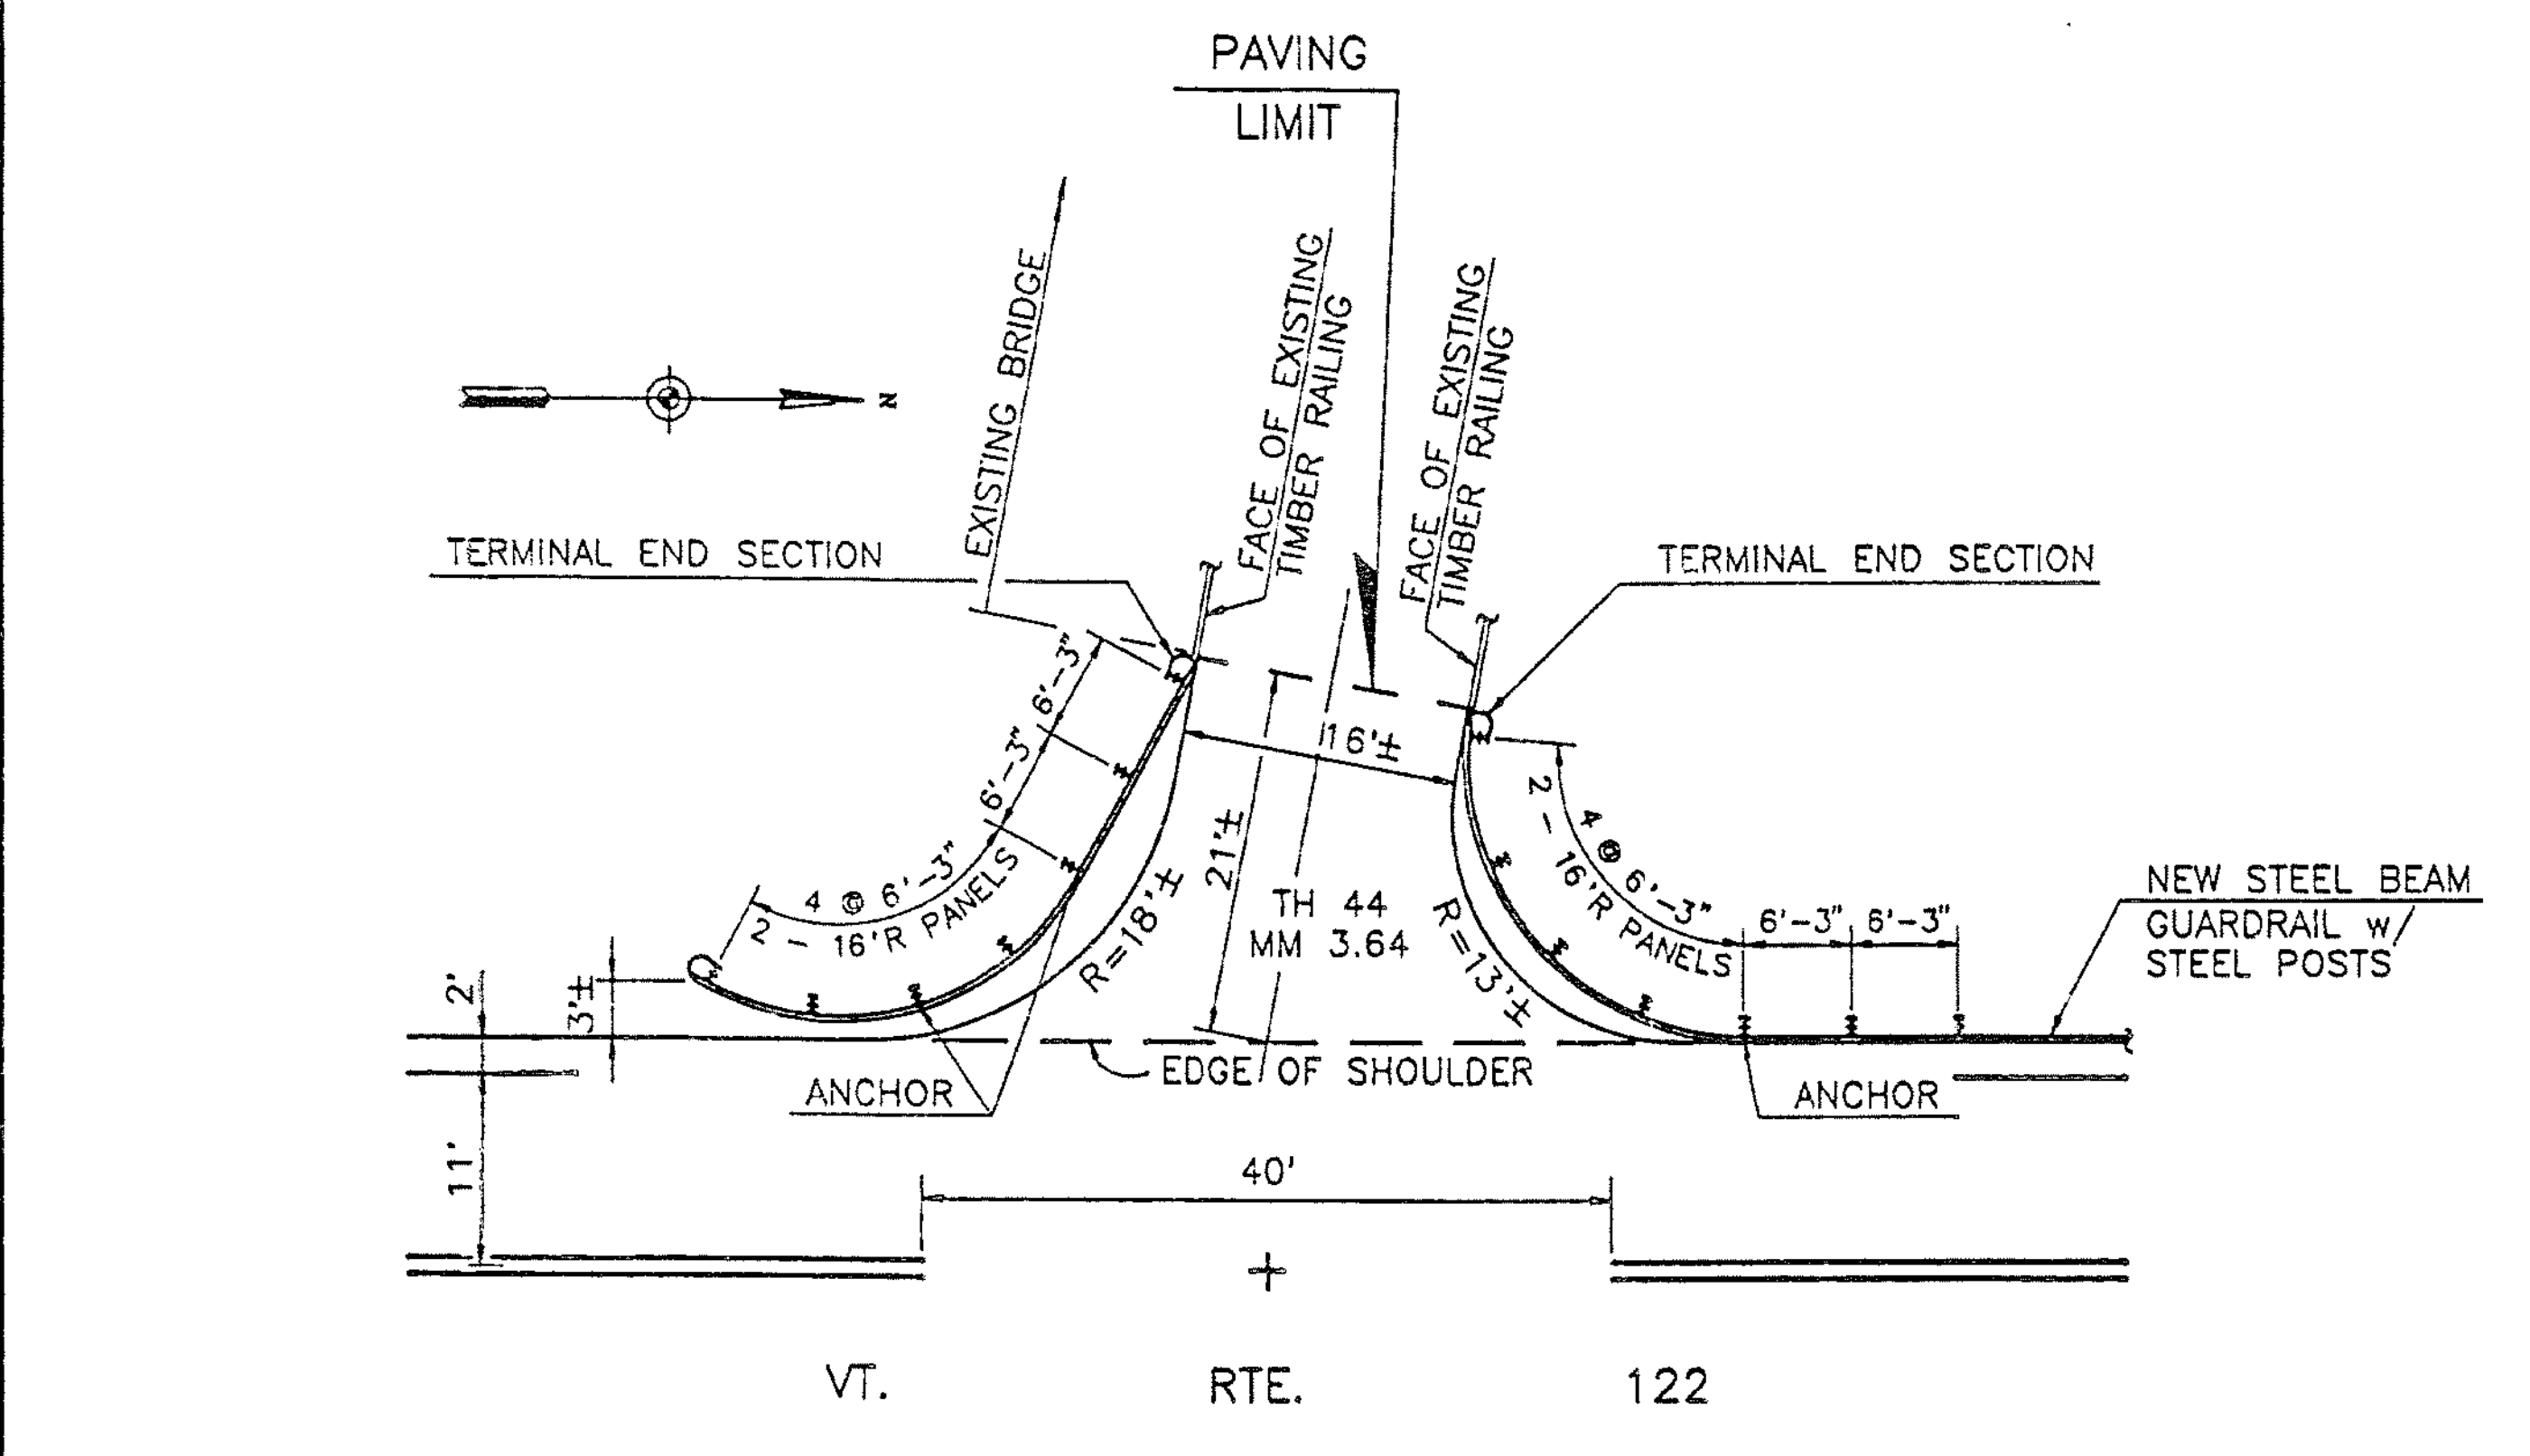

GUARDRAIL DETAIL AT INTERSECTION
TOWN HIGHWAY 44 - MM 3.64
SCALE: 1" = 10'

DATUM	_____
VERTICAL	_____
HORIZONTAL	_____

INTERSECTION DETAIL SHEET	SURVEYED BY	N/A	DATE	N/A
	DRAWN BY	WBL	DATE	03/93
	SQUAD LEADER	_____		
	DESIGN FILE NO.	_____		
	IPARM FILE	_____	DATE PLOTTED	_____
PROJ. NAME SHEFFIELD-GLOVER				
PROJ. NO. STP 9419(1)S				
SHEET 11 OF SHEETS				
HTA FILE: SHFINTS				