

DURABLE 4" YELLOW LINE

BROWNINGTON

MM 0.659 TO MM 1.560 (SOLID LT. & RT.)
 MM 1.560 TO MM 1.715 (SOLID LT. & DASHED RT.)
 MM 1.715 TO MM 2.105 (SOLID LT. & RT.)
 MM 2.105 TO MM 2.242 (SOLID LT. & DASHED RT.)
 MM 2.242 TO MM 2.587 (DASHED)
 MM 2.587 TO MM 2.723 (DASHED LT. & SOLID RT.)
 MM 2.723 TO MM 2.865 (SOLID LT. & DASHED RT.)
 MM 2.865 TO MM 3.020 (DASHED)
 MM 3.020 TO MM 3.140 (DASHED LT. & SOLID RT.)
 MM 3.140 TO MM 3.450 (SOLID LT. & RT.)
 (WITH CENTERLINE BREAKS FOR TOWN HIGHWAYS)

DURABLE 4" WHITE LINE

MM 0.659 TO MM 3.450 (SOLID LT. & RT.)
 (WITH EDGE LINE BREAKS FOR TOWN HIGHWAYS)


TEMPORARY 4" YELLOW LINE

BROWNINGTON

MM 0.659 TO MM 1.560 (SOLID LT. & RT.)
 MM 1.560 TO MM 1.715 (SOLID LT. & DASHED RT.)
 MM 1.715 TO MM 2.105 (SOLID LT. & RT.)
 MM 2.105 TO MM 2.242 (SOLID LT. & DASHED RT.)
 MM 2.242 TO MM 2.587 (DASHED)
 MM 2.587 TO MM 2.723 (DASHED LT. & SOLID RT.)
 MM 2.723 TO MM 2.865 (SOLID LT. & DASHED RT.)
 MM 2.865 TO MM 3.020 (DASHED)
 MM 3.020 TO MM 3.140 (DASHED LT. & SOLID RT.)
 MM 3.140 TO MM 3.450 (SOLID LT. & RT.)
 (WITH CENTERLINE BREAKS FOR TOWN HIGHWAYS)

TEMPORARY 4" WHITE LINE

MM 0.659 TO MM 3.450 (SOLID LT. & RT.)
 (WITH EDGE LINE BREAKS FOR TOWN HIGHWAYS)

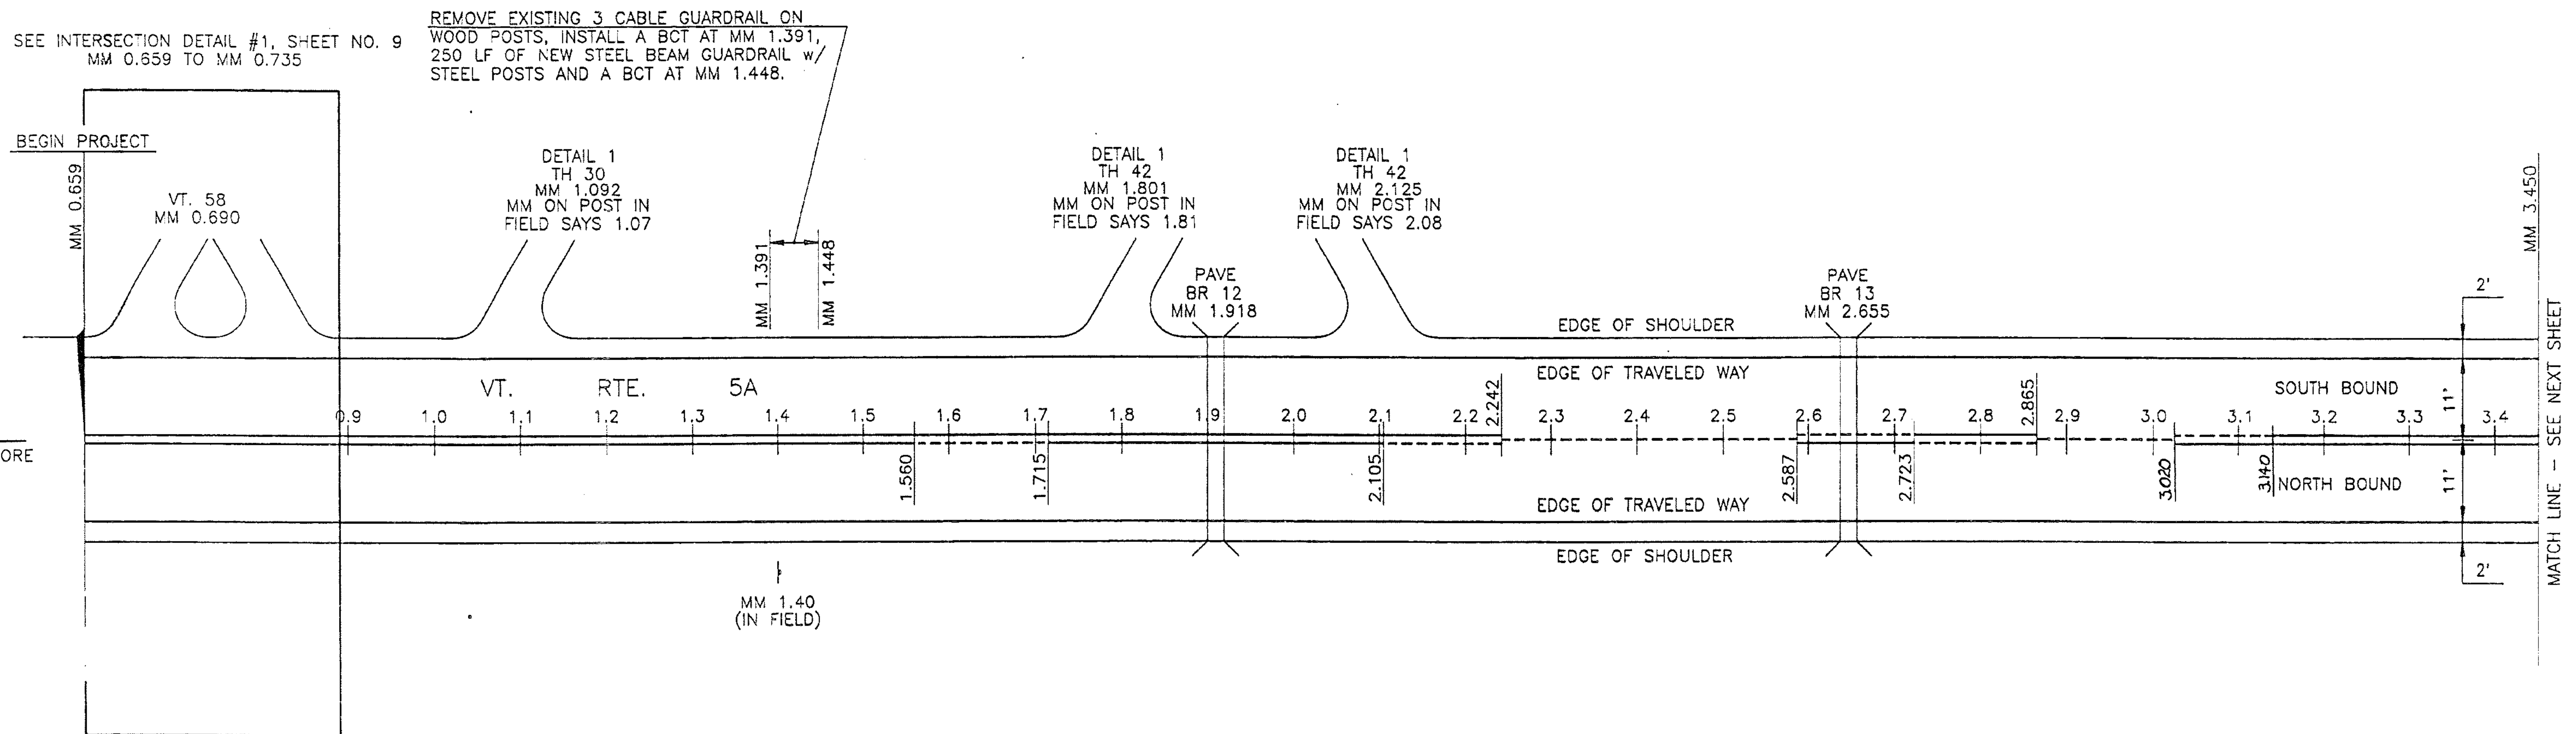

FOR TOWN HIGHWAY DETAILS, SEE PAVEMENT MARKING DETAIL SHEET.

DATUM	
VERTICAL	N/A
HORIZONTAL	N/A

<h3>PAVING PROJECT LAYOUT</h3>	SURVEYED BY	N/A	DATE	N/A
	DRAWN BY	WBL	DATE	03/93
	SQUAD LEADER			
	DESIGN FILE NO.			
	IPARM FILE		DATE PLOTTED	
	PROJ. NAME	BROWNINGTON-CHARLESTON		
	PROJ. NO.	STP 9426(1)S		
	SHEET	05 OF	SHEETS	
	SHEET 27 OF 44			
	HTA FILE: BRNPMK1			