


## NOTES

1. THE PAVEMENT WEARING COURSE SHALL BE TYPE III, ITEM 406.27.
2. THE LEVELING COURSE SHALL BE TYPE III OR TYPE IV, ITEM 406.27, DIRECTED BY THE ENGINEER.
3. EMULSIFIED ASPHALT SHALL BE APPLIED ON ALL EXISTING SURFACES, ALL COLD PLANED SURFACES, AND BETWEEN ALL COURSES OF PAVEMENT AT THE RATE OF 0.05 GAL/SY OR AS DIRECTED.
4. BITUMINOUS CONCRETE PAVEMENT TOLERANCE =  $\pm 1/4"$  (FOR THE WEARING COURSE ONLY).
5. EXISTING SHOULDER MATERIAL DEEMED UNSUITABLE BY THE RESIDENT ENGINEER, SHALL BE EXCAVATED TO A DEPTH OF 3'  $\pm$  OR AS DIRECTED BY THE ENGINEER. EXCAVATION WILL BE PAID FOR AS ALL PURPOSE EXCAVATOR OR GRADER RENTAL. MATERIAL REMOVED SHALL BE REPLACED WITH SUBBASE OF CRUSHED GRAVEL (FINE GRADED). EXCAVATED MATERIAL SHALL BE SPREAD ON THE ADJACENT SLOPES OR REMOVED FROM THE PROJECT, AS DIRECTED BY THE ENGINEER.
6. COLD PLANING TO BE COMPLETED ACCORDING TO THE DETAIL SHOWN ON THE PROJECT DETAIL SHEET.
7. THREE FEET OF BACKING IS REQUIRED BEHIND THE FACE OF GUARD RAIL WITH 6' POSTS. IF THIS CAN NOT BE OBTAINED THEN 8' POSTS SHALL BE USED.

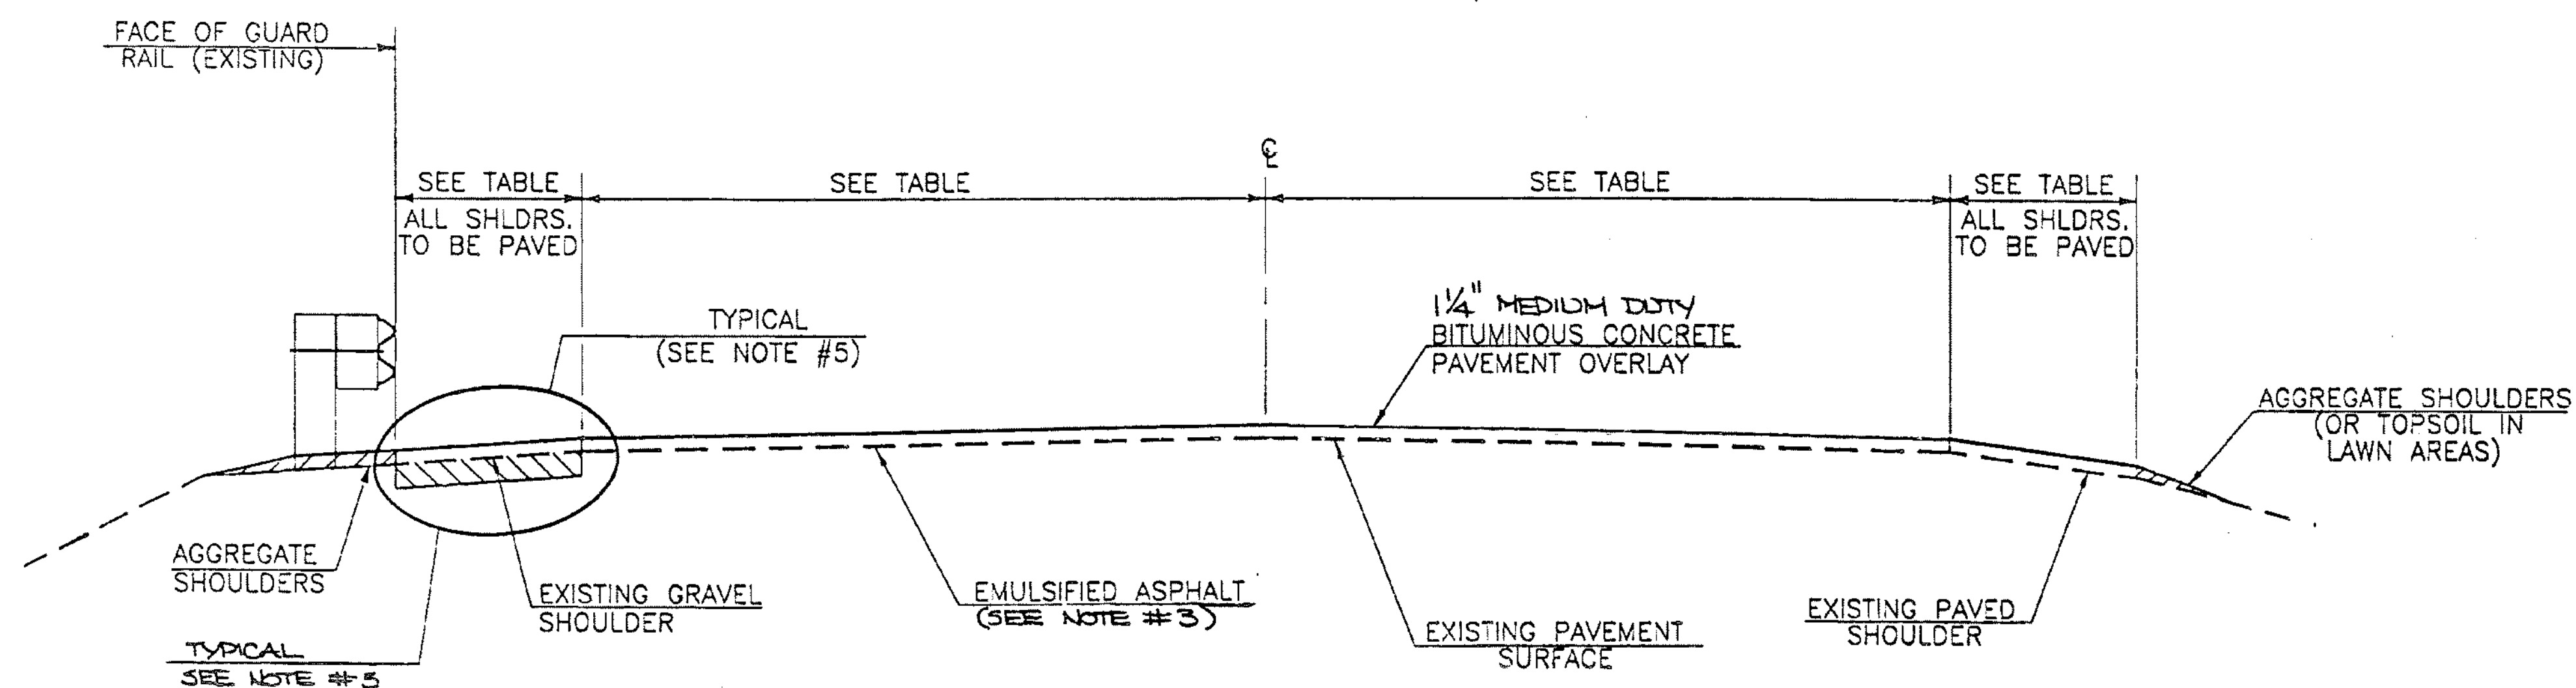

### OVERLAY TYPICAL SECTION

#### URBAN AREA - SEED MIXTURE

% WT.	LBS./ACRE	NAME	PUR%	GERM%
42.5	34.0	CREEPING RED FESCUE	98	85
10.0	8.0	PERENNIAL RYE	95	90
42.5	34.0	KENTUCKY BLUEGRASS	85	85
5.0	4.0	ANNUAL RYEGRASS	95	85
100.0	80.0			

SEED MIXTURE:  
SHALL NOT HAVE A WEED CONTENT EXCEEDING 0.40% BY WEIGHT AND SHALL BE FREE OF ALL NOXIOUS SEED.

SEED:  
TO BE APPLIED PER SEEDING FORMULAS OR AS DIRECTED BY THE ENGINEER.

FERTILIZER:  
FORMULA 10-20-10, TO BE USED WITH SEED, APPLIED AT THE RATE OF 500 LBS./ACRE. (HYDRO SEEDERS MAY USE 15-15-15 FORMULA.)

AGRICULTURAL LIMESTONE:  
TO BE APPLIED AT THE RATE OF 2 TONS/ACRE, OR AS DIRECTED BY THE ENGINEER.

HAY MULCH:  
TO BE PLACED ON EARTH SLOPES AT THE RATE OF 2 TONS/ACRE, OR AS DIRECTED BY THE ENGINEER.

TOPSOIL:  
TO BE USED AS INDICATED ON THE PLANS, OR AS DIRECTED BY THE ENGINEER.

MARKER POSTS:  
TO BE PLACED AS INDICATED OR AS DIRECTED BY THE ENGINEER.

### PROJECT PAVING LIMITS

TOWN	BEGIN MILE MARKER	END MILE MARKER	LANE TYPICAL	WEARING DEPTH	LEVELING TONS/MILE	NOTES
GLOVER	2.815	3.895	3'-11"-11'-3'	1-1/4"	636	
GLOVER	3.895	3.913	SEE NOTE	-	-	BRIDGE NO. 15, DO NOT PAVE
GLOVER	3.913	4.515	3'-11"-11'-3'	1-1/4"	636	

## PROJECT TYPICAL SHEET

SURVEYED BY N/A DATE N/A  
DRAWN BY CBB DATE 03/93

SQUAD LEADER \_\_\_\_\_

DESIGN FILE NO. \_\_\_\_\_

IPARM FILE \_\_\_\_\_ DATE PLOTTED \_\_\_\_\_

PROJ. NAME GLOVER

PROJ. NO. STP 9435(1)S

HTA FILE: GLVTYPXS

SHEET 02 OF SHEETS

SHEET 2/2 OF 44