


**BRIDGE DETAIL**  
 BRIDGE NO. 15, MM 3.920 (3.904 IN FIELD)

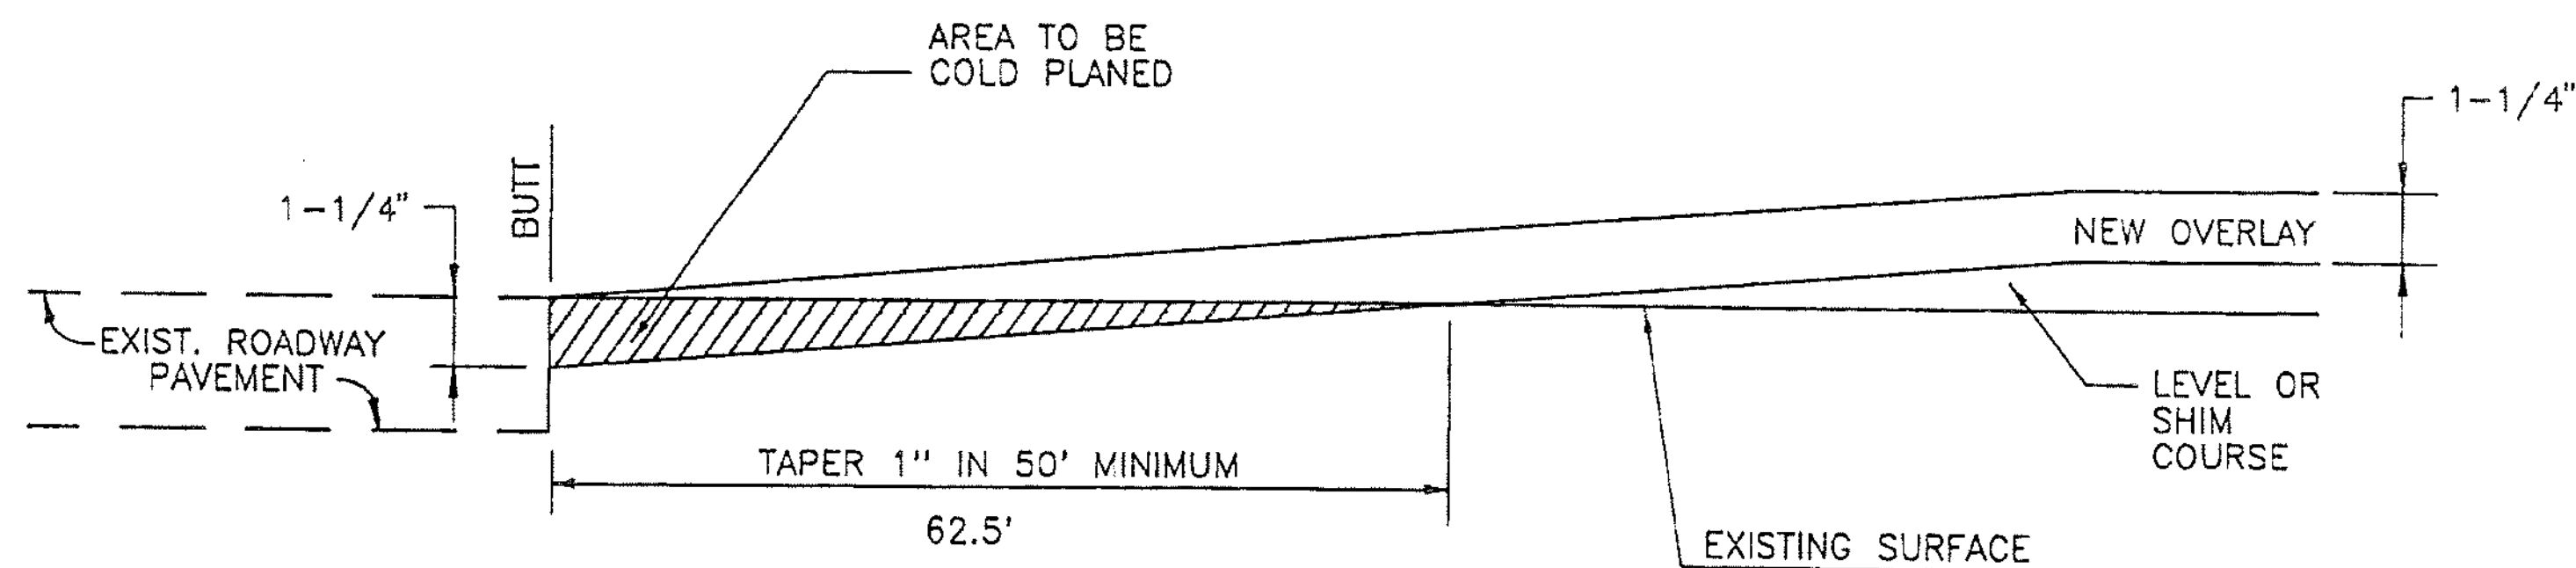

**APPROACH AREA DETAIL**  
 MM'S. 2.815 & 4.499

**COLD PLANING DETAILS**  
 (FULL ROADWAY WIDTH)  
 N.T.S.

DATUM	
VERTICAL	N/A
HORIZONTAL	N/A

<b>PROJECT DETAIL SHEET</b>	SURVEYED BY	N/A	DATE	N/A
	DRAWN BY	WBL	DATE	03/93
	SQUAD LEADER			
	DESIGN FILE NO.			
	IPARM FILE		DATE PLOTTED	
	PROJ. NAME	GLOVER		
	PROJ. NO.	STP 9435(1)S		
	SHEET 10 OF		SHEETS	
	HTA FILE:	GLVDETLS		
		SHEET 44 OF 44		