
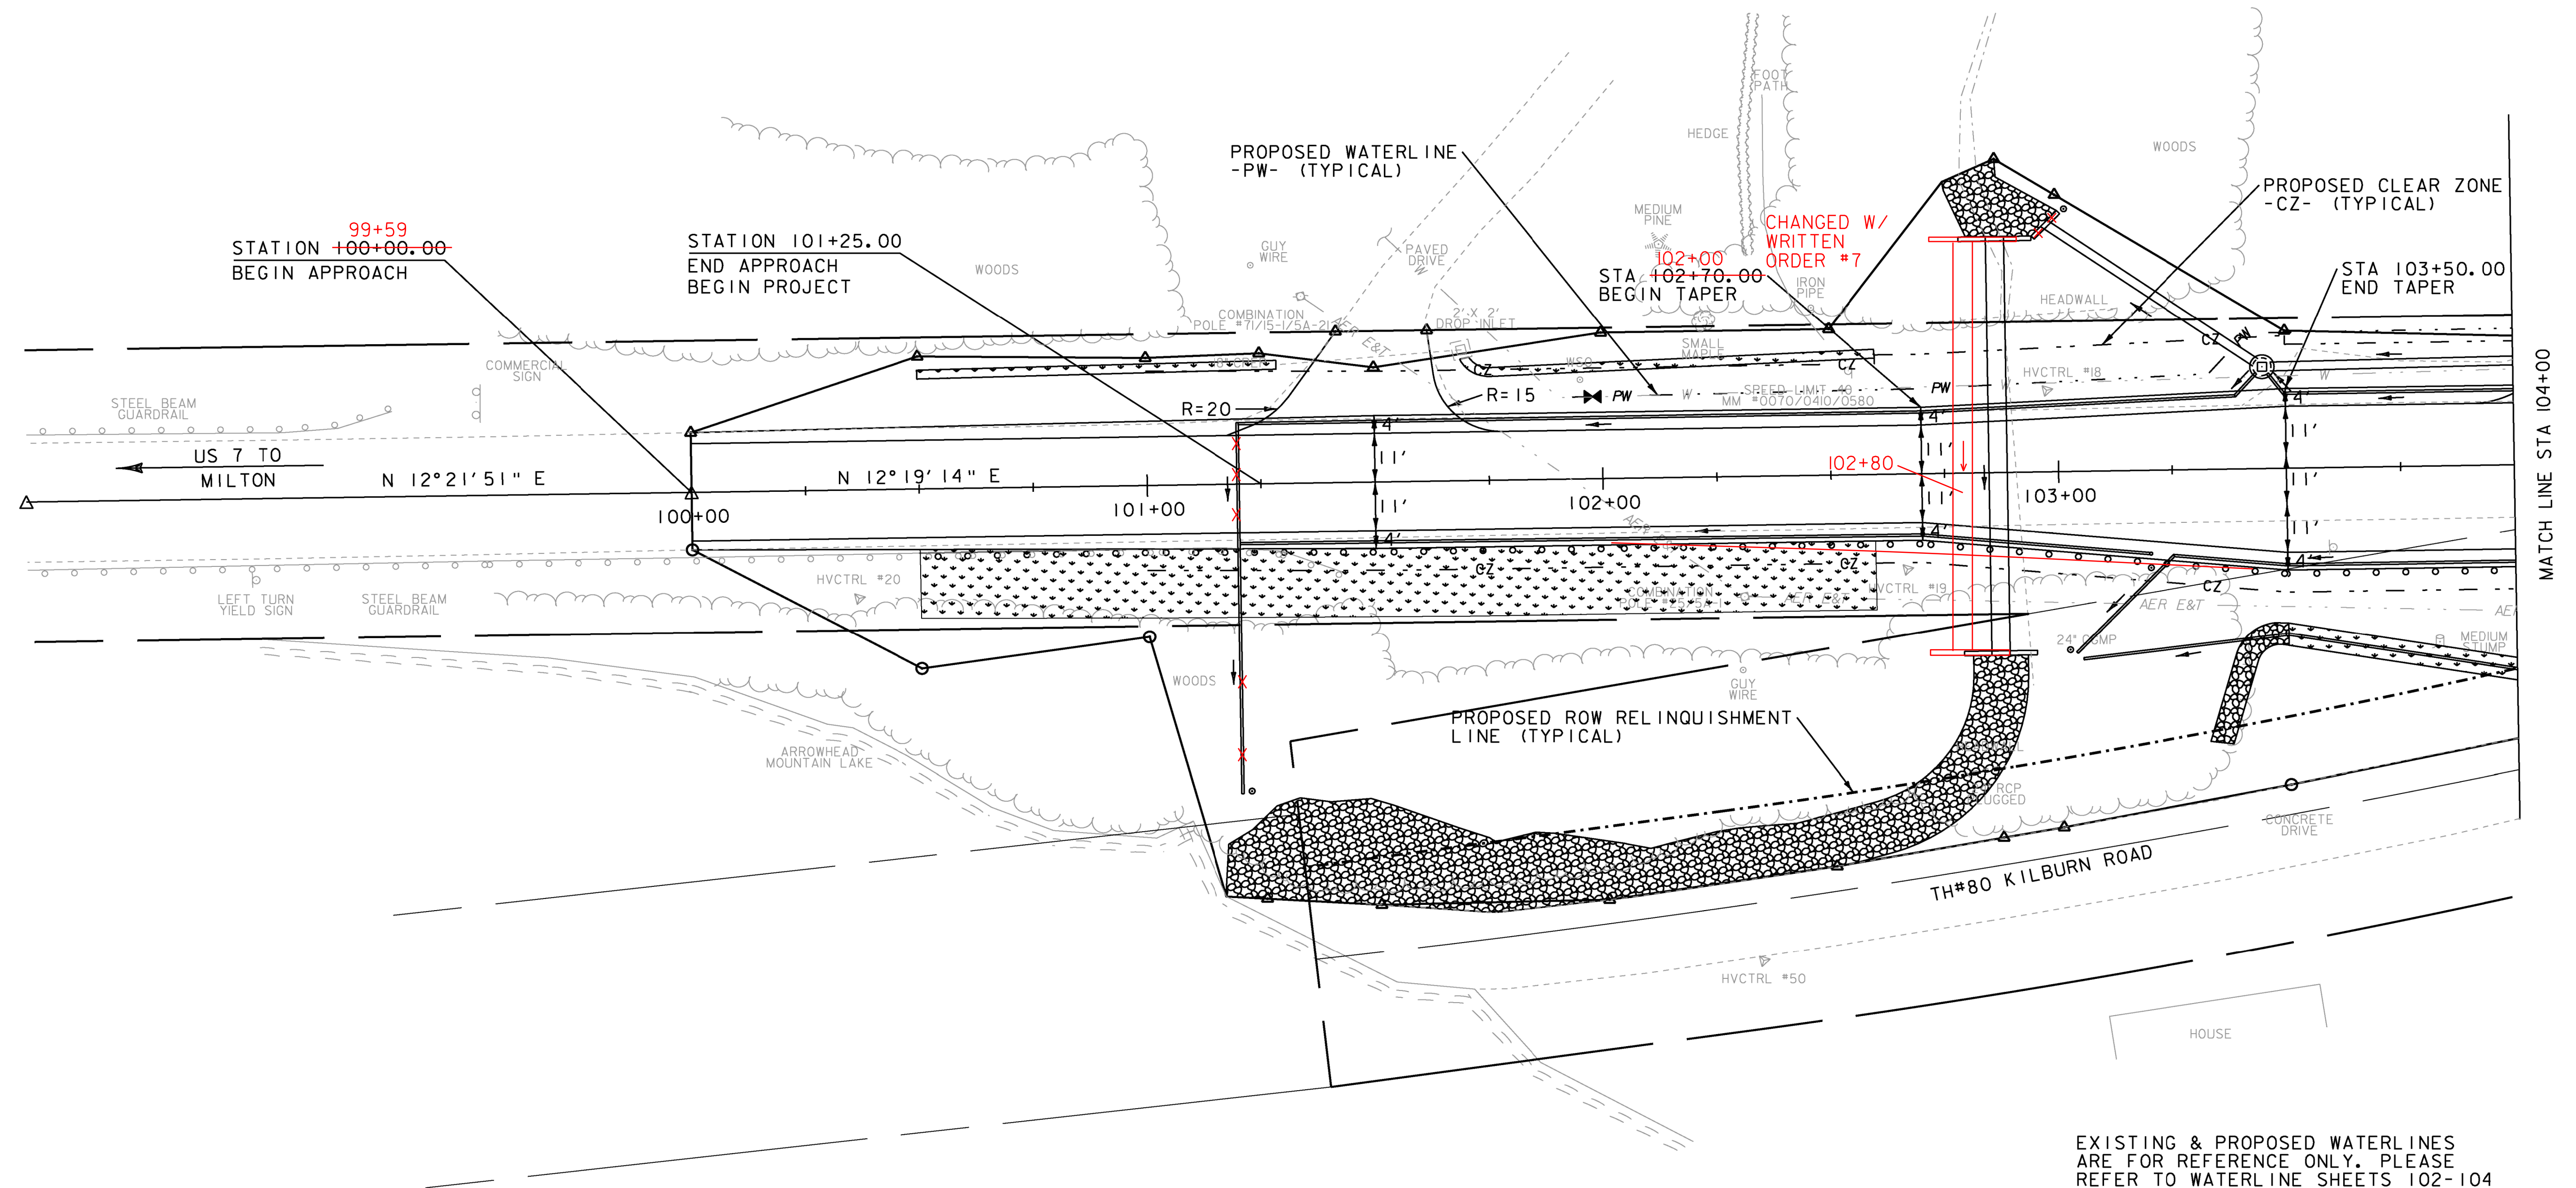


621.80 REMOVAL AND DISPOSAL OF GUARDRAIL
 STA 100+50.00 RT - 101+42.67 RT
 621.21 HD STEEL BEAM GUARDRAIL, GALVANIZED
 STA 100+50.00 RT - 104+00.00 RT

NOTE: MATCH PROPOSED HD STEEL BEAM GUARDRAIL
 INTO EXISTING GUARDRAIL AT STA 100+50.00 RT

CONSTRUCT DRIVE
 STA 101+52.44 LT (20.0' - PAVED)
 629.20 ADJUST ELEVATION OF VALVE BOX
 STA 101+95.31 LT
 210.10 COLD PLANING, BITUMINOUS CONCRETE PAVEMENT
 STA 100+00.00 - 100+50.00

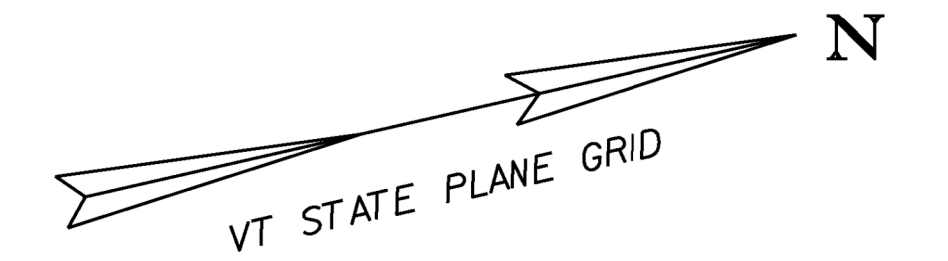

EXISTING & PROPOSED WATERLINES
 ARE FOR REFERENCE ONLY. PLEASE
 REFER TO WATERLINE SHEETS 102-104



PROJECT NAME:	MILTON	PLOT DATE:	23-FEB-2011
PROJECT NUMBER:	STP 5800 (2)	DRAWN BY:	D. LYMAN
FILE NAME:	+92d289bdr.dgn	CHECKED BY:	J. DEVLIN
PROJECT LEADER:	J. SCHULTZ	SHEET	21 OF 104
DESIGNED BY:	D. LYMAN	LAYOUT SHEET	1