



401.10 AGGREGATE SURFACE COURSE
 STA 111+12.33 RT (28.0' - GRAVEL DRIVE)
 STA 111+24.25 LT (12.1' - GRAVEL DRIVE)
 900.675 SPECIAL PROVISION
 (HAND-PLACED BITUMINOUS CONCRETE MATERIAL, DRIVES)
 STA 111+12.33 RT (PAVED DRIVE APRON)
 STA 111+24.25 LT (PAVED DRIVE APRON)

203.16 SOLID ROCK EXCAVATION
 STA 110+41.01 RT (CONCRETE WALL)
 210.10 COLD PLANING, BITUMINOUS CONCRETE PAVEMENT
 STA 111+00.00 - 111+50.00
 10.00 65.00

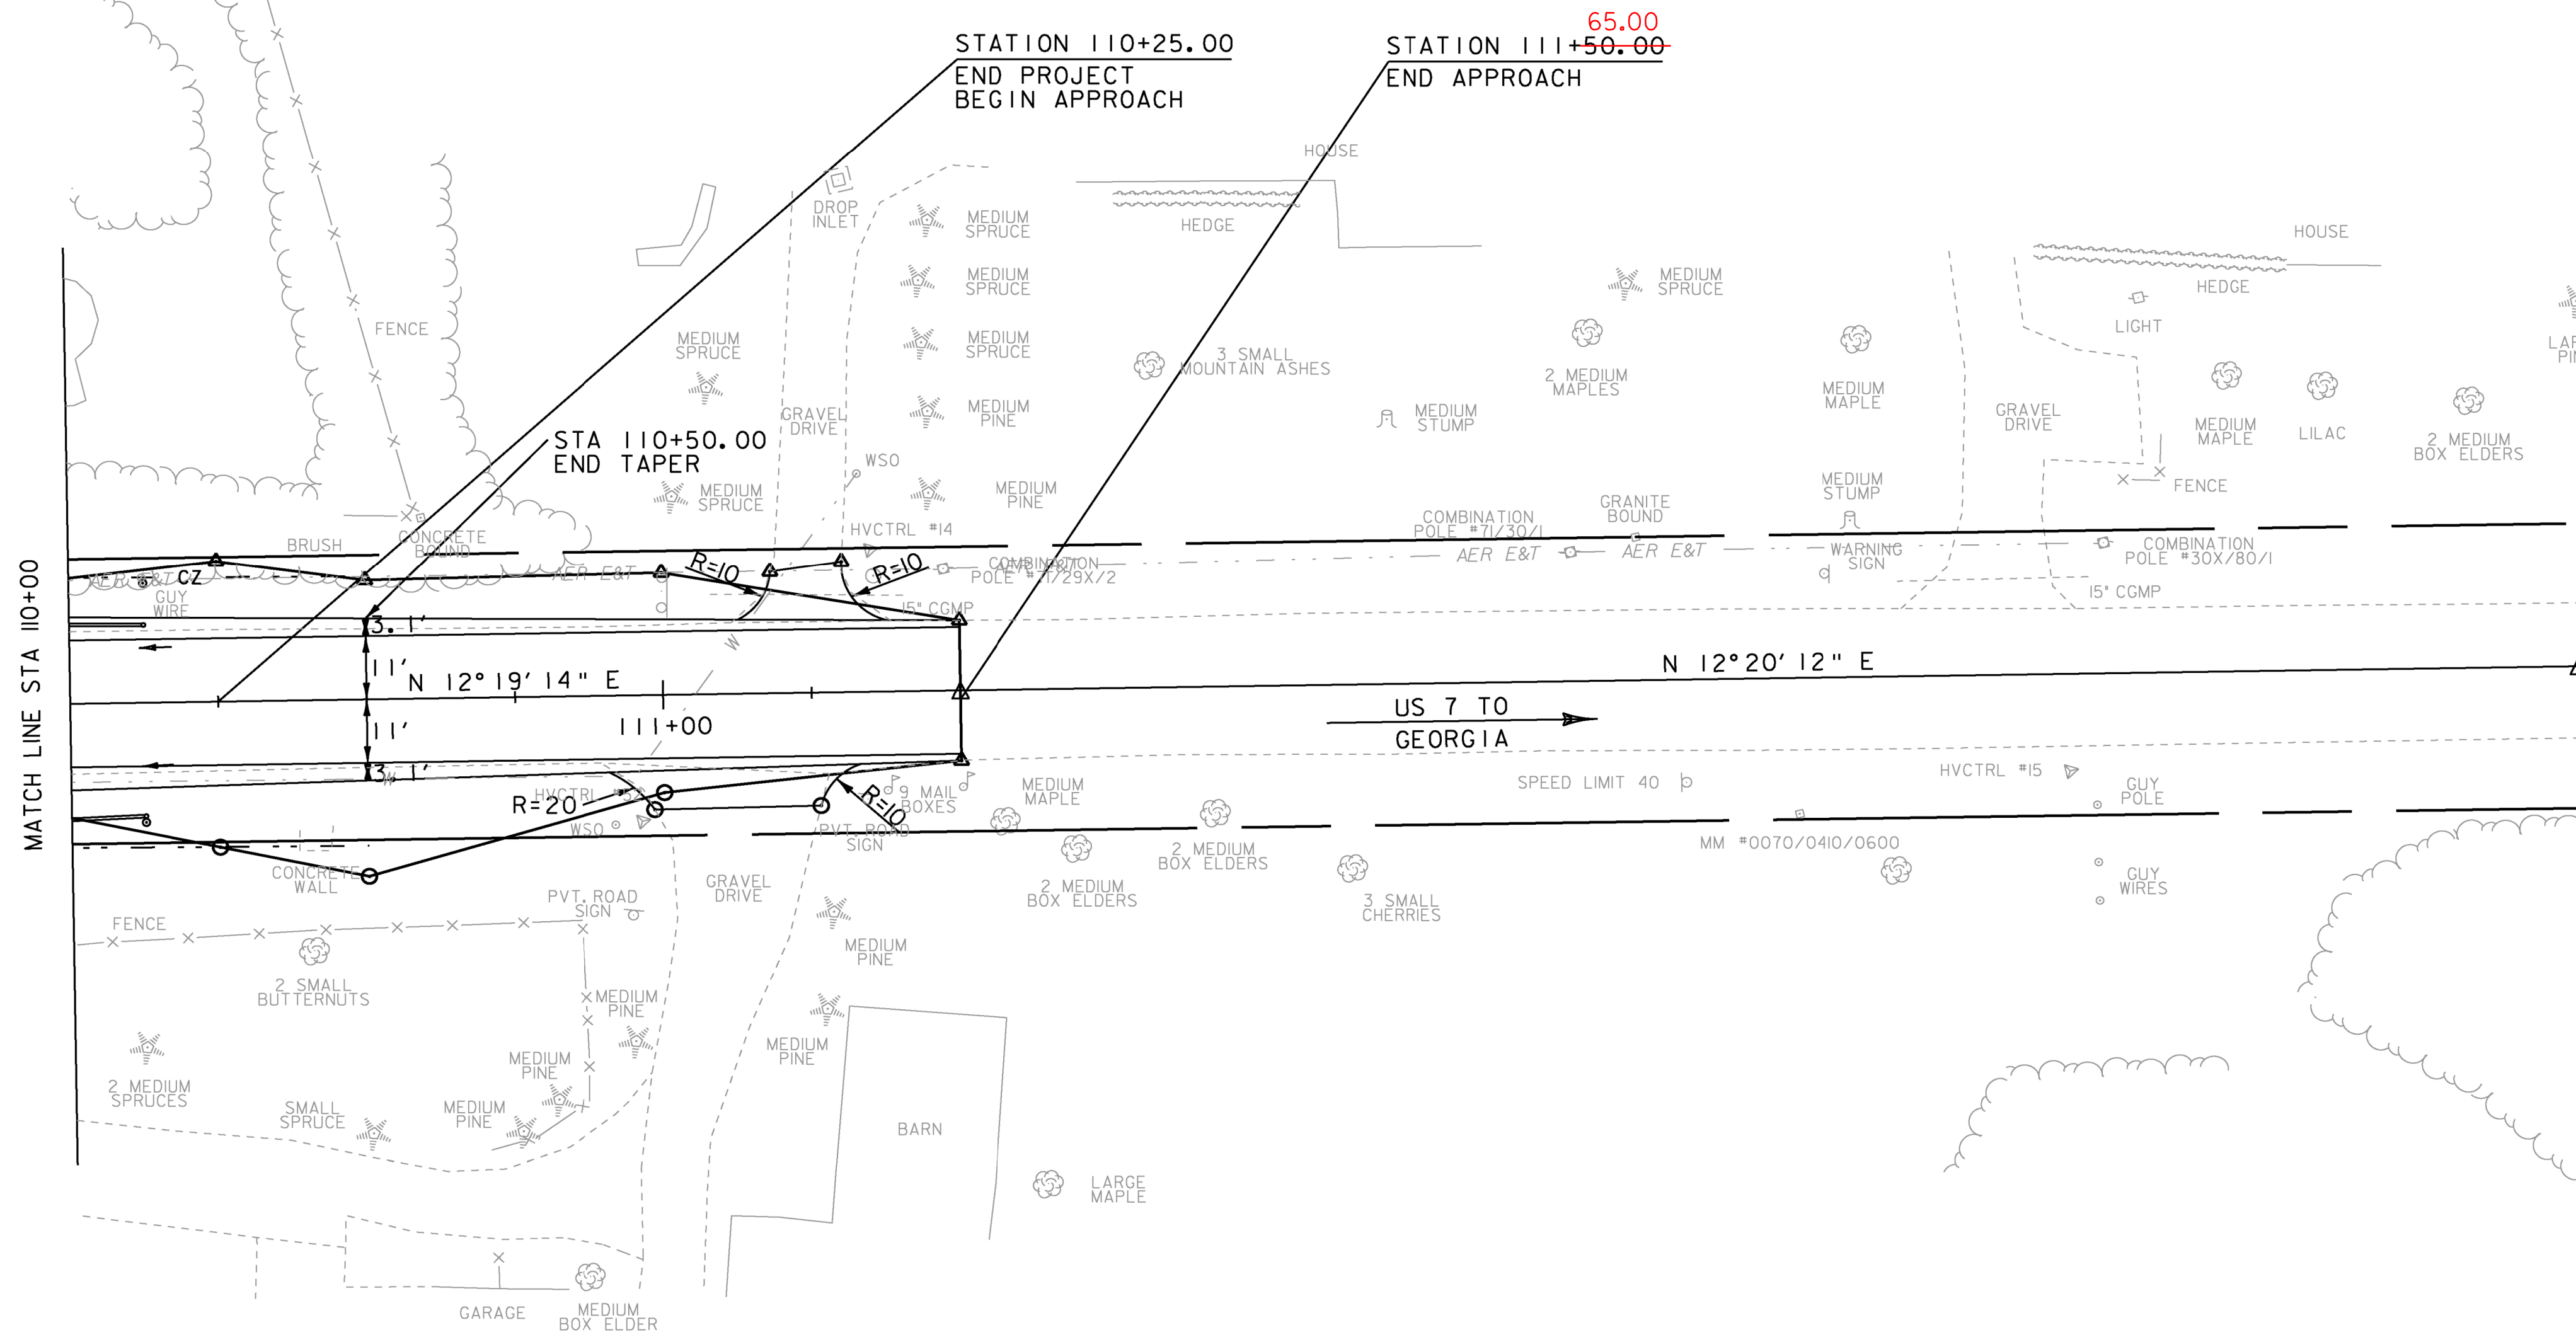

EXISTING & PROPOSED WATERLINES
 ARE FOR REFERENCE ONLY. PLEASE
 REFER TO WATERLINE SHEETS 102-104

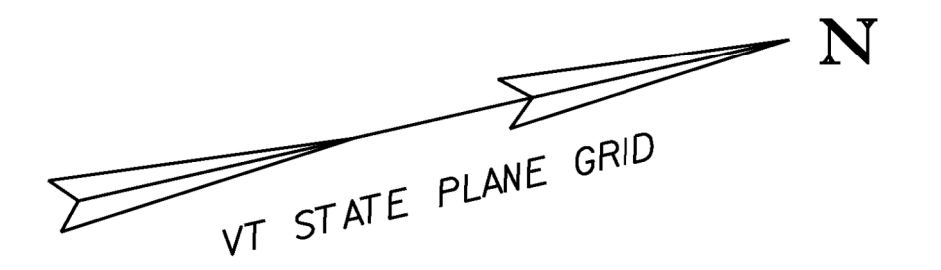

PROJECT NAME:	MILTON	PLOT DATE:	23-FEB-2011
PROJECT NUMBER:	STP 5800 (2)	DRAWN BY:	D. LYMAN
FILE NAME:	+92d289bdr.dgn	CHECKED BY:	J. DEVLIN
PROJECT LEADER:	J. SCHULTZ	SHEET	25 OF 104
DESIGNED BY:	D. LYMAN		
LAYOUT SHEET	3		