



102+00

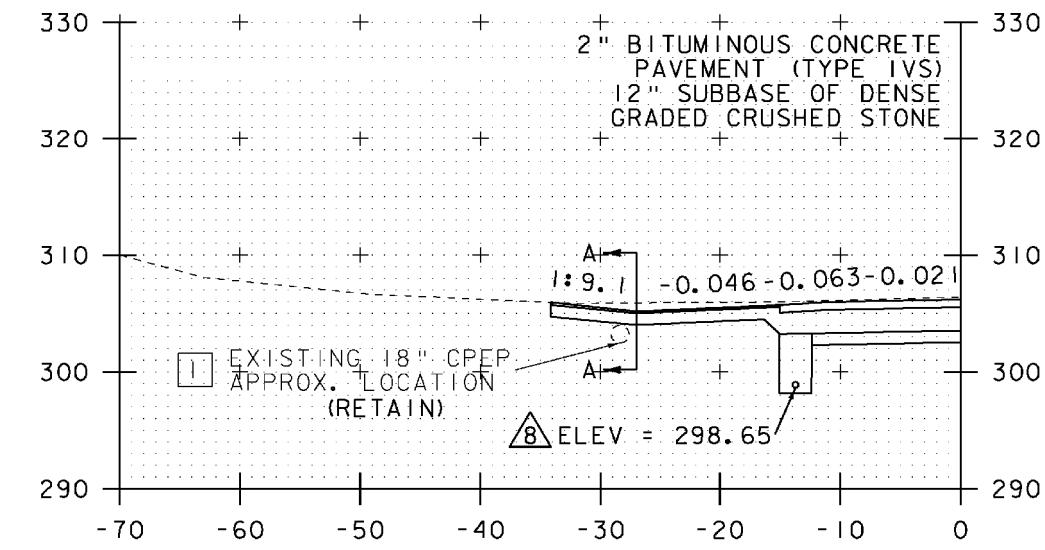


101+52.44
PAVED DRIVE LT

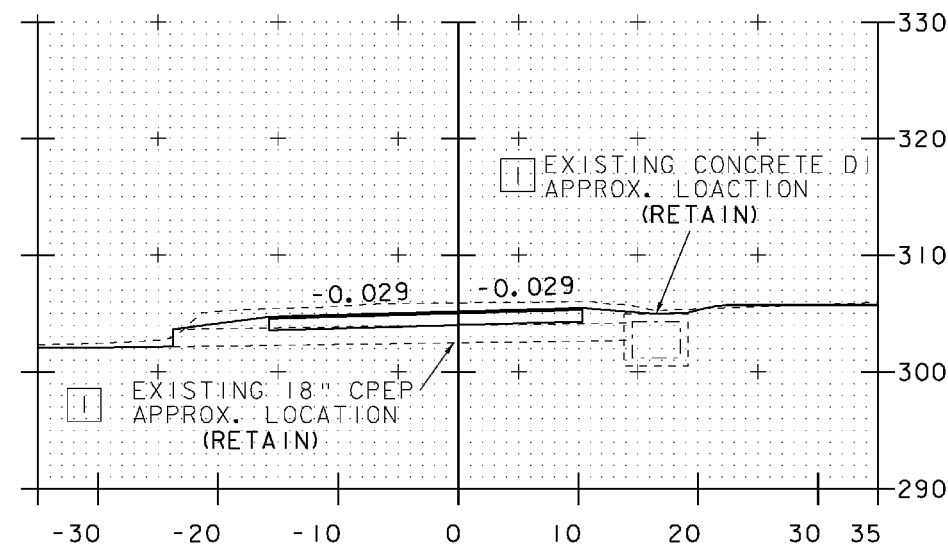

SECTION A-A

EXISTING & PROPOSED WATERLINES
ARE FOR REFERENCE ONLY. PLEASE
REFER TO WATERLINE SHEETS 102-104

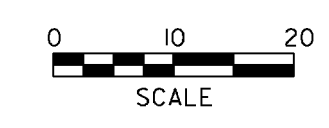

NOTE:
DRAINAGE FEATURES ARE NOT PROJECTED ONTO
CROSS SECTIONS. PLEASE REFER TO DRAINAGE
LAYOUT AND DRAINAGE PROFILE SHEETS FOR
DETAILED INFORMATION (TYP.)

STA. 101+52.44 TO STA. 102+00

PROJECT NAME:	MILTON
PROJECT NUMBER:	STP 5800 (2)
FILE NAME:	1920289x.dgn
PROJECT LEADER:	J. SCHULTZ
DESIGNED BY:	D. LYMAN
US ROUTE 7 CROSS SECTION SHEET 3	
PLOT DATE:	23-FEB-2011
DRAWN BY:	D. LYMAN
CHECKED BY:	J. DEVLIN
SHEET 80	OF 104