



102+87  
48" DIAMETER CULVERT

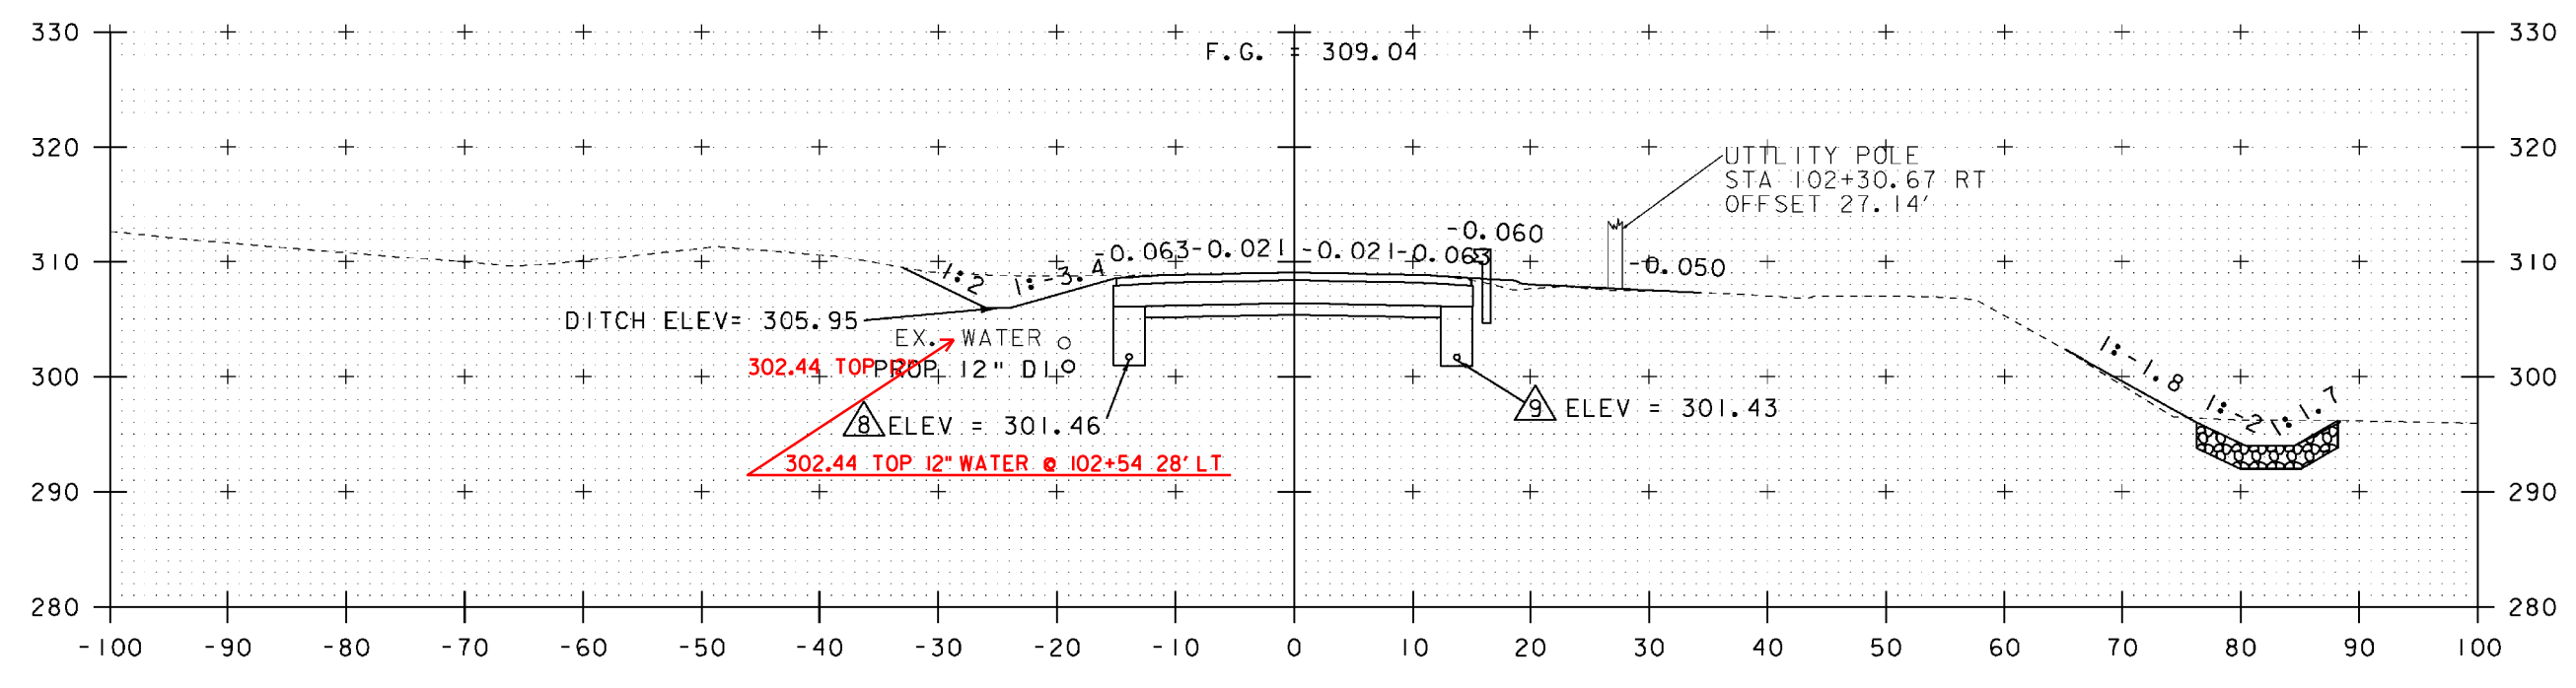

102+50

EXISTING & PROPOSED WATERLINES  
ARE FOR REFERENCE ONLY. PLEASE  
REFER TO WATERLINE SHEETS 102-104

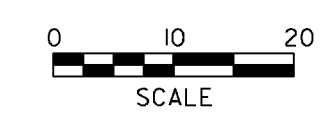

NOTE:  
DRAINAGE FEATURES ARE NOT PROJECTED ONTO  
CROSS SECTIONS. PLEASE REFER TO DRAINAGE  
LAYOUT AND DRAINAGE PROFILE SHEETS FOR  
DETAILED INFORMATION (TYP.)

STA. 102+50 TO STA. 102+87

PROJECT NAME:	MILTON
PROJECT NUMBER:	STP 5800 (2)
FILE NAME:	1920289x.dgn
PROJECT LEADER:	J. SCHULTZ
DESIGNED BY:	D. LYMAN
US ROUTE 7 CROSS SECTION SHEET 4	
PLOT DATE:	23-FEB-2011
DRAWN BY:	D. LYMAN
CHECKED BY:	J. DEVLIN
SHEET 81	OF 104