


EXISTING & PROPOSED WATERLINES ARE FOR REFERENCE ONLY. PLEASE REFER TO WATERLINE SHEETS 102-104

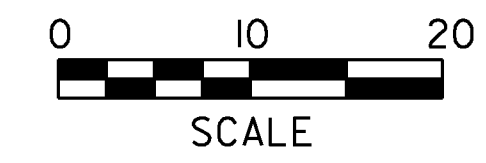

NOTE:
DRAINAGE FEATURES ARE NOT PROJECTED ONTO CROSS SECTIONS, PLEASE REFER TO DRAINAGE LAYOUT AND DRAINAGE PROFILE SHEETS FOR DETAILED INFORMATION (TYP.)

STA. 300+00 TO STA. 300+60

PROJECT NAME: MILTON	PLOT DATE: 23-FEB-2011
PROJECT NUMBER: STP 5800 (2)	DRAWN BY: D. LYMAN
FILE NAME: +92D289xsl.dgn	CHECKED BY: J. DEVLIN
DESIGNED BY: D. LYMAN	SHEET 91 OF 104
LAKE ROAD CROSS SECTION SHEET 1	