


TREE PLANTING SCHEDULE

LEGEND KEY	BOTANICAL NAME	COMMON NAME	QUANTITY	SIZE	REMARKS
AR	ACER RUBRUM	RED MAPLE	6	50 - 63 mm HT	B & B
BP	BETULA Papyrifera	CANOE BIRCH	8	30 - 50 mm HT	B & B, CLUMP
CS	CORNUS SERICEA	REDOSIER DOGWOOD	35	500 - 750 mm CAL	B & B
PN	PINUS NIGRA	AUSTRIAN PINE	18	1.8 - 2.1 m HT	B & B
PS	PINUS STROBUS	WHITE PINE	30	1.8 - 2.1 m HT	B & B

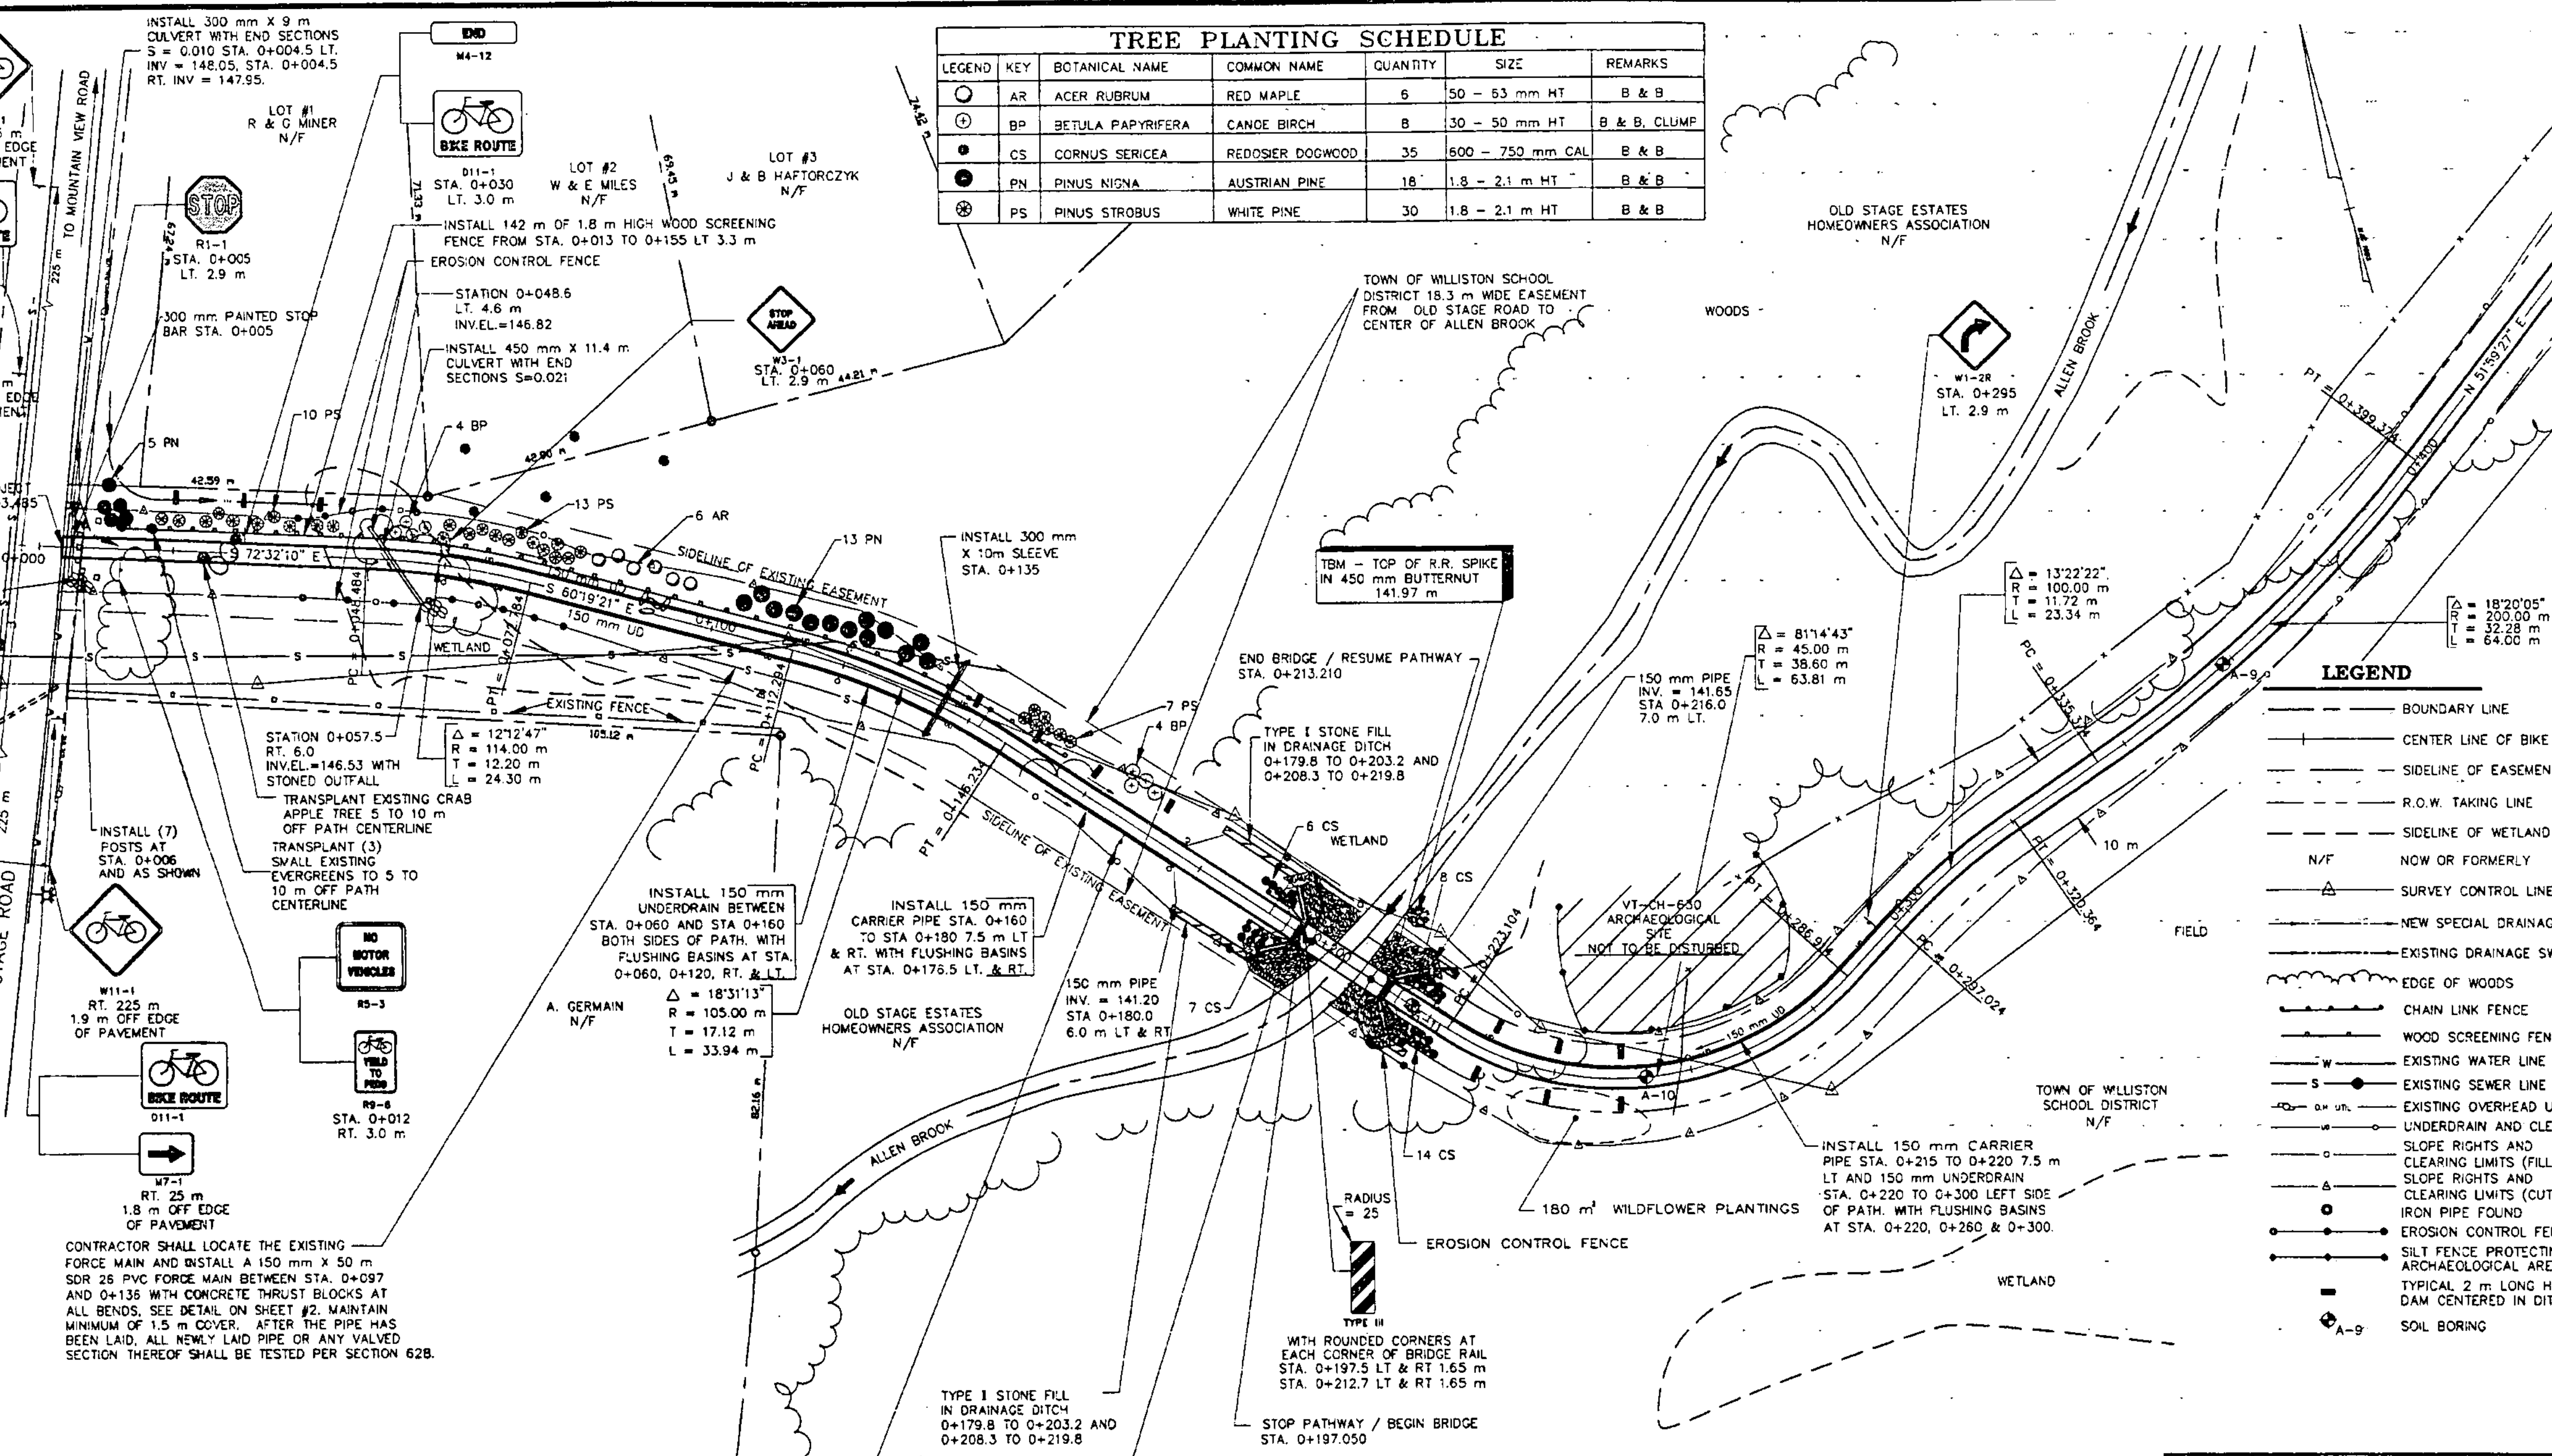


SOIL BORINGS

NUMBER	STATION	DEPTH	DESCRIPTION
A-9	0+358	0-0.5 0.5-0.8 0.8-1.0	D. BR. MOIST SANDY LOAM BR. MOIST MOTTLED SAND BR. WET MOTTLED SAND G.W. AT 0.8 m AT 1 MIN.
A-10	0+253	0-0.5 0.5-0.8 0.8-1.2	D. BR. MOIST SANDY LOAM BR. MOIST TO WET MOTTLED SANDY SILT BR. WET SANDY SILT WITH SMALL STONES G.W. AT 0.7 m AT 1 MIN.
A-11	0+217	0-0.5 0.5-1.2	D. BR. MOIST SANDY LOAM D. BR. WET MOTTLED SILTY SAND, REFUSAL AT 1.2 G.W. AT 0.7 m AT 1 MIN.

DATUM
 VERTICAL NAD 1983
 HORIZONTAL N/A

WETLAND NOTE:
 SEE WETLAND PLAN SHEET #22 FOR EROSION CONTROL SPECIFICATIONS AND DETAILS.

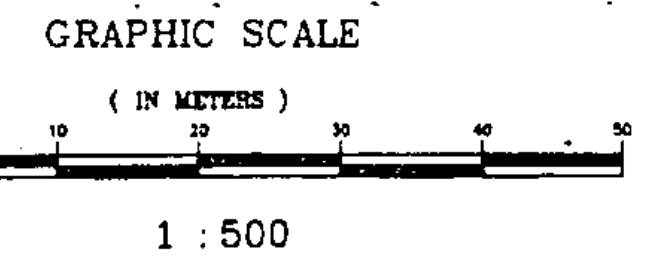

LEGEND

---	BOUNDARY LINE
---	CENTER LINE OF BIKE PATH
---	SIDELINE OF EASEMENT
---	R.O.W. TAKING LINE
---	SIDELINE OF WETLAND
N/F	NOW OR FORMERLY
---	SURVEY CONTROL LINE
---	NEW SPECIAL DRAINAGE SWALE
---	EXISTING DRAINAGE SWALE
---	EDGE OF WOODS
---	CHAIN LINK FENCE
---	WOOD SCREENING FENCE
---	EXISTING WATER LINE
---	EXISTING SEWER LINE & MANHOLE
---	EXISTING OVERHEAD UTILITY WIRES UNDERDRAIN AND CLEANOUT
---	SLOPE RIGHTS AND CLEARING LIMITS (FILL)
---	SLOPE RIGHTS AND CLEARING LIMITS (CUT)
---	IRON PIPE FOUND
---	EROSION CONTROL FENCE
---	SILT FENCE PROTECTING ARCHAEOLOGICAL AREA
---	TYPICAL 2 m LONG HAYBALE DAM CENTERED IN DITCH
A-9	SOIL BORING

8-3-95	REVISED PER STATE REVIEW	ABR	
5-2-95	REVISED PER STATE REVIEW	DLH	
9-8-94	REVISED PER STATE REVIEW	ABR	
6-30-94	REVISED PER STATE REVIEW	DLH	
1-25-94	REVISED PER STATE REVIEW	ABR	
date	desc.	REVISIONS	by
STATE OF VERMONT AGENCY OF TRANSPORTATION			
TRANSPORTATION PATH WILLISTON STP BIKE (0) IN WILLISTON VERMONT			
LAMOUREUX, STONE & O'LEARY Consulting Engineers Inc. 14 Morse Drive Essex Junction, VT 05452 (802) 878-4450 Engineers-Planners-Surveyors			
proj. no. 93-064	survey BFD/HLS	design LAL	scale 1:500
drawn PJE/BLH	checked DLH/LAL	date 12-01-93	sheet no. 8 OF 36

