


- LEGEND**
- BOUNDARY LINE
 - CENTER LINE OF BIKE PATH
 - SIDELINE OF WETLAND
 - R.O.W. TAKING LINE
 - N/F NOW OR FORMERLY
 - SURVEY CONTROL LINE
 - NEW SPECIAL DRAINAGE SWALE
 - EXISTING DRAINAGE SWALE
 - EDGE OF WOODS
 - ○ ○ ○ ○ NEW SCREENING TREES
 - CHAIN LINK FENCE
 - WOOD SCREENING FENCE
 - EXISTING SILT FENCE
 - EXISTING WATER LINE
 - EXISTING SEWER LINE & MANHOLE
 - SLOPE RIGHTS AND CLEARING LIMITS (CUT)
 - SLOPE RIGHTS AND CLEARING LIMITS (FILL)
 - IRON PIPE FOUND
 - EROSION CONTROL FENCE
 - TYPICAL 2 m LONG HAYBALE DAM CENTERED IN DITCH
 - SOIL BORING

TREE PLANTING SCHEDULE

LEGEND	KEY	BOTANICAL NAME	COMMON NAME	QUANTITY	SIZE	REMARKS
●	TO	THUJA OCCIDENTALIS	NORTHERN WHITE CEDAR	12	2 m HT	B & B

SOIL BORINGS

NUMBER	STATION	DEPTH	DESCRIPTION
A-7	0+663 E	0-0.6	IN BOTTOM OF DITCH. BR. WET MOTTLED SANDY SILT
A-8	0+609 E	0-0.3 0.3-0.6 0.6-0.9	D. BR. MOIST SANDY LOAM BR. MOIST MOTTLED SAND BR. WET SAND G.W. AT 0.8 AT 1 MINUTE

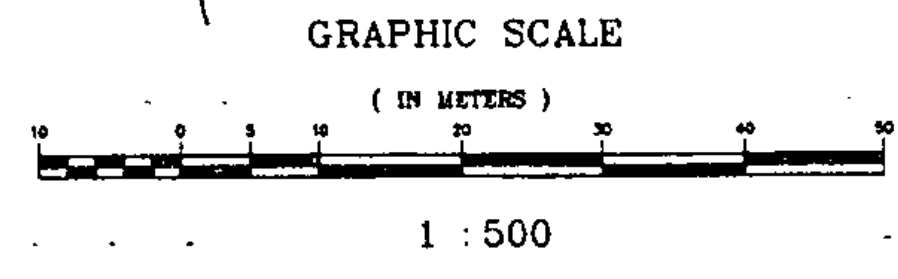

DATUM
VERTICAL NAD 1983
HORIZONTAL N/A

8-3-95	REVISED PER STATE REVIEW	DLH
5-2-95	REVISED PER STATE REVIEW	DLH
8-30-94	REVISED PER STATE REVIEW	DLH
date 1-25-94 desc.	REVISED PER STATE REVIEW	by ABR
REVISIONS		
STATE OF VERMONT AGENCY OF TRANSPORTATION		
TRANSPORTATION PATH WILLISTON STP BIKE (9) IN WILLISTON VERMONT		
Proj. no. 93-064 Survey BFB/HLS Design LAL Drawn PJE/DLH Checked DLH/LAL Date 12-01-93 Scale 1:500 Sht. no. 9 OF 36		
LAMOUREUX, STONE & O'LEARY Consulting Engineers Inc. 14 Morse Drive Essex Junction, VT 05452 (802) 878-4450 Engineers-Planners-Surveyors		