


MAIN LINE PROFILE STA. 0+000 TO STA. 1+000

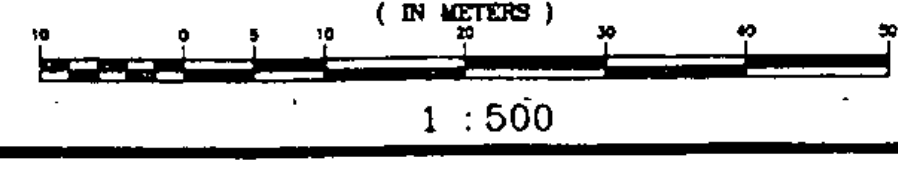

5-2-95	REVISED PER STATE REVIEW	DLH
6-30-94	REVISED PER STATE REVIEW	DLH
date 1-25-94	REVISED PER STATE REVIEW	by ABR
REVISIONS		
STATE OF VERMONT AGENCY OF TRANSPORTATION		proj. no. 93-054
TRANSPORTATION PATH WILLISTON STP BIKE (9)		survey HLS/BFD
IN WILLISTON VERMONT		design LAL
LAMOUREUX, STONE & O'LEARY Consulting Engineers Inc.		prep'd PJE/DLH
14 Morse Drive Essex Junction, VT 05452 (802) 878-4450		checked DLH/LAL
Engineers-Planners-Surveyors		date 12-1-93
		scale 1:500 HOR. 1:100 VERT.
		sheet no. 12 OF 36