


**LEGEND**

— SLOPE RIGHTS AND CLEARING LIMITS  
 - - - - - EXISTING GROUND

**GRAPHIC SCALE**

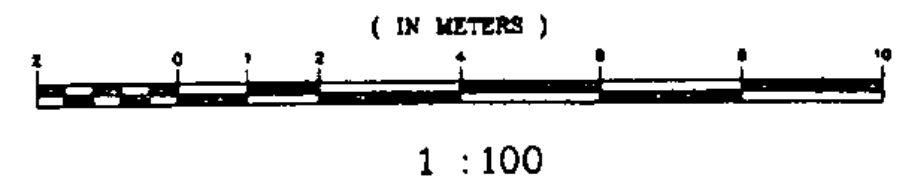

**LAMOUREUX, STONE & O'LEARY**  
 Consulting Engineers Inc.  
 14 Morse Drive  
 Essex Junction, VT 05452  
 (802) 878-4450  
 Engineers-Planners-Surveyors



**WILLISTON BIKE PATH**  
 JOB #: 93-064 STP BIKE (9)  
 DRAWING #:  
 16 OF 36