
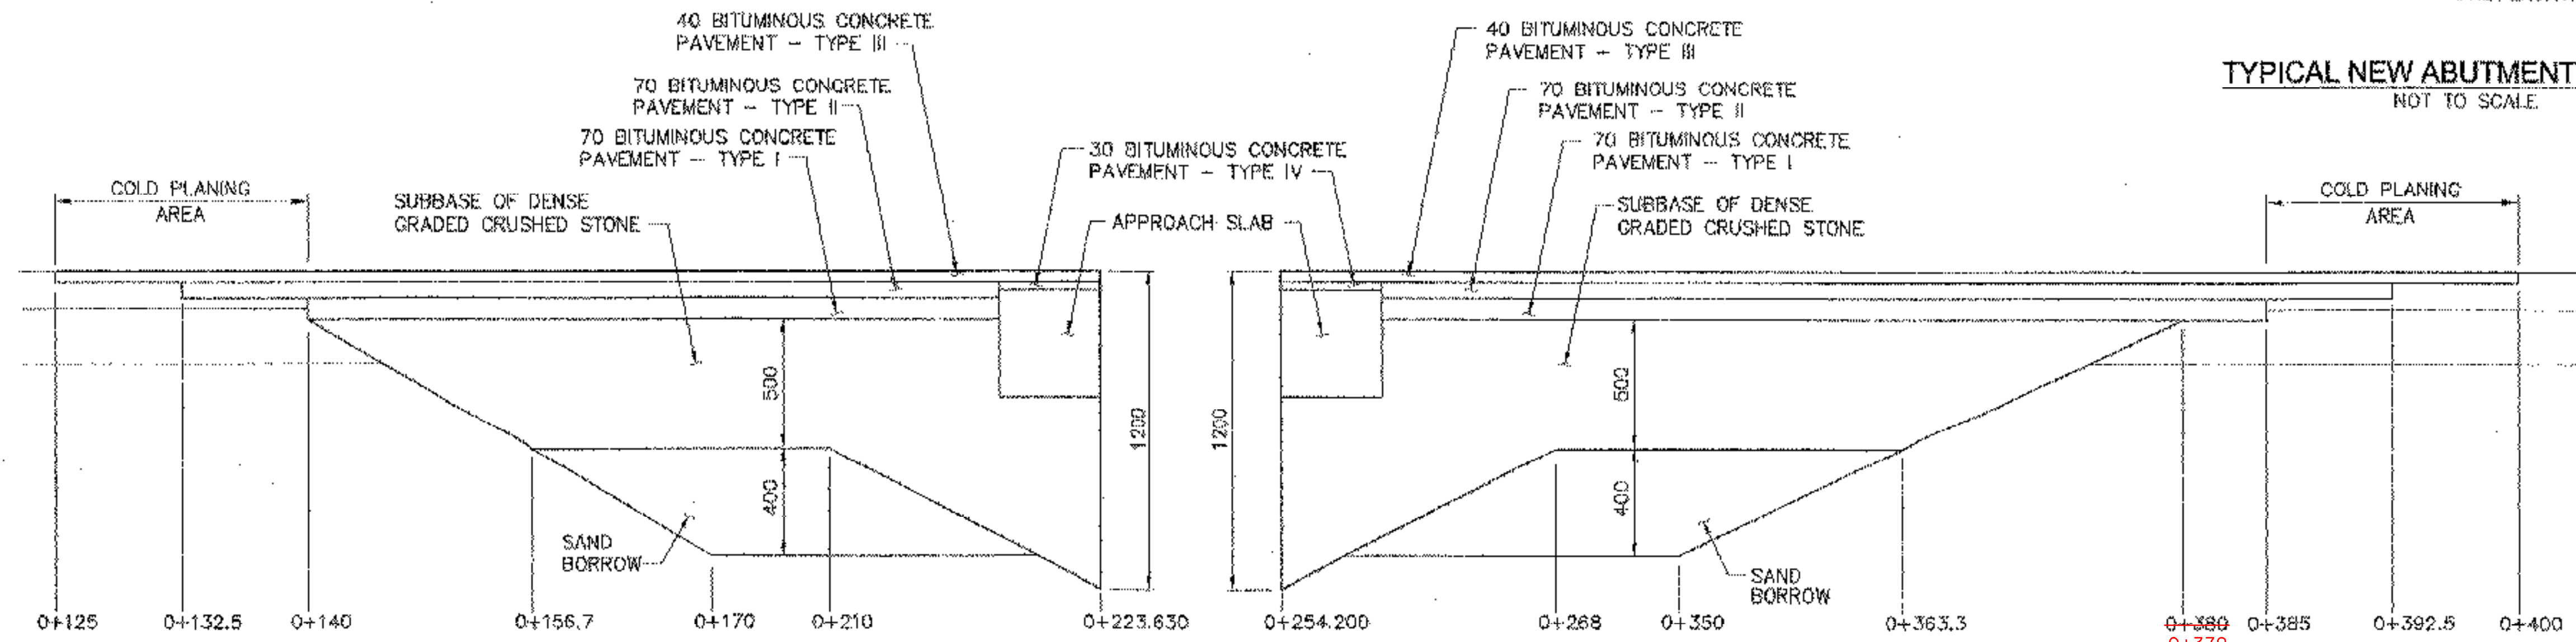
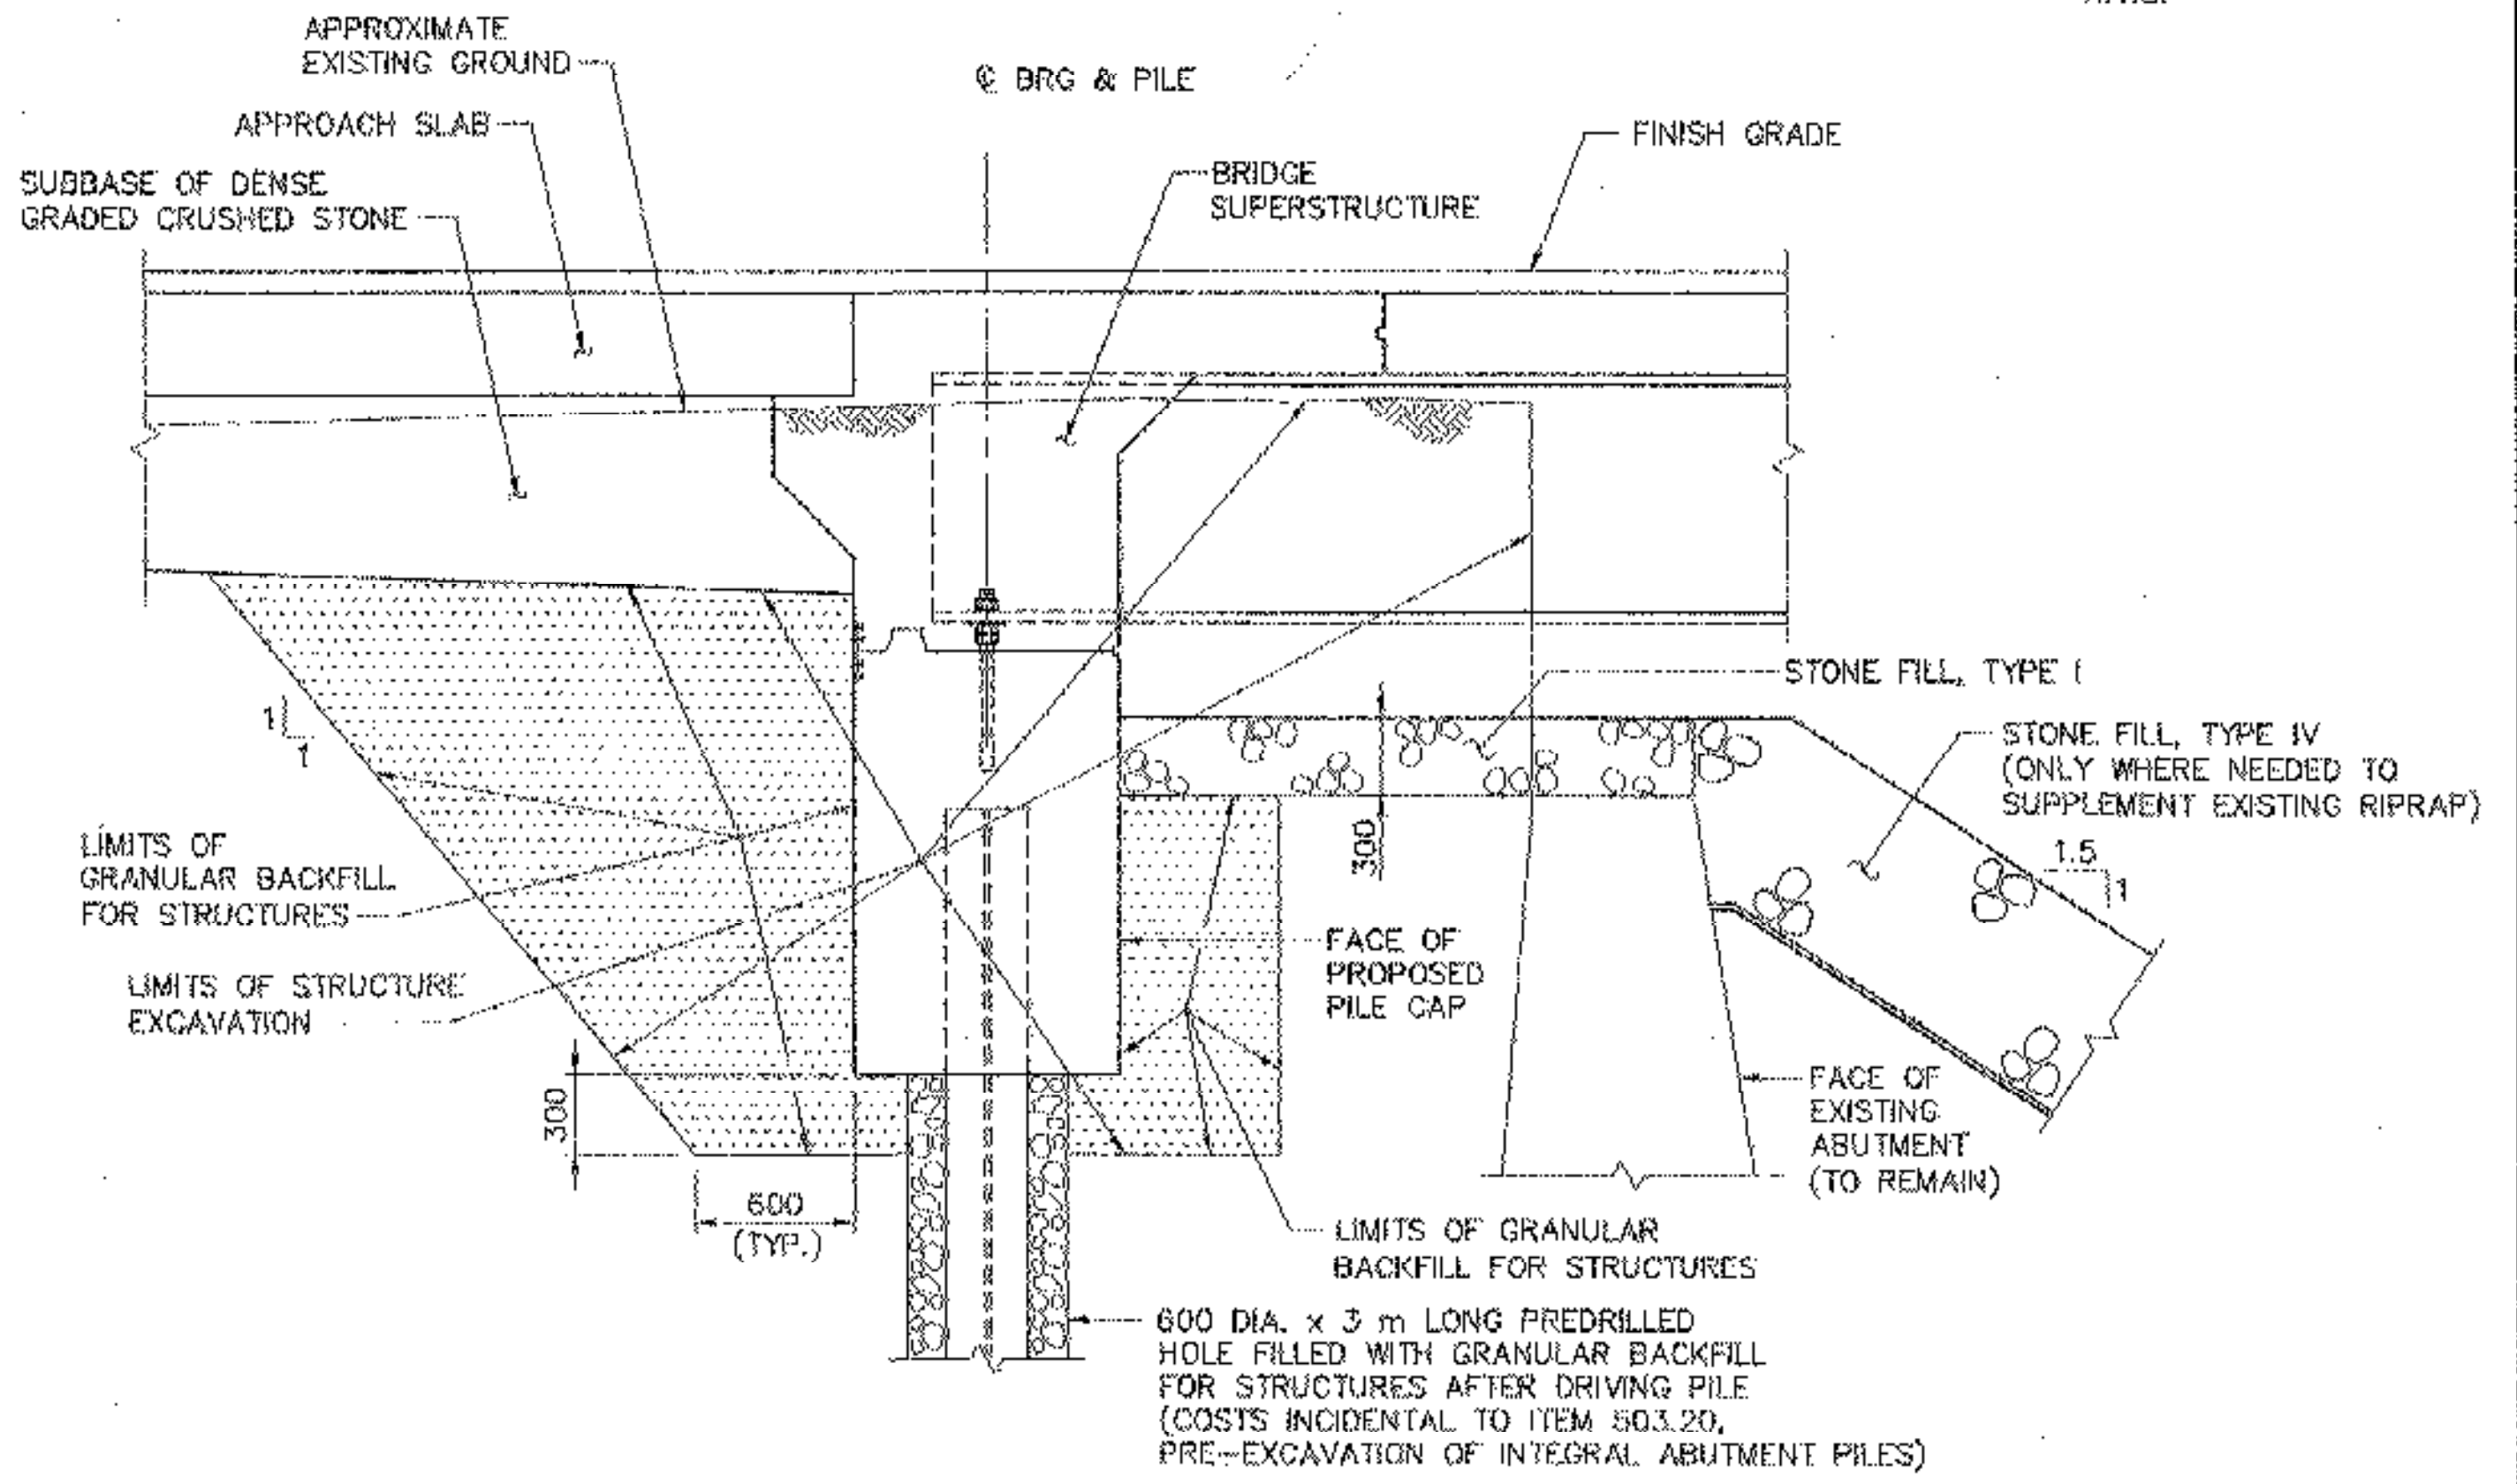


* GRUBBING MATERIAL SHALL NOT BE PLACED ON THE STONE FILL IN THE AREA UNDER THE BRIDGE. WHENEVER CHANNEL SLOPE INTERSECTS ROADWAY SUBBASE, GRUBBING MATERIAL SHALL BEGIN AT THE BOTTOM OF SUBBASE.

RETAIN EXISTING HEAVY RIPRAP. SUPPLEMENT WITH STONE FILL, TYPE IV OUTSIDE THE LIMITS OF RIPRAP TO Q100 ELEVATION AT WINGWALLS

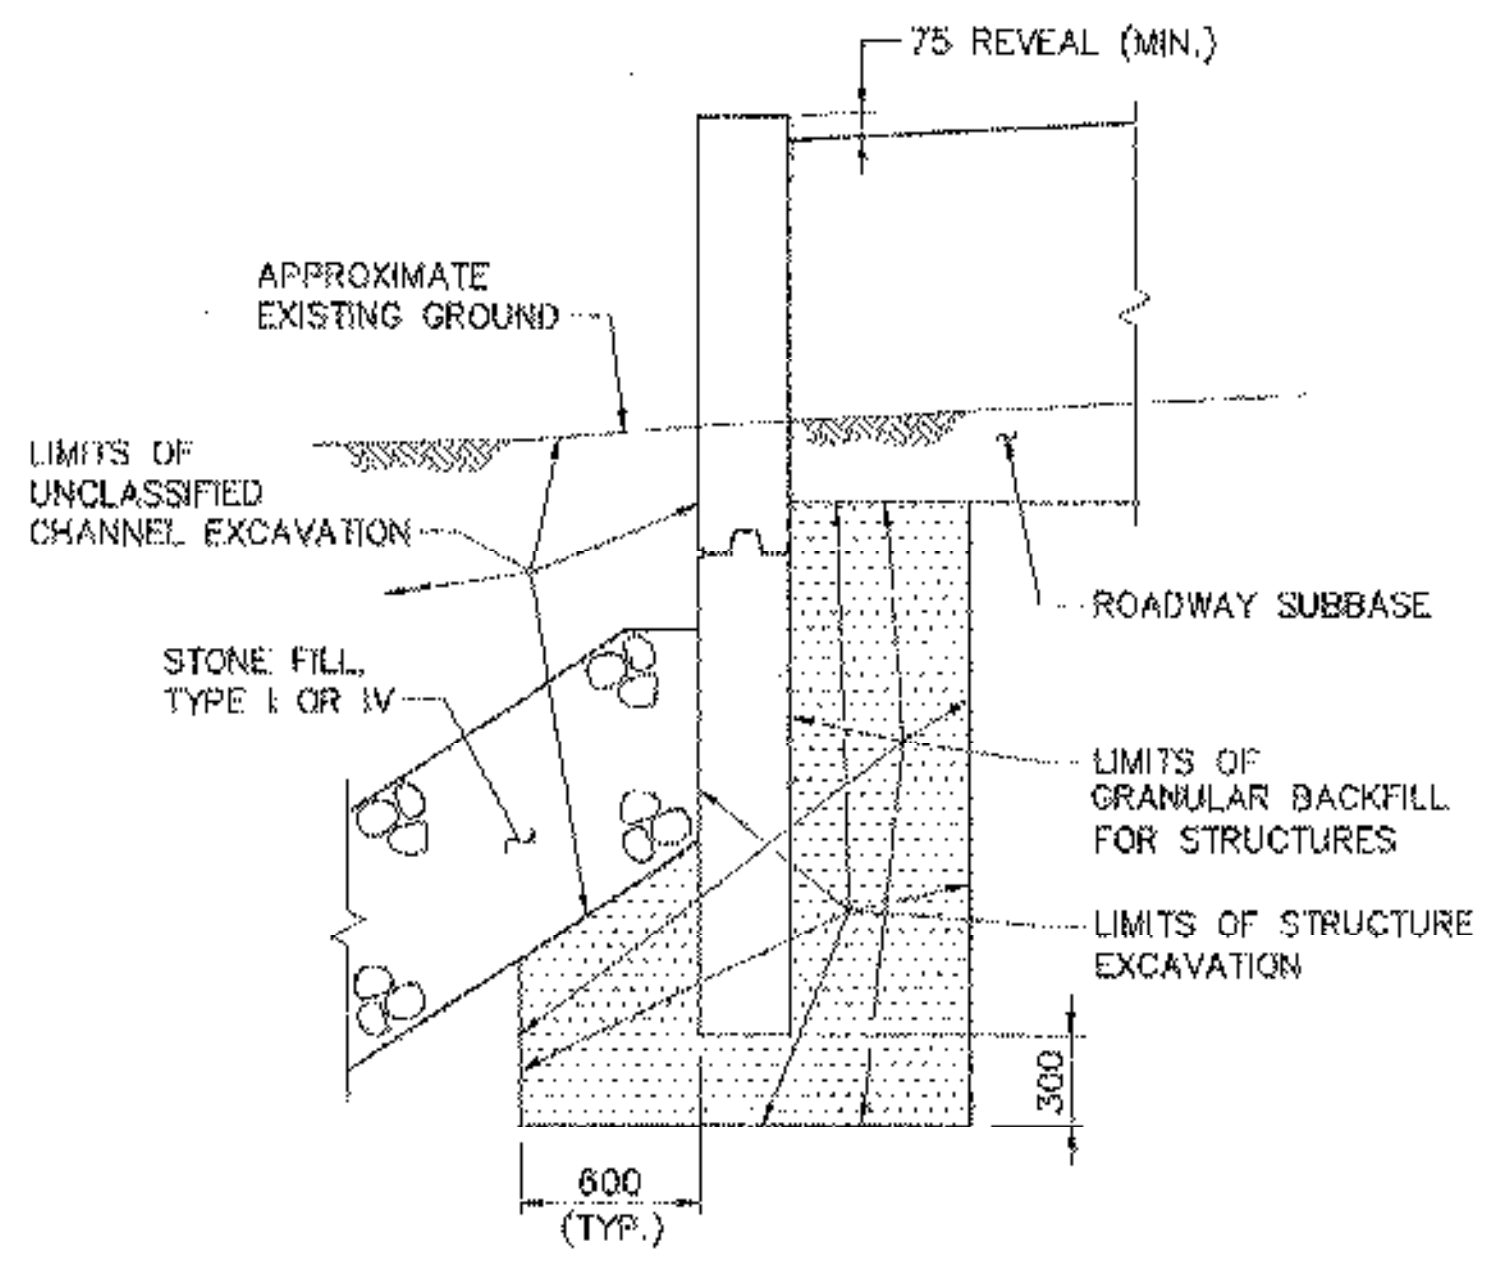

DATUM	
VERTICAL	NAVD 88
HORIZONTAL	NAD 83-92

STATE OF VERMONT AGENCY OF TRANSPORTATION	
Town Of LYNDON	Bridge No. 2
Highway No. VT 114	Log Sta.
VT 114 OVER PASSUMPSIC RIVER	
TIE SHEET AND TYPICAL DETAILS	
Designed By EIV/S.M. GUNN	Drawn By B.J. MASSE
Checked By S.M.G./M.A.C.	Bridge Design Supervisor M.A. COLGAN Date 3/06
PROJECT LYNDON	PROJECT NO. BRP 0269(10)
I.G.C. Info.	Bridge Sheet No. 505447E
	Sheet 11 of 72