


BANKING DIAGRAM
($e_{max} = 0.08, 60 \text{ km/hr}$)

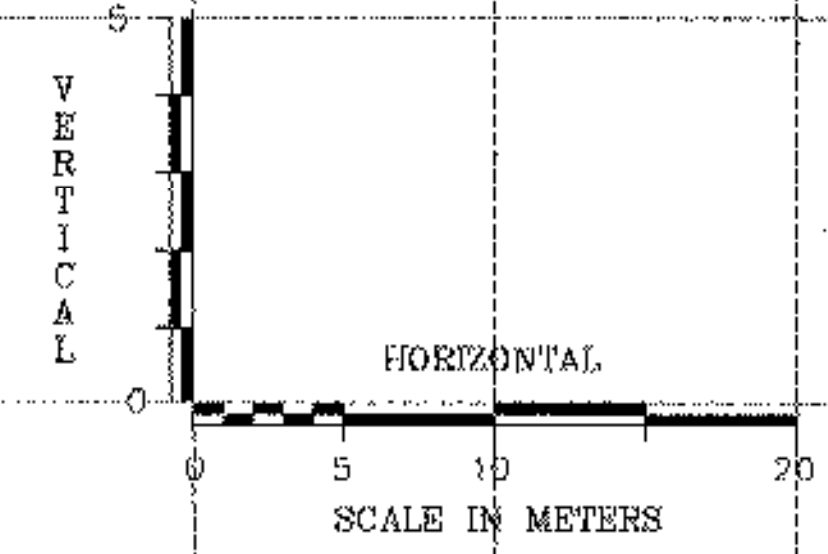

VERTICAL CURVES REVISED 12/06 BY RRW

**STATE OF VERMONT
AGENCY OF TRANSPORTATION**

Town Of	LYNDON	Bridge No.	2
Highway No.	VT 114	Log Sta.	
		Surv. Sta.	
VT 114 OVER PASSUMPSIC RIVER			
VT 114 PROFILE AND BANKING DIAGRAM			
Designed By	S.M. GUNN	Drawn By	B.J. MASSE
Checked By	S.M. GUNN	Date	3/06
		Bridge Design Supervisor	M.A. COLGAN
		Date	3/06
PROJECT	LYNDON	PROJECT NO.	BRF 0269(10)