



T.H. 5 PROFILE (DARLING HILL RD.)

WATER STREET PROFILE

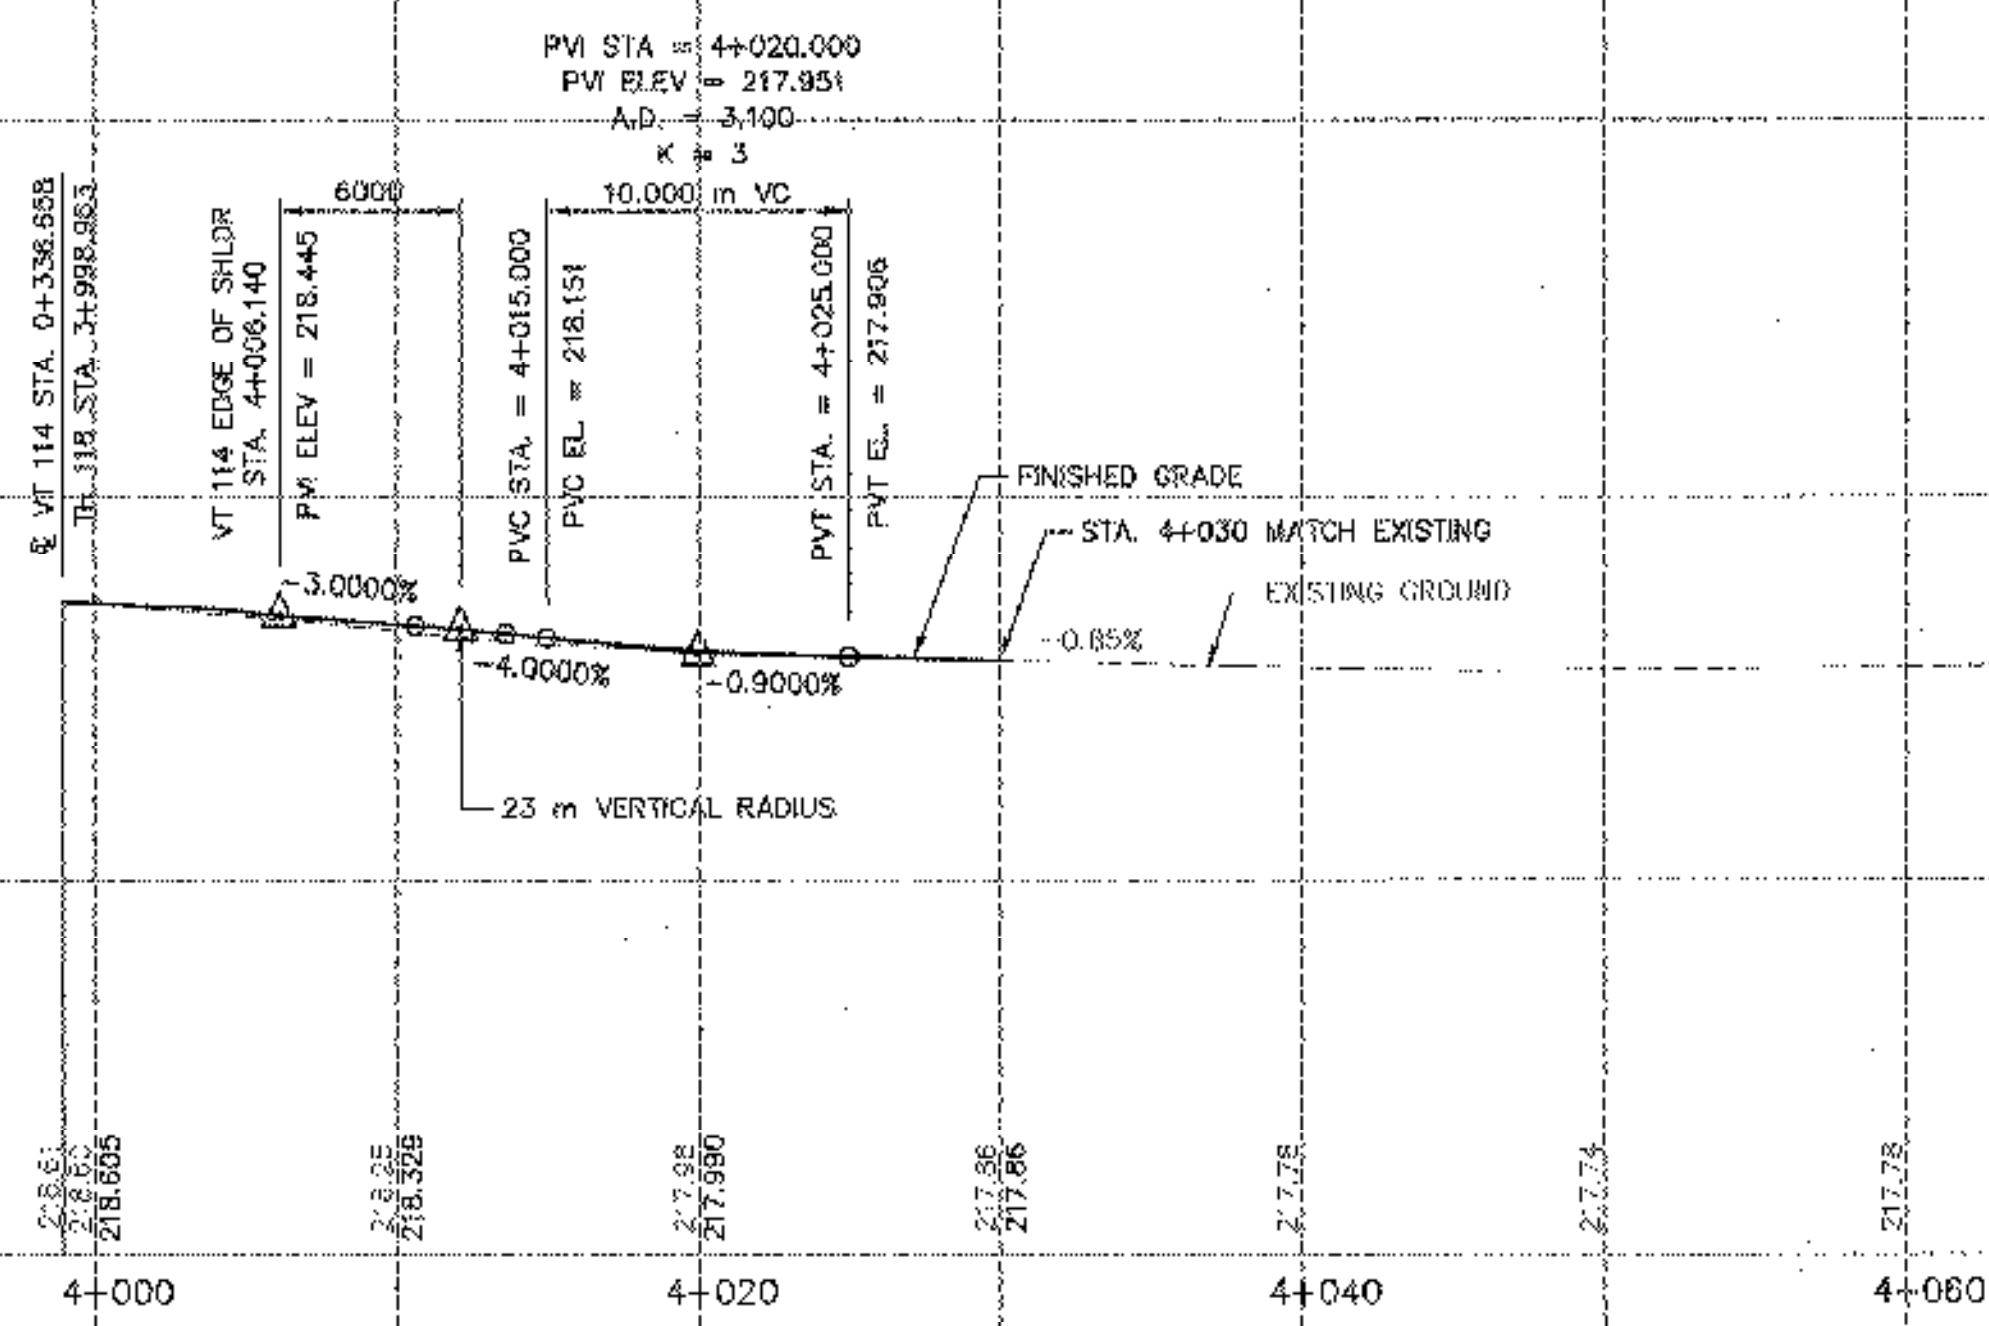

T.H. 118 PROFILE

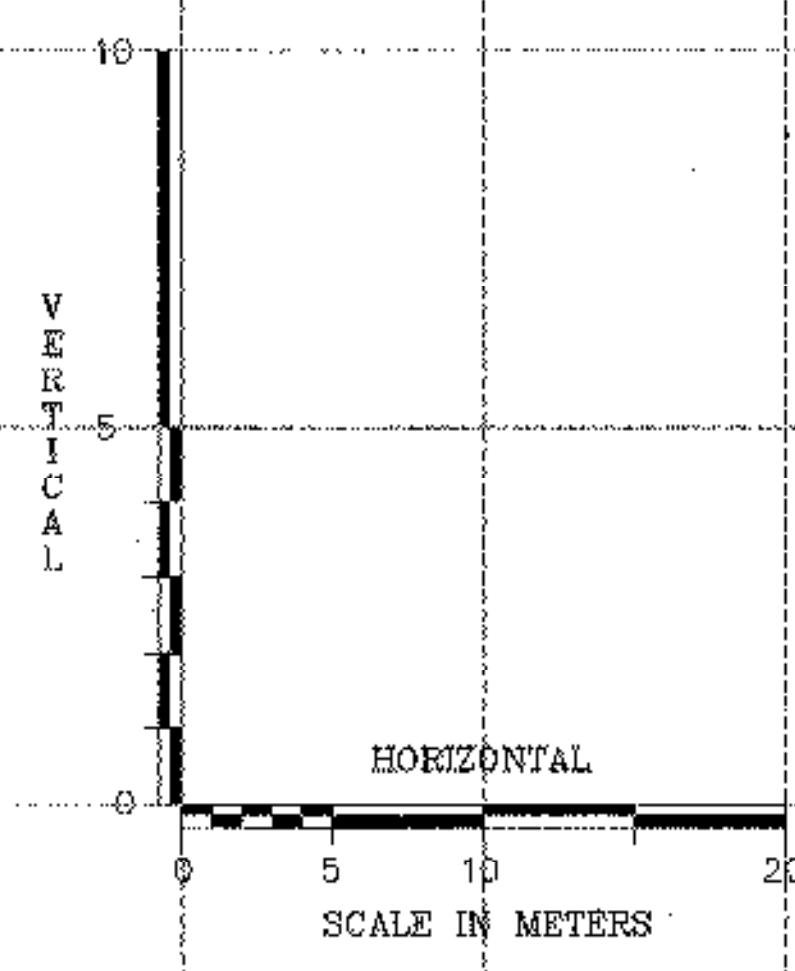

VERTICAL CURVES REVISED 12/06 BY RRW

STATE OF VERMONT AGENCY OF TRANSPORTATION

| | | | |
|------------------------------|-----------|--------------------------|--------------|
| Town Of | LYNDON | Bridge No. | 2 |
| Highway No. | VT 114 | Log Sta. | |
| | | Surv. Sta. | |
| VT 114 OVER PASSUMPSIC RIVER | | | |
| TOWN HIGHWAY PROFILES | | | |
| Designed By | S.M. GUNN | Drawn By | B.J. MASSE |
| Checked By | Date | Bridge Design Supervisor | |
| S.M. GUNN | 3/06 | M.A. COLGAN | Date 3/06 |
| PROJECT | LYNDON | PROJECT NO. | BRF 0269(10) |