


**PLAN**  
SCALE: 1:100

**NOTE:**  
1. RETAIN EXISTING HEAVY RIPRAP. SUPPLEMENT WITH STONE FILL, TYPE IV OUTSIDE THE LIMITS OF RIPRAP TO Q100 ELEVATION AT WINGWALLS. SEE TYPICAL CHANNEL SECTION ON SHEET 11 FOR PLACEMENT OF NEW STONE FILL.

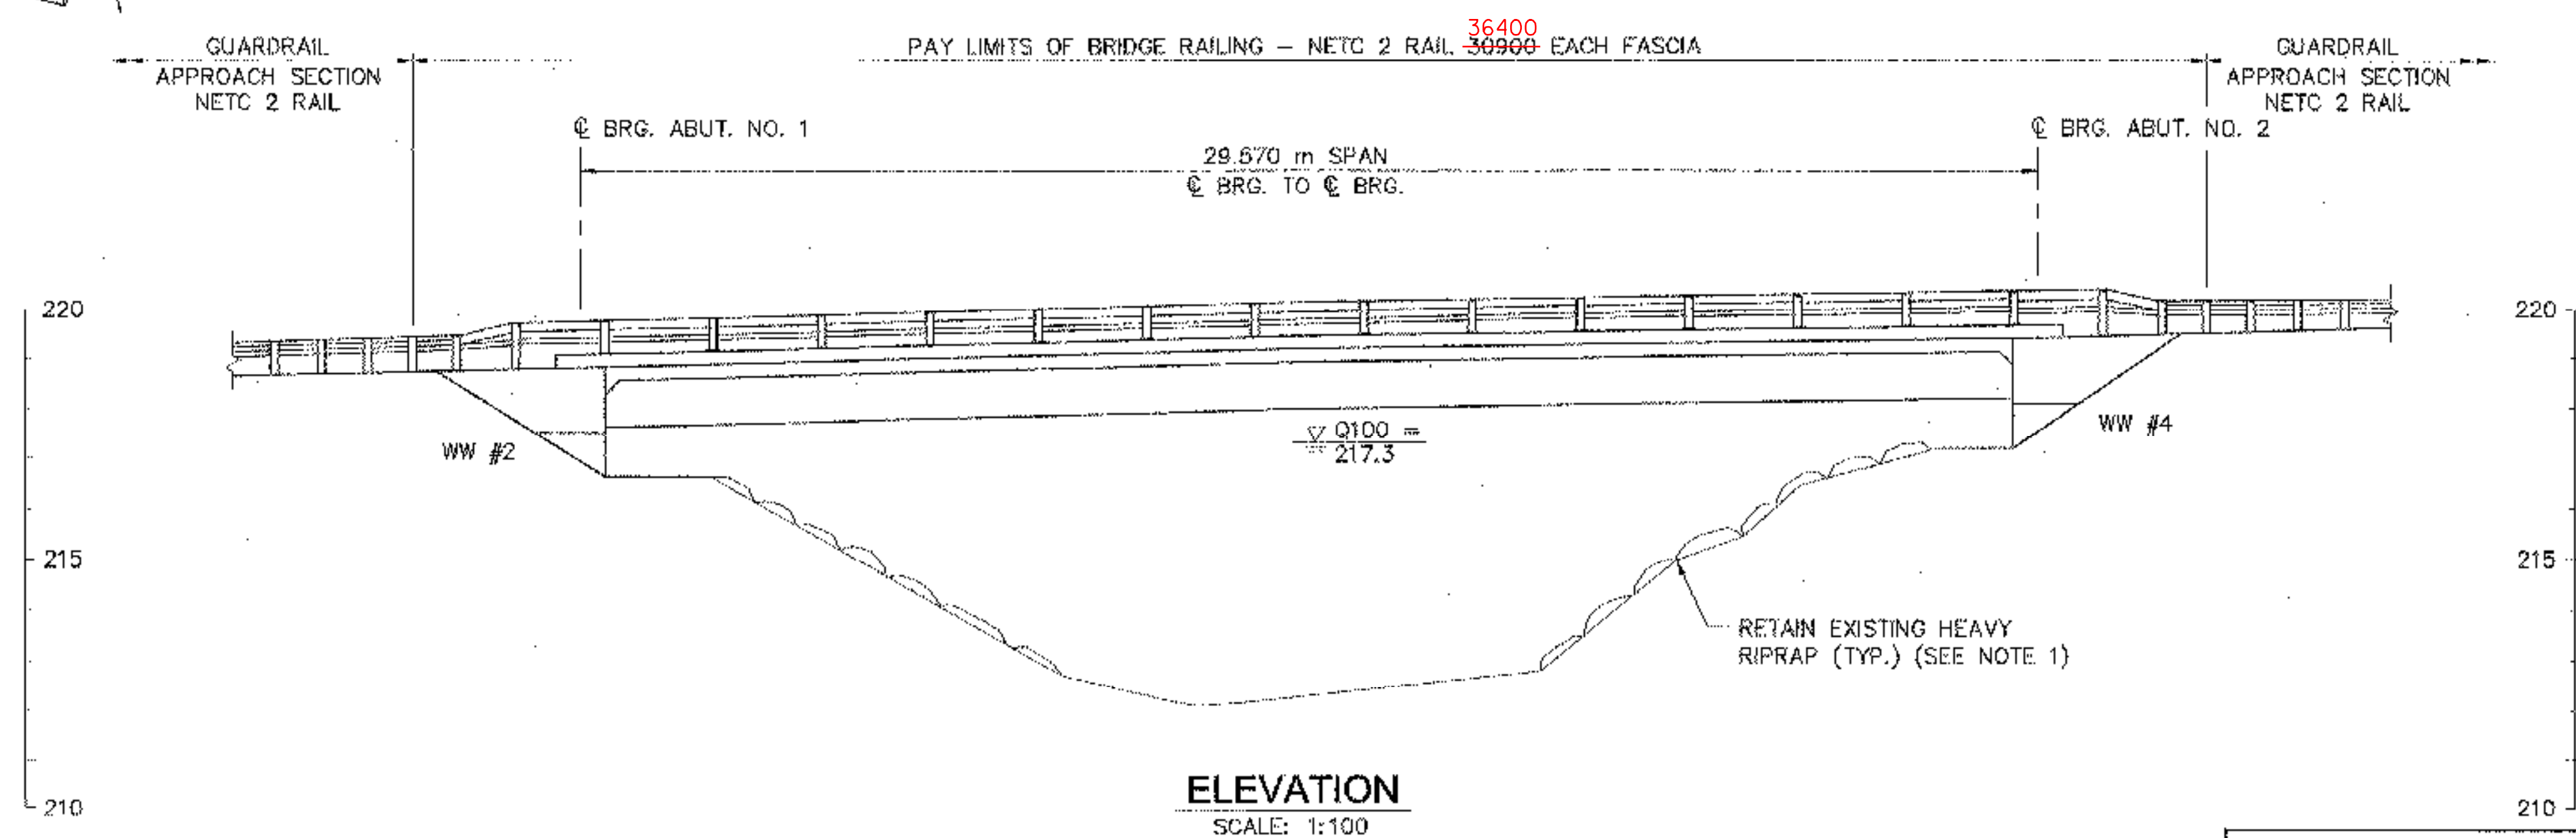

**ELEVATION**  
SCALE: 1:100



**VERTICAL CURVES REVISED 12/06 BY RRW**

<b>STATE OF VERMONT AGENCY OF TRANSPORTATION</b>	
Town Of LYNDON	Bridge No. 2
Highway No. VT 114	Log Sta.
VT 114 OVER PASSUMPSIC RIVER	
<b>PLAN AND ELEVATION</b>	
Designed By J.T. KLEIN	Drawn By B.J. MASSE
Checked By L.S. GARDNER	Bridge Design Supervisor M.A. COLGAN
Date 3/06	Date 3/06
PROJECT LYNDON	PROJECT NO. BRF 0269(10)
I.G.C. Info.	Bridge Sheet No. 50544ELV
Sheet 24 of 72 (REVISED)	